



214+50.00

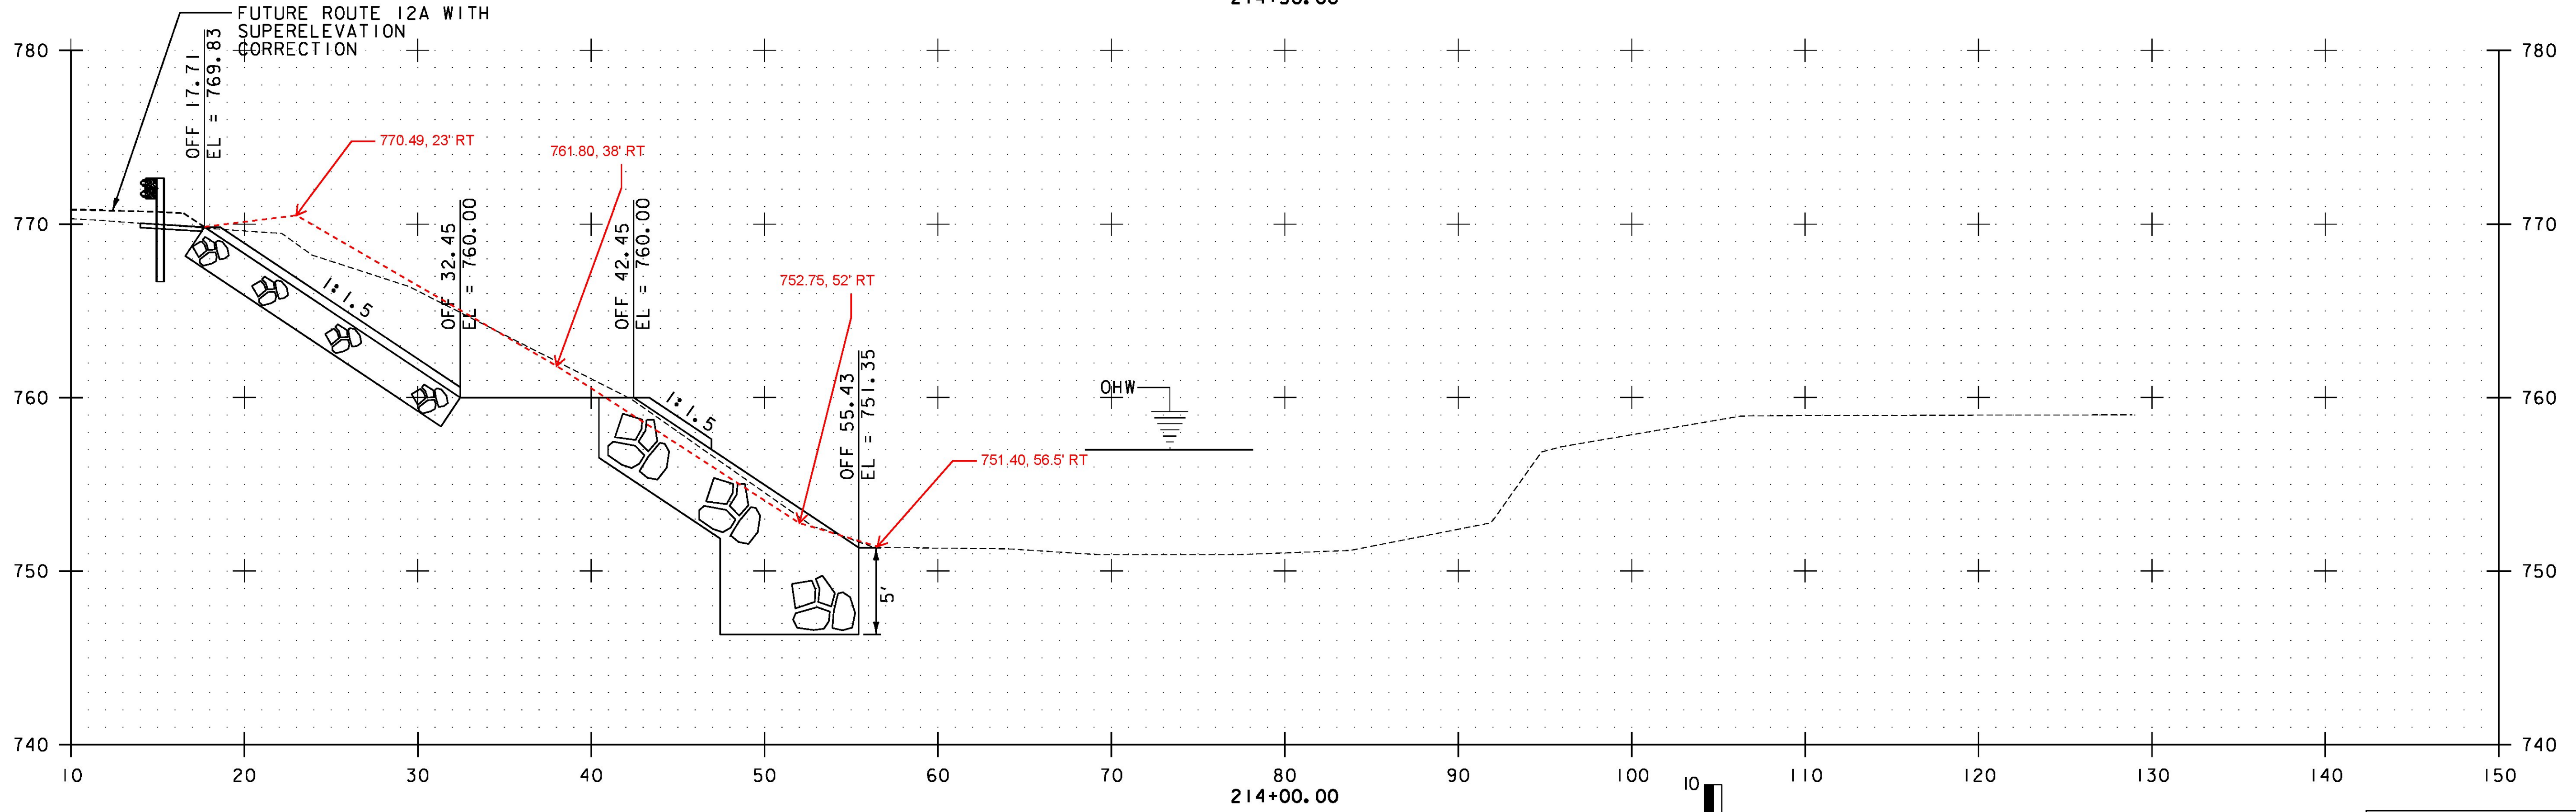

214+00.00

STA. 214+00.00 TO STA. 214+50.00

NOTE: REFER TO SHEET 4 FOR MATERIAL TYPES

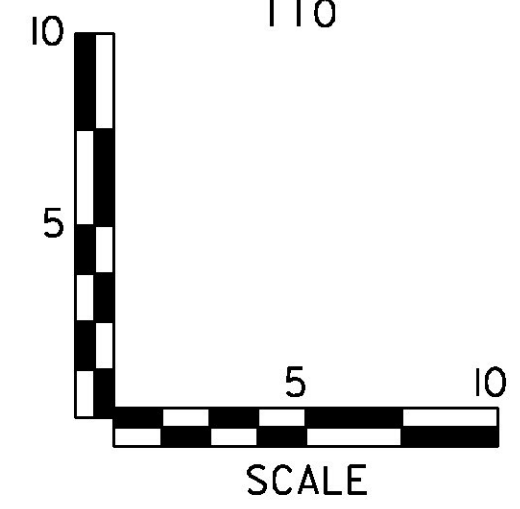

PROJECT NAME:	BRAINTREE
PROJECT NUMBER:	ER STP 0187(12)
FILE NAME:	z12c526xs.dgn
PROJECT LEADER:	G. EDWARDS
DESIGNED BY:	I. MAYNARD
<b>ROUTE 12A SECTIONS SHEET 9</b>	
PLOT DATE:	1/10/2014
DRAWN BY:	G. BURGMEIER
CHECKED BY:	M. FOISY
SHEET	47 OF 72