


STA. 9+40.00 TO STA. 9+50.00

PROJECT NAME:	BRAINTREE	PLOT DATE:	1/10/2014
PROJECT NUMBER:	ER STP 0187(12)	DRAWN BY:	G. BURGMEIER
FILE NAME:	z12c526xs.dgn	DESIGNED BY:	I. MAYNARD
PROJECT LEADER:	G. EDWARDS	CHECKED BY:	M. FOISY
THIRD BRANCH SECTIONS SHEET 1		SHEET	51 OF 72

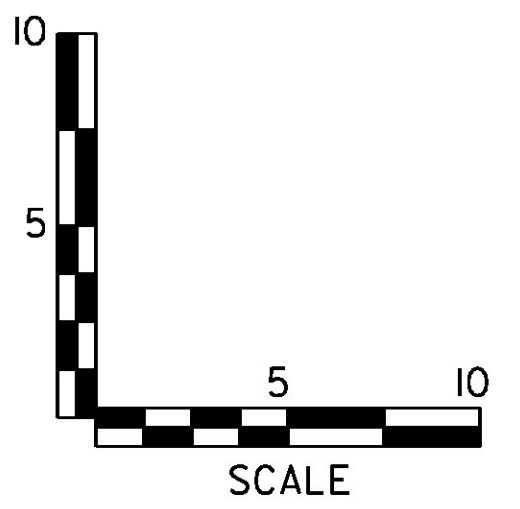

NOTE: REFER TO SHEET 4 FOR MATERIAL TYPES