


STA. 10+00.00 TO STA. 10+50.00

PROJECT NAME:	BRAINTREE
PROJECT NUMBER:	ER STP 0187(12)
FILE NAME:	z12c526xs.dgn
PROJECT LEADER:	G. EDWARDS
DESIGNED BY:	I. MAYNARD
THIRD BRANCH SECTIONS SHEET 2	
PLOT DATE:	1/10/2014
DRAWN BY:	G. BURGMEIER
CHECKED BY:	M. FOISY
SHEET	52 OF 72

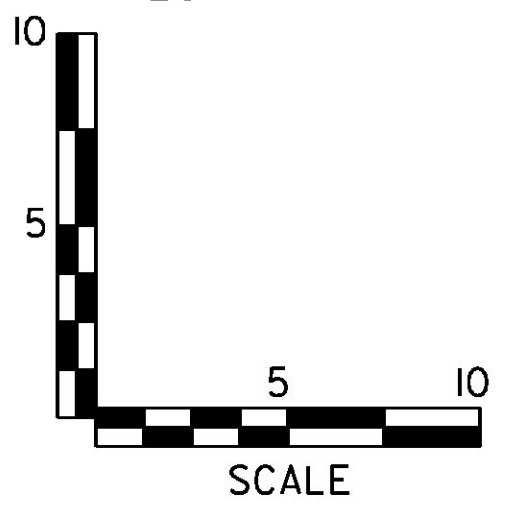

NOTE: REFER TO SHEET 4 FOR MATERIAL TYPES