


STA. 12+00.00 TO STA. 12+50.00

PROJECT NAME:	BRAINTREE	PLOT DATE:	1/10/2014
PROJECT NUMBER:	ER STP 0187(12)	DRAWN BY:	G. BURGMEIER
FILE NAME:	z12c526xs.dgn	DESIGNED BY:	I. MAYNARD
PROJECT LEADER:	G. EDWARDS	CHECKED BY:	M. FOISY
THIRD BRANCH SECTIONS SHEET 4		SHEET 54 OF 72	

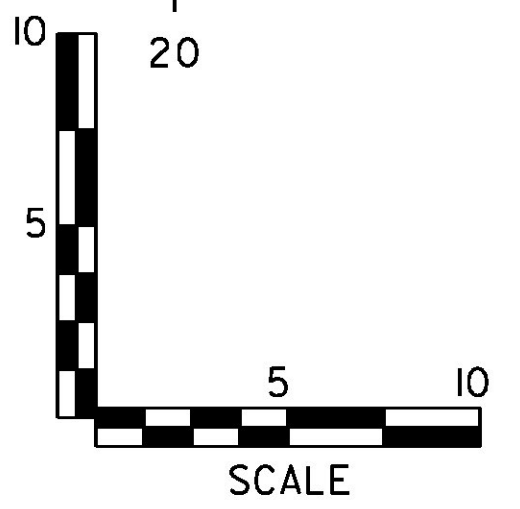

NOTE: REFER TO SHEET 4 FOR MATERIAL TYPES