


12+75.00
FOR SLOPE STABILIZATION BETWEEN 12+75 AND 24+00
SEE ROUTE 12A CROSS SECTIONS

STA. 12+75.00 AND STA. 24+00.00

NOTE: REFER TO SHEET 4 FOR MATERIAL TYPES

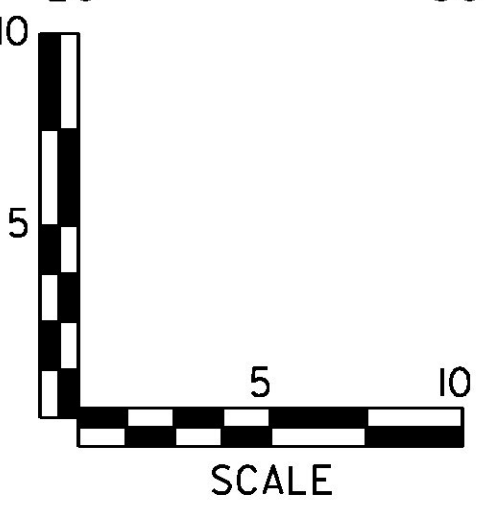

PROJECT NAME:	BRAINTREE	PLOT DATE:	1/27/2014
PROJECT NUMBER:	ER STP 0187(12)	DRAWN BY:	G. BURGMEIER
FILE NAME:	z12c526xs.dgn	DESIGNED BY:	I. MAYNARD
PROJECT LEADER:	G. EDWARDS	CHECKED BY:	M. FOISY
THIRD BRANCH SECTIONS SHEET 5		SHEET 55 OF 72	