


STA. 24+50.00 TO STA. 24+90.00

PROJECT NAME: BRAINTREE	
PROJECT NUMBER: ER STP 0187(I2)	
FILE NAME: z12c526xs.dgn	PLOT DATE: 1/10/2014
PROJECT LEADER: G. EDWARDS	DRAWN BY: G. BURGMEIER
DESIGNED BY: I. MAYNARD	CHECKED BY: M. FOISY
THIRD BRANCH SECTIONS SHEET 6	SHEET 56 OF 72

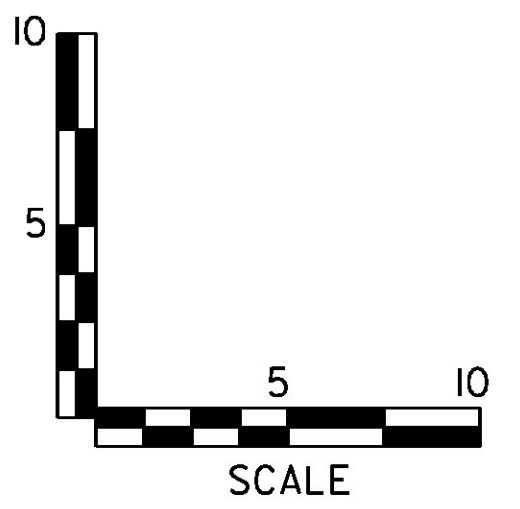

NOTE: REFER TO SHEET 4 FOR MATERIAL TYPES