


STA. 1+25.00 TO STA. 2+00.00

PROJECT NAME:	BRAINTREE	FILE NAME:	z12c526xs.dgn	PLOT DATE:	1/10/2014
PROJECT NUMBER:	ER STP 0187(12)	PROJECT LEADER:	G. EDWARDS	DRAWN BY:	G. BURGMEIER
		DESIGNED BY:	I. MAYNARD	CHECKED BY:	M. FOISY
		<b>CAHEE BROOK SECTIONS SHEET 1</b>		SHEET	57 OF 72

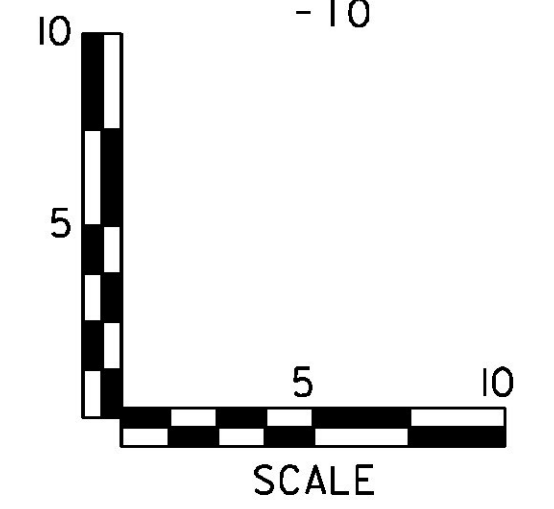

NOTE: REFER TO SHEET 4 FOR MATERIAL TYPES