


**LEGEND**

	= RIPRAP, HEAVY TYPE
	= STONE FILL TYPE II WITH GRUBBING MATERIAL
	= SPECIAL PROVISION (STONE FILL, STREAM BED MATERIAL)
	= FILTER CURTAIN
	= BARRIER FENCE
	= CUT LIMIT
	= FILL LIMIT
	= ORDINARY HIGH WATER

**IMPACT SUMMARY SHEET 1**

	RESTORATION BELOW OHW: 6240 SF
	PERMANENT IMPACTS BELOW OHW: 470 SF

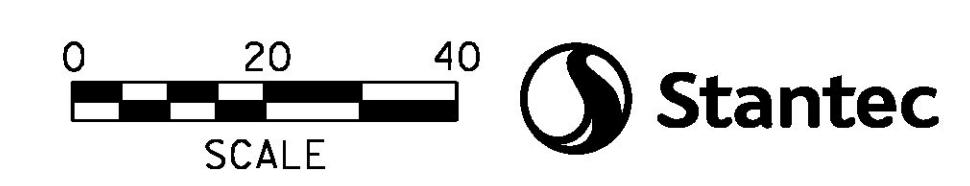

PROJECT NAME: BRAINTREE	PLOT DATE: 1/10/2014
PROJECT NUMBER: ER STP 0187(12)	DRAWN BY: G. BURGMEIER
FILE NAME: z12c5261mpBdr.dgn	CHECKED BY: M. FOISY
DESIGNED BY: I. MAYNARD	SHEET 58 OF 72
<b>IMPACT SHEET 1</b>	