


LEGEND

	= RIPRAP, HEAVY TYPE
	= STONE FILL TYPE II WITH GRUBBING MATERIAL
	= SPECIAL PROVISION (STONE FILL, STREAM BED MATERIAL)
	= FILTER CURTAIN
	= BARRIER FENCE
	= CUT LIMIT
	= FILL LIMIT
	= ORDINARY HIGH WATER

IMPACT SUMMARY SHEET 1

	RESTORATION BELOW OHW: 5880 SF
	PERMANENT IMPACTS BELOW OHW: 1470 SF

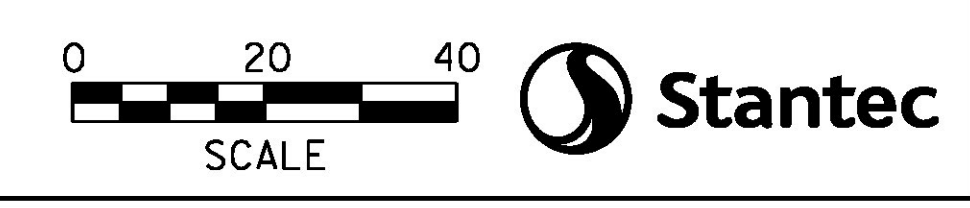

PROJECT NAME: BRAINTREE	
PROJECT NUMBER: ER STP 0187(12)	
FILE NAME: z12c5261mpBdr.dgn	PLOT DATE: 1/10/2014
PROJECT LEADER: G. EDWARDS	DRAWN BY: G. BURGMIEER
DESIGNED BY: I. MAYNARD	CHECKED BY: M. FOISY
IMPACT SHEET 2	SHEET 59 OF 72