


NOTES:
 1. SEE SHEET 10 FOR EPSC LAYOUT PLAN SYMBOLGY.
 2. RE-VEGETATION ON TOP OF STONE FILL SHALL BE GRUBBING MATERIAL, SEED AND MULCH. ALL OTHER AREAS TO BE TOPSOIL, SEED AND MULCH.

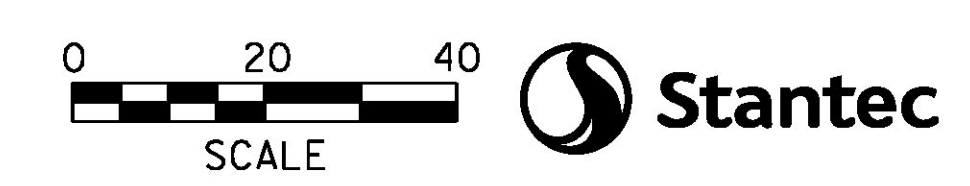

PROJECT NAME:	BRAINTREE	PLOT DATE:	1/10/2014
PROJECT NUMBER:	ER STP 0187(12)	DRAWN BY:	I. MAYNARD
FILE NAME:	z12c526eroBdr.dgn	CHECKED BY:	M. FOISY
DESIGNED BY:	I. MAYNARD	SHEET	69 OF 72
EPSC FINAL LAYOUT SHEET 2			