
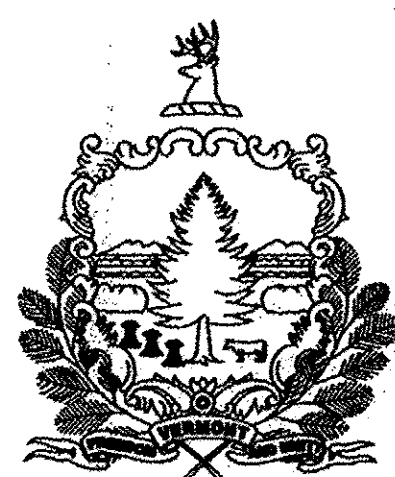


| RECORD PLANS                                                                                                                                                       |                                                                                                     |
|--------------------------------------------------------------------------------------------------------------------------------------------------------------------|-----------------------------------------------------------------------------------------------------|
| CONTRACTOR:                                                                                                                                                        | F. R. LAFAYETTE, INC. - ESSEX JUNCTION, VT                                                          |
| RESIDENT ENGINEER:                                                                                                                                                 | TIM POCKETTE                                                                                        |
| CONSTRUCTION BEGAN:                                                                                                                                                | APRIL 27, 2015                                                                                      |
| CONSTRUCTION COMPLETE:                                                                                                                                             | MAY 29, 2015                                                                                        |
| RECORD PLANS BY:                                                                                                                                                   | TIM POCKETTE & AARON JAMES                                                                          |
| I HEREBY CERTIFY THAT ALL THE CONSTRUCTION REQUIRED BY THIS SET OF DRAWINGS HAS BEEN ACCOMPLISHED AS INDICATED HEREIN.                                             |                                                                                                     |
| BY                                                                                                                                                                 |  RESIDENT ENGINEER |
| DATE                                                                                                                                                               | 06-30-16                                                                                            |
| NOTE: Any further information concerning final quantities, amounts or other details relative to this project may be found by contacting Vtrans Records Management. |                                                                                                     |

# STATE OF VERMONT AGENCY OF TRANSPORTATION




## PROPOSED IMPROVEMENT TOWNS OF ADDISON, BRIDPORT, CORNWALL, SHOREHAM, ORWELL, AND SUDBURY COUNTIES OF ADDISON AND RUTLAND VT 73, VT 74, AND VT 125 (MAJOR COLLECTORS)


STATEWIDE SOUTHWEST SIGN REPLACEMENT - 32.852 MILES:  
ADDISON (VT-125) MP 0.000-1.854, BRIDPORT (VT-125) MP 0.000-8.189  
CORNWALL (VT-125) MP 0.000-4.265, SHOREHAM (VT-74) MP 0.000-10.364  
ORWELL (VT-73) MP 0.000-4.986, SUDBURY (VT-73) MP 0.000-3.194

LENGTH OF ROADWAY = 32.852 MI  
LENGTH OF PROJECT = 32.852 MI

WORK TO BE PERFORMED INCLUDES THE REMOVAL OF EXISTING SIGNS AND POSTS  
AND THE INSTALLATION OF NEW SIGNS AND POSTS AND OTHER RELATED HIGHWAY ITEMS.

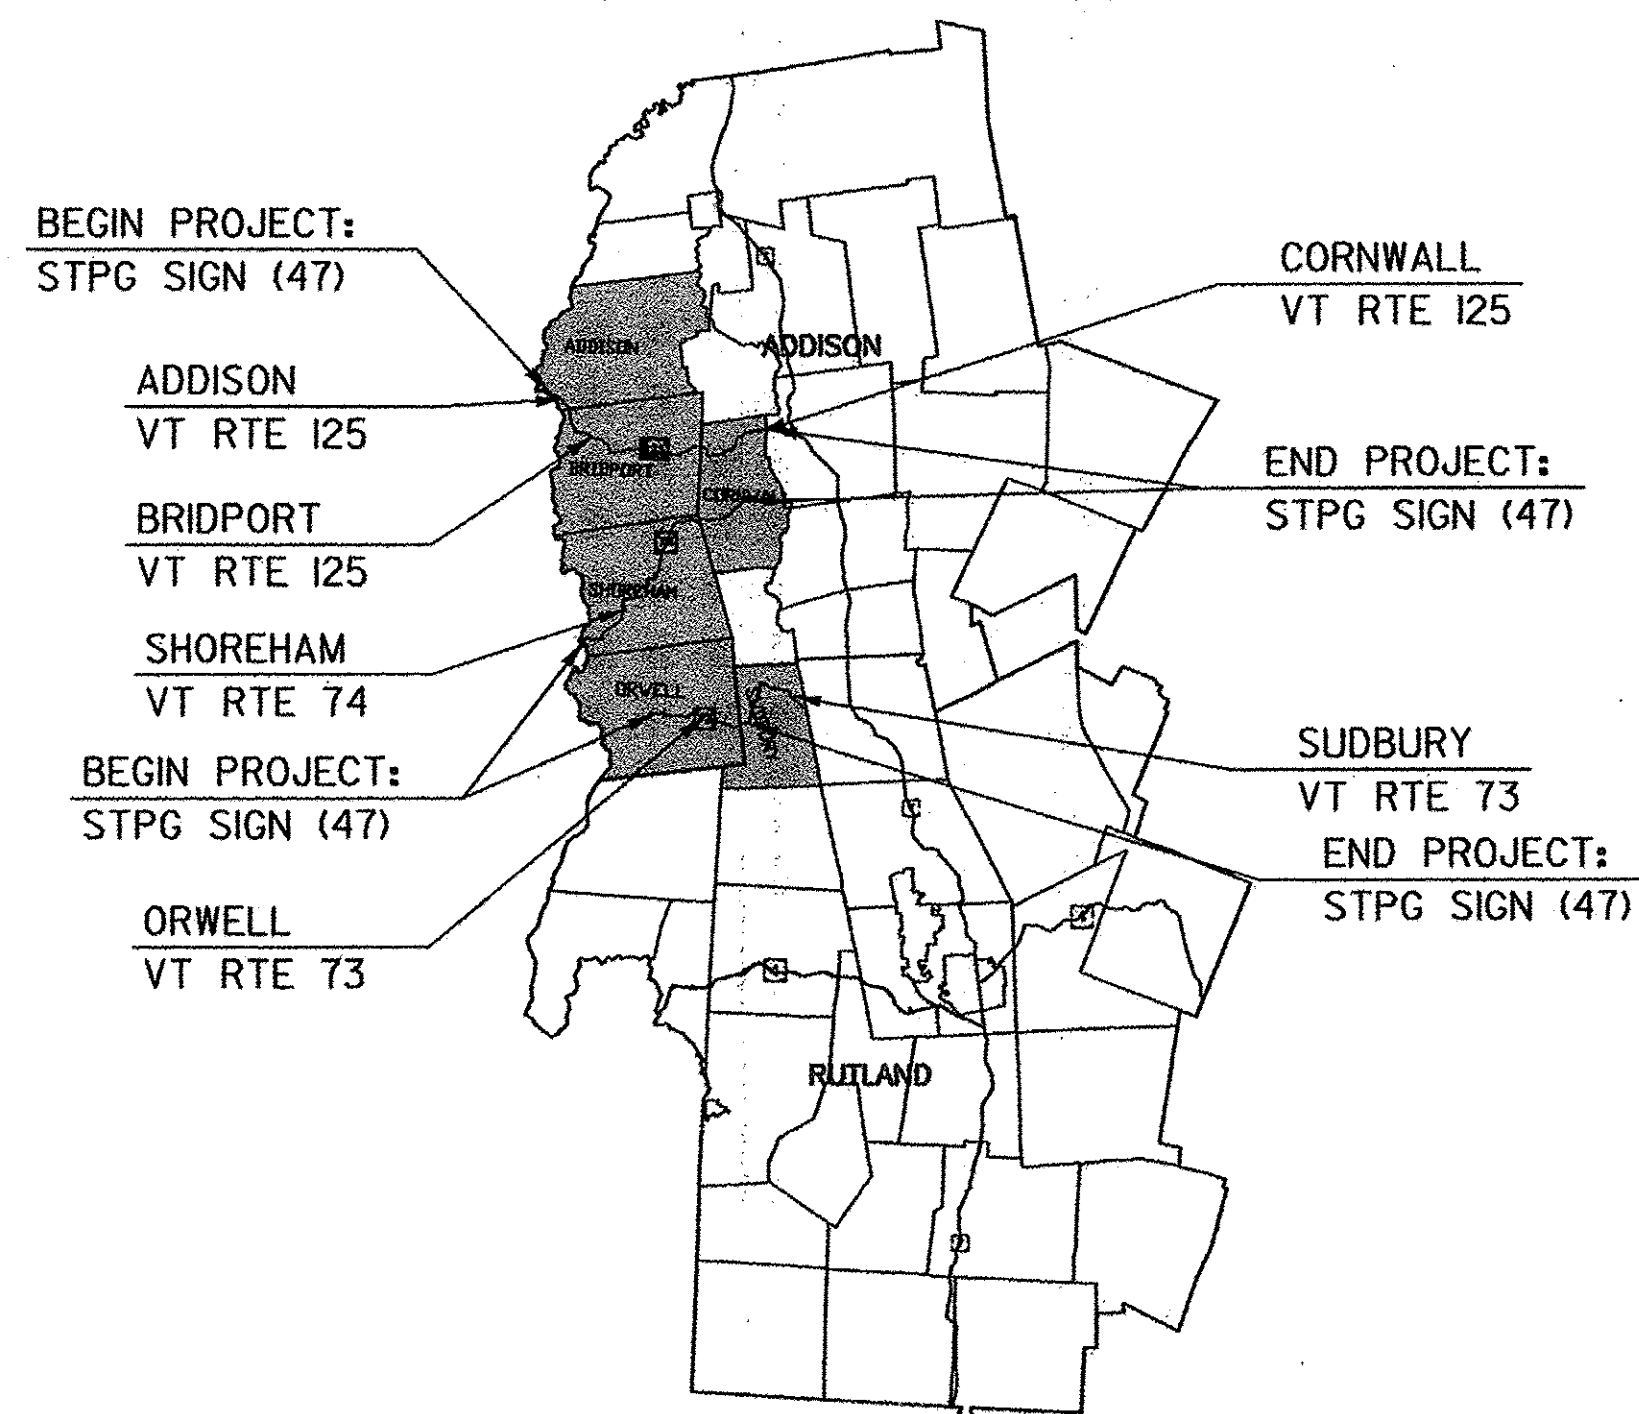


NOT TO SCALE

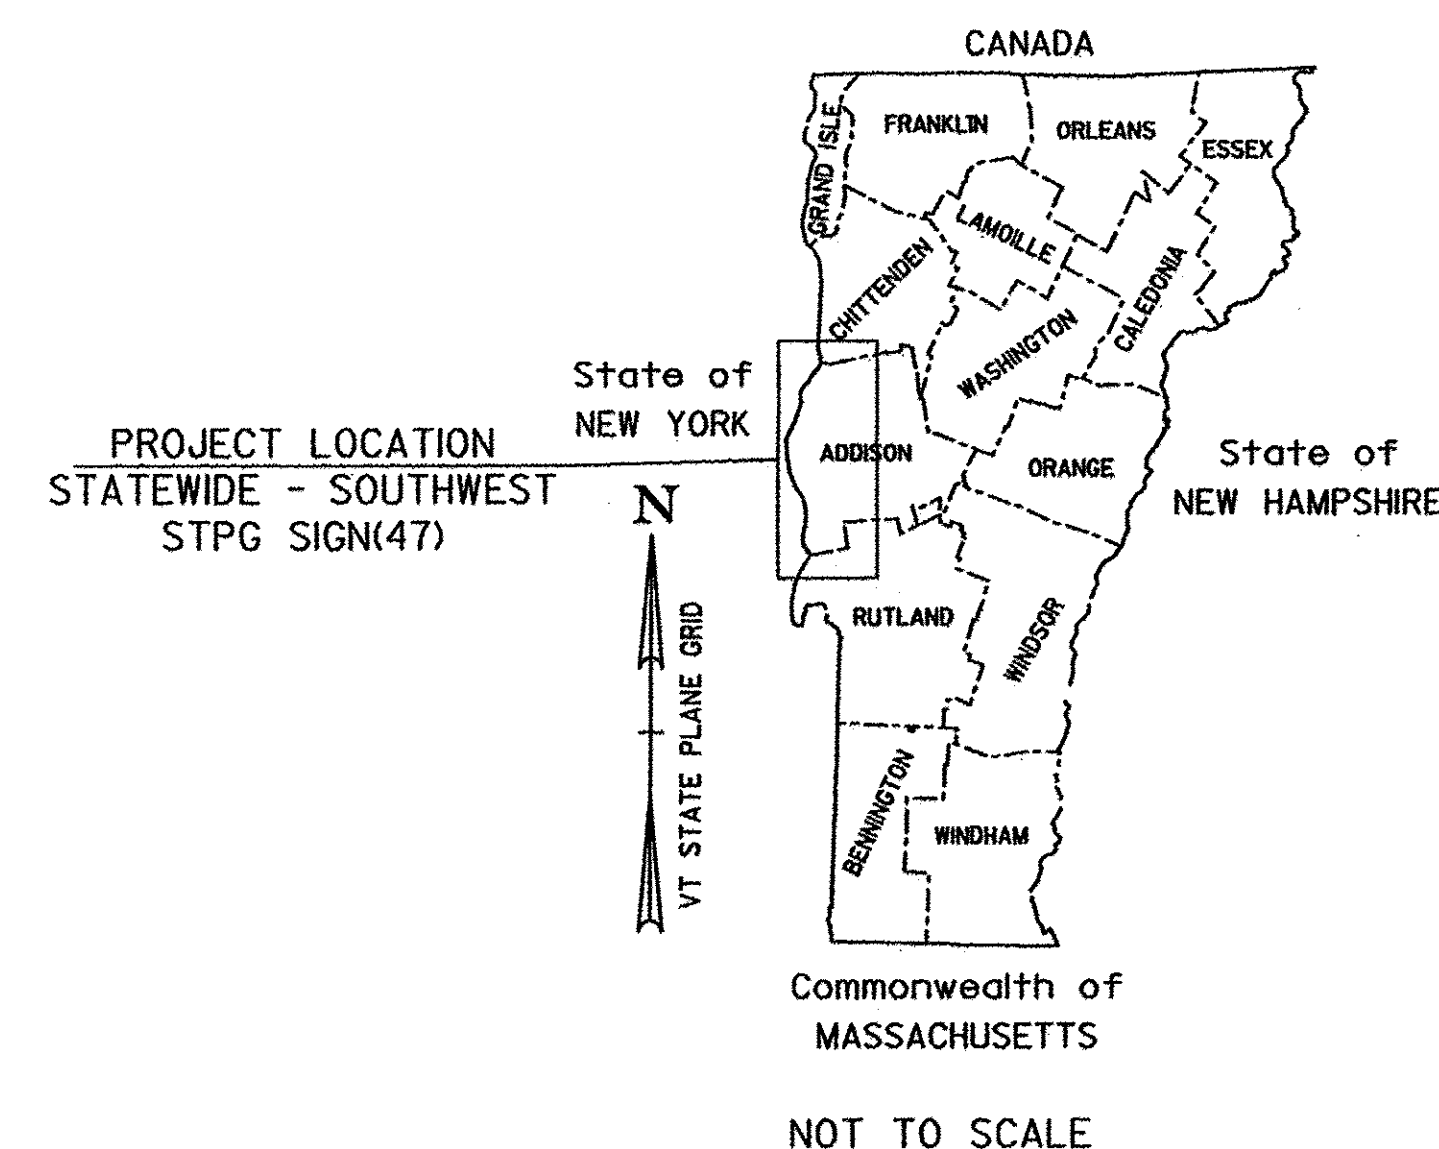


CONSTRUCTION IS TO BE CARRIED ON IN ACCORDANCE WITH THESE PLANS AND THE STANDARD SPECIFICATIONS FOR CONSTRUCTION DATED 2011, AS APPROVED BY THE FEDERAL HIGHWAY ADMINISTRATION ON JULY 20, 2011 FOR USE ON THIS PROJECT, INCLUDING ALL SUBSEQUENT REVISIONS AND SUCH REVISED SPECIFICATIONS AND SPECIAL PROVISIONS AS ARE INCORPORATED IN THESE PLANS.

|                                     |     |
|-------------------------------------|-----|
| QUALITY ASSURANCE PROGRAM : LEVEL 3 |     |
| SURVEYED BY :                       | N/A |
| SURVEYED DATE :                     | N/A |
| DATUM                               |     |
| VERTICAL                            | N/A |
| HORIZONTAL                          | N/A |

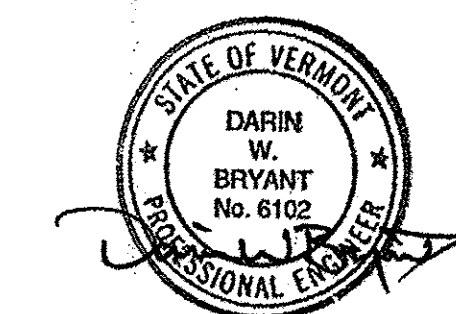

TYLINTERNATIONAL

|                                                                                                |                |
|------------------------------------------------------------------------------------------------|----------------|
| DIRECTOR OF PROJECT DELIVERY                                                                   |                |
| APPROVED  | DATE 8/28/2014 |
| PROJECT MANAGER : PATTI COBURN, P. E.                                                          |                |
| PROJECT NAME : STATEWIDE-SOUTHWEST                                                             |                |
| PROJECT NUMBER : STPG SIGN (47)                                                                |                |
| SHEET 1 OF 107 SHEETS                                                                          |                |