



**Firehouse Rd**

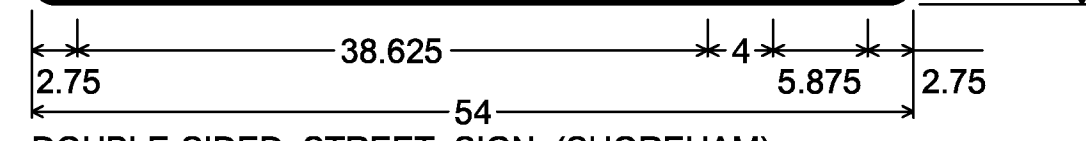


DOUBLE-SIDED STREET SIGN (SHOREHAM);  
1.500" Radius, 0.500" Border, White on Green;  
[Firehouse] D; [Rd] D;

**Tottingham Rd**

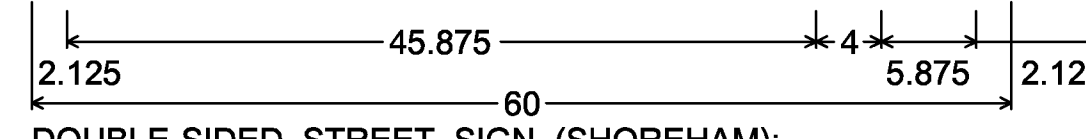


DOUBLE-SIDED STREET SIGN (SHOREHAM);  
1.500" Radius, 0.500" Border, White on Green;  
[Tottingham] D; [Rd] D;

**Bates Rd**

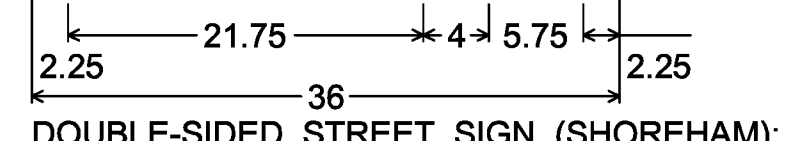


DOUBLE-SIDED STREET SIGN (SHOREHAM);  
1.500" Radius, 0.500" Border, White on Green;  
[Bates] D; [Rd] D;

**N Palmer Rd**

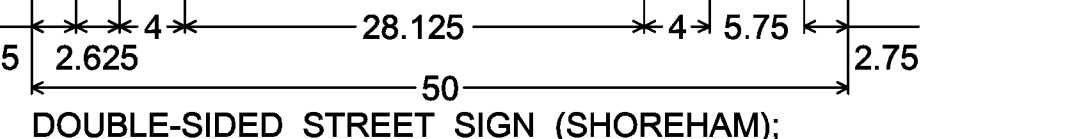


DOUBLE-SIDED STREET SIGN (SHOREHAM);  
1.500" Radius, 0.500" Border, White on Green;  
[N] D; [Palmer] D; [Rd] D;

**Glen View Dr Pvt**

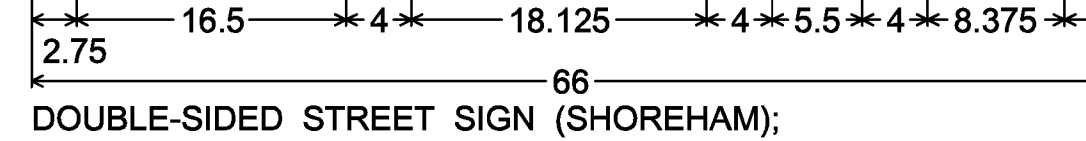


DOUBLE-SIDED STREET SIGN (SHOREHAM);  
1.500" Radius, 0.500" Border, White on Green;  
[Glen View] D; [Dr Pvt] D;

**Quiet Valley Rd**

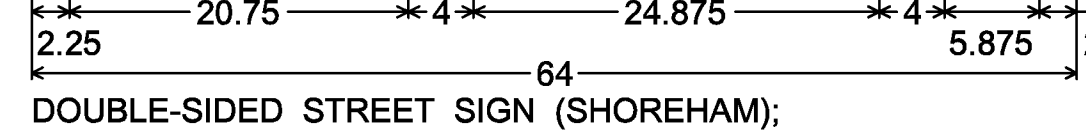

DOUBLE-SIDED STREET SIGN (SHOREHAM);  
1.500" Radius, 0.500" Border, White on Green;  
[Quiet Valley] D; [Rd] D;

**North Wind Ln Pvt**

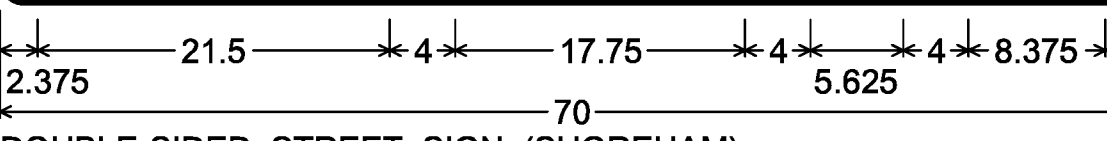


DOUBLE-SIDED STREET SIGN (SHOREHAM);  
1.500" Radius, 0.500" Border, White on Green;  
[North Wind] D; [Ln Pvt] D;

**Doolittle Rd**




DOUBLE-SIDED STREET SIGN (SHOREHAM);  
1.500" Radius, 0.500" Border, White on Green;  
[Doolittle] C 80% spacing;  
[Rd] C 80% spacing;

**Elmendorf Rd**

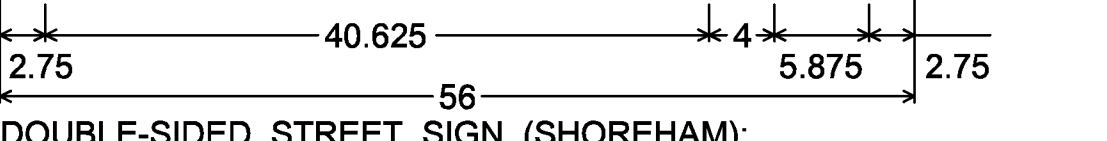


DOUBLE-SIDED STREET SIGN (SHOREHAM);  
1.500" Radius, 0.500" Border, White on Green;  
[Elmendorf] D; [Rd] D;

**Inn Rd**

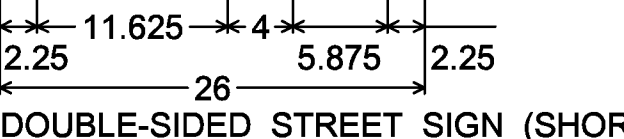


DOUBLE-SIDED STREET SIGN (SHOREHAM);  
1.500" Radius, 0.500" Border, White on Green;  
[Inn] D; [Rd] D;

**Watch Point Rd**

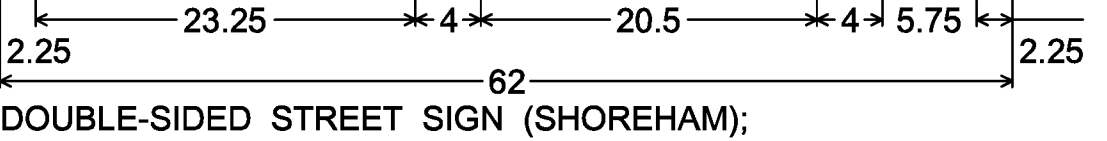


DOUBLE-SIDED STREET SIGN (SHOREHAM);  
1.500" Radius, 0.500" Border, White on Green;  
[Watch Point] D; [Rd] D;

**Basin Harbor Rd**

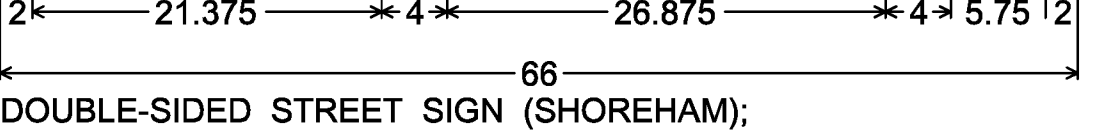

DOUBLE-SIDED STREET SIGN (SHOREHAM);  
1.500" Radius, 0.500" Border, White on Green;  
[Basin Harbor] D; [Rd] D;

**Witherell Rd**

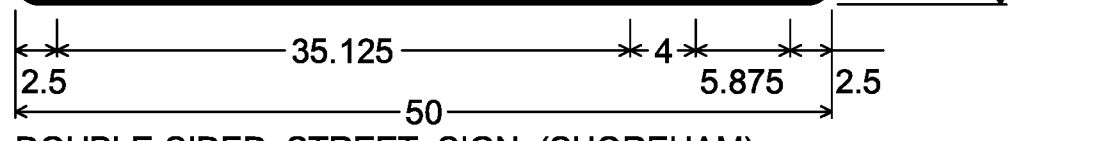

DOUBLE-SIDED STREET SIGN (SHOREHAM);  
1.500" Radius, 0.500" Border, White on Green;  
[Witherell] D; [Rd] D;

**Jenison Rd**




DOUBLE-SIDED STREET SIGN (SHOREHAM);  
1.500" Radius, 0.500" Border, White on Green;  
[Jenison] C; [Rd] C;

**Smith st**




DOUBLE-SIDED STREET SIGN (SHOREHAM);  
1.500" Radius, 0.500" Border, White on Green;  
[Smith] D; [St] D;

**Town Line Rd**

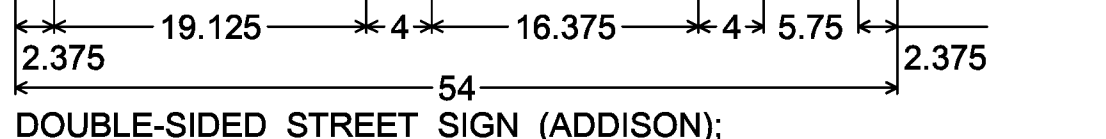


DOUBLE-SIDED STREET SIGN (ADDISON);  
1.500" Radius, 0.500" Border, White on Green;  
[Town Line] D; [Rd] D;

**Goose Bay Dr Pvt**

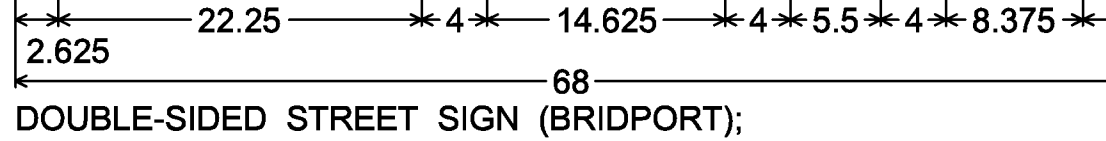

DOUBLE-SIDED STREET SIGN (BRIDPORT);  
1.500" Radius, 0.500" Border, White on Green;  
[Goose Bay] D; [Dr Pvt] D;

**Lake st**

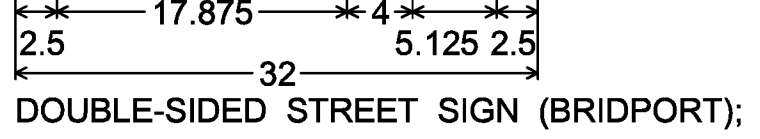

DOUBLE-SIDED STREET SIGN (BRIDPORT);  
1.500" Radius, 0.500" Border, White on Green;  
[Lake] D; [St] D;

**ALL SIGNS ON THIS PAGE ARE SIGN CODE D3-1  
(ALL SIGNS ARE DOUBLE - SIDED)**

ALL DIMENSIONS SHOWN IN INCHES, EXCEPT WHERE NOTED.

NOT TO SCALE

**TYLIN**INTERNATIONAL

PROJECT NAME:	STATEWIDE-SOUTHWEST
PROJECT NUMBER:	STPG SIGN(47)
FILE NAME:	z12c534_SD03.dgn
PROJECT LEADER:	D. BRYANT
DESIGNED BY:	B. TOOTHAKER
SIGN DETAILS	9
PLOT DATE:	9/15/2014
DRAWN BY:	B. TOOTHAKER
CHECKED BY:	K. KERN
SHEET	12 OF 107