
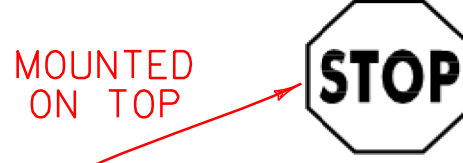








DIRECTION	MILEPOINT	LOCATION CODE (SHEET 2)	SIGN CODE	WIDTH (IN)	HEIGHT (IN)	SHEETING REMARKS	SIGN LEGEND	NEW SIGNS		EXISTING SIGNS				EXIST POST		NUMBER OF NEW POSTS	SQUARE STEEL (IN)			TUBULAR STEEL Ø (IN)				SIGN FRAME REQUIRED	REMARKS	SIGN DETAIL LOCATION							
								"A"	"B"	RETAIN	SALVAGE FROM	SALVAGE TO	REMOVE	RETAIN	REMOVE		1.75	2.00	2.50	FOUNDATION	3.00	3.50	4.00			5.00	SHSM	PROJECT SHEET #	STANDARD SHEET #				
																	(LB / FT)				(LB / FT)												
ORWELL VT-73 EB							FY-FLUORESCENT YELLOW FYG-FLUORESCENT YELLOW GREEN															"SHSM"-STANDARD HIGHWAY SIGNS AND MARKINGS											
		C	VR-017	24	30			5.00															ROBERTS AVE (TH-33)		9								
EB	0.372	D	R1-1	30	30							1		X									SALVAGE AND REMOUNT ON STOP SIGN POST										
		C	UNK.	UNK.	UNK.	WARNING UNDERGROUND CABLE				1	1	1																					
		D	R1-1	30	30			6.25						1		14.0 X							X	ROBERTS AVE (TH-33)									
EB	0.372	A/B	D3-1	42	12			3.50						+		X								ROBERTS AVE (TH-33); FIELD LOCATE FOR VISIBILITY FROM VT73		11							
EB	0.466	C	R2-1	24	30	SPEED LIMIT 25				1	1	1		X									SALVAGE AND REMOUNT BELOW LEGAL LOAD										
		C	VR-017	24	30			5.00		2	2	2		1		16.0 X								CHURCH ST (TH-40)		9							
EB	0.471	D	R1-1	30	30							1		X																			
		A/B	D3-1	UNK.	UNK.							1																					
		A/B	D3-1	42	12			3.50						1		14.0 X								CHURCH ST (TH-40)		11							
		D	R1-1	30	30			6.25															X	CHURCH ST (TH-40)									
EB	0.493	A	W1-2R	30	30	RIGHT CURVE						1		X																			
		A	W13-1	18	18	20 MPH						1																					
		A	R2-1	24	30			5.00						1		14.5 X 15.0						X	INSTALL AT LOCATION OF EXISTING CURVE WARNING										
EB	0.524	A	W1-4R	30	30			6.25						1		X							X	INSTALL 255 FT WEST OF EXISTING									
SIGN SUMMARY SHEET							SHEET TOTALS		40.75	0.00	0	4 2	4 2	9 7	0	0	5 6	73.5 90.0	0	0.0	0.0	0.0	0.0	PROJECT NAME: STATEWIDE-SOUTHWEST PROJECT NUMBER: STPG SIGN(47)									
VERMONT AGENCY OF TRANSPORTATION							SF	SF	EA	EA	EA	EA	EA	EA	EA	EA	EA	EA	EA	EA	EA	EA	EA	EA	EA	EA	EA	EA	FILE NAME: z12c534TSS.xlsm PROJECT MANAGER: D. BRYANT DESIGNED BY: B. TOOTHAKER ORWELL EB SHEET 3				
TOWN DIRECTIONAL TOTALS							285.3	0.0	1	3	3	56	0	0	35	525.0	0	0.0	0.0	0.0	0.0	0.0	0.0	0.0	PLOT DATE: 9/12/2014 DRAWN BY: B. TOOTHAKER CHECKED: K. KERN SHEET 16 OF 107								