








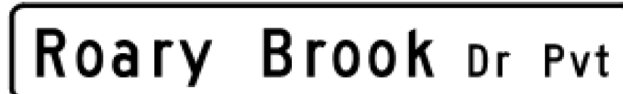

| DIRECTION | MILEPOINT | LOCATION CODE (SHEET 2) | SIGN CODE | WIDTH (IN) | HEIGHT (IN) | SHEETING REMARKS | SIGN LEGEND | NEW SIGNS | | EXISTING SIGNS | | | | EXIST POST | | NUMBER OF NEW POSTS | SQUARE STEEL (IN) | | | TUBULAR STEEL Ø (IN) | | | | SIGN FRAME REQUIRED | REMARKS | SIGN DETAIL LOCATION | | | |
|----------------------------------|-----------|-------------------------|-----------|------------|-------------|------------------|---|-----------|------|----------------|--------------|------------|--------|------------|--------|---------------------|---------------------|------|------|----------------------|-----------|------|---|--|--|----------------------|------|-----------------|------------------|
| | | | | | | | | "A" | "B" | RETAIN | SALVAGE FROM | SALVAGE TO | REMOVE | RETAIN | REMOVE | | 1.75 | 2.00 | 2.50 | FOUNDATION | 3.00 | 3.50 | 4.00 | | | 5.00 | SHSM | PROJECT SHEET # | STANDARD SHEET # |
| | | | | | | | | | | | | | | | | | (LB / FT) | | | | (LB / FT) | | | | | | | | |
| ORWELL VT-73 WB | | | | | | | FY-FLUORESCENT YELLOW FYG-FLUORESCENT YELLOW GREEN | | | | | | | | | | | | | | | | "SHSM"-STANDARD HIGHWAY SIGNS AND MARKINGS | | | | | | |
| | | E/F D3-1 | | 68 | 12 | |  | 5.67 | | | | | | | | 2 | 11.5 X 11.5 | | | | | | | | ROARY BROOK DR (PVT) | | 11 | | |
| WB 1.140 | | F W1-2R | | 30 | 30 | | RIGHT CURVE | | | | | | 1 | | | | | | | | | | | | | | | | |
| WB 1.102 | | F VW-060 | | 30 | 30 | | | | | | | | 1 | | | | | | | | | | | | | | | | |
| | | F VW-060 | | 30 | 30 | |  | 6.25 | | | | | | | | | 11.0 X | | | | | | | | EXISTING POST WAS DAMAGED | | 9 | | |
| WB 1.064 | | F W3-5 | | 36 | 36 | | REDUCED SPEED AHEAD | | | | | | 1 | | | | | | | | | | | | | | | | |
| | | F W1-2R | | 30 | 30 | |  | 6.25 | | | | | | | | 1 | 16.25 X | | | | | | | | | | | | X |
| WB 1.006 | | F W3-5 | | 36 | 36 | |  | 9.00 | | | | | | | | 2 | 12.25 X 11.75 | | | | | | | | INSTALL 305 FT WEST OF EXISTING | X | | | |
| WB 0.968 | | F VD-018 | | 30 | 18 | |  | 3.75 | | | | | | | | 1 | 13.0 X | | | | | | | | INSTALL 200 FT WEST OF NEW SPEED REDUCTION WARNING | | 6 | | |
| WB 0.930 | | F W1-4R | | 30 | 30 | |  | 6.25 | | | | | | | | 1 | 14.75 X | | | | | | | | INSTALL 200 FT EAST OF SPEED LIMIT 35 | X | | | |
| WB 0.892 | | F R2-1 | | 30 | 36 | | | | | | | | 1 | | | | | | | | | | | | USED 1 BAG OF CONCRETE IN HOLE | | | | |
| | | F R2-1 | | 30 | 36 | |  | 7.50 | | | | | | | | | 12.0 X | | | | | | | | EXISTING POST WAS DAMAGED | X | | | |
| WB 0.842 | | F VW-202 | | 30 | 30 | | TRUCKS ENTERING | | | | | | 1 | | | | | | | | | | | | | | | | |
| | | F W11-10 | | 30 | 30 | |  | 6.25 | | | | | | | | 1 | 13.0 X | | | | | | | | | | | | X |
| WB 0.796 | | F VW-730 | | 30 | 30 | | EMERGENCY VEHICLES ENTERING | | | | | | 1 | | | | | | | | | | | | | | | | |
| | | F W11-8 | | 30 | 30 | |  | 6.25 | | | | | | | | 1 | 13.5 X | | | | | | | | | | | | X |
| SIGN SUMMARY SHEET | | | | | | | SHEET TOTALS | 57.17 | 0.00 | 0 | 1 | 2 | 8 | 0 | 0 | 11 | 140.5 135.0 | 0 | 0.0 | 0.0 | 0.0 | 0.0 | | PROJECT NAME: STATEWIDE-SOUTHWEST PROJECT NUMBER: STPG SIGN(47) | | | | | |
| VERMONT AGENCY OF TRANSPORTATION | | | | | | | TOWN DIRECTIONAL TOTALS | 407.4 | 0.0 | 1 | 3 | 3 | 73 | 0 | 0 | 45 | 675.0 | 0 | | | 0.0 | | | FILE NAME: z12c534TSS.xlsm PROJECT MANAGER: D. BRYANT DESIGNED BY: B. TOOTHAKER ORWELL WB SHEET 5 | | | | | |
| | | | | | | | | | | | | | | | | | | | | | | | PLOT DATE: 9/12/2014 DRAWN BY: B. TOOTHAKER CHECKED: K. KERN SHEET 26 OF 107 | | | | | | |