


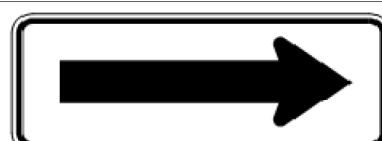


DIRECTION	MILEPOINT	LOCATION CODE (SHEET 2)	SIGN CODE	WIDTH (IN)	HEIGHT (IN)	SHEETING REMARKS	SIGN LEGEND	NEW SIGNS		EXISTING SIGNS				EXIST POST		NUMBER OF NEW POSTS	SQUARE STEEL (IN)			TUBULAR STEEL Ø (IN)				SIGN FRAME REQUIRED	REMARKS	SIGN DETAIL LOCATION						
								"A"	"B"	RETAIN	SALVAGE FROM	SALVAGE TO	REMOVE	RETAIN	REMOVE		1.75	2.00	2.50	FOUNDATION	3.00	3.50	4.00			5.00	SHSM	PROJECT SHEET #	STANDARD SHEET #			
																	(LB / FT)				(LB / FT)											
ADDISON VT-125 WB							FY-FLUORESCENT YELLOW FYG-FLUORESCENT YELLOW GREEN																"SHSM"-STANDARD HIGHWAY SIGNS AND MARKINGS									
WB	0.968	F	W11-2	30	30		PEDESTRIAN SYMBOL			1																						
		F	W16-9P	24	12		AHEAD			1																						
WB	0.749	F	R2-1	24	30																											
		F	VD-700	6	8		MILEMARKER																									
		F	R2-1	24	30			5.00																								
WB	0.348	F	W1-4R	30	30		RIGHT REVERSE CURVE																									
		F	VD-700	6	8		MILEMARKER																									
		F	R2-1	24	30			5.00						1																		
WB	0.320	F	VD-062AL	72	16		BUSINESS SIGN			1																						
		F	VD-062BRN	72	16		BUSINESS SIGN			1																						
WB	0.292	F	R2-1	24	30		SPEED LIMIT 40																									
		F	W1-4R	30	30			6.25																								
WB	0.198	E	W1-6R	48	24																											
		E	W1-6R	48	24			8.00																								
WB	0.181	F	W1-6L	48	24																											
SIGN SUMMARY SHEET							SHEET TOTALS		24.25	0.00	2	4	0	0	1	8	0	0	4	40.75	60.0	0	0.0	0.0	0.0	0.0	0.0	PROJECT NAME: STATEWIDE-SOUTHWEST PROJECT NUMBER: STPG SIGN(47)				
VERMONT AGENCY OF TRANSPORTATION							SF	SF	EA	EA	EA	EA	EA	EA	EA	EA	EA	EA	EA	FT	EA	LB	LB	LB	LB	LB	FILE NAME: z12c534TSS.xlsm PROJECT MANAGER: D. BRYANT DESIGNED BY: B. TOOTHAKER ADDISON WB SHEET 3					
TOWN DIRECTIONAL TOTALS							107.3	0.0	24	0	0	21	0	0	13	195.0	0	0.0	0.0	0.0	0.0	0.0	0.0	0.0	0.0	PLOT DATE: 9/15/2014 DRAWN BY: B. TOOTHAKER CHECKED: K. KERN SHEET 78 OF 107						