








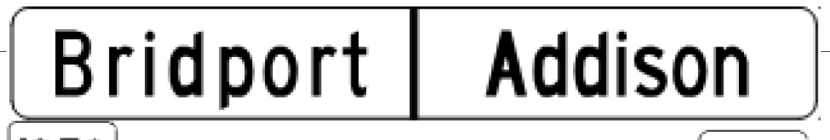

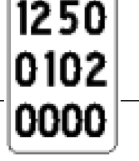

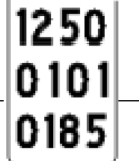

DIRECTION	MILEPOINT	LOCATION CODE (SHEET 2)	SIGN CODE	WIDTH (IN)	HEIGHT (IN)	SHEETING REMARKS	SIGN LEGEND	NEW SIGNS		EXISTING SIGNS				EXIST POST		NUMBER OF NEW POSTS	SQUARE STEEL (IN)			TUBULAR STEEL Ø (IN)				SIGN FRAME REQUIRED	REMARKS	SIGN DETAIL LOCATION			
								"A"	"B"	RETAIN	SALVAGE FROM	SALVAGE TO	REMOVE	RETAIN	REMOVE		1.75	2.00	2.50	FOUNDATION	3.00	3.50	4.00			5.00	SHSM	PROJECT SHEET #	STANDARD SHEET #
																	(LB / FT)				(LB / FT)								
BRIDPORT VT-125 EB							FY-FLUORESCENT YELLOW FYG-FLUORESCENT YELLOW GREEN															"SHSM"-STANDARD HIGHWAY SIGNS AND MARKINGS							
EB	0.000	C	VD-024	72	10			5.00							2	12.75 X 13.0								INSTALL ACROSS FROM EXISTING SIGN		6			
		C	VD-700	6	10			0.42																			T-44		
		C	VD-700	6	10			0.42																			T-44		
EB	0.027	A/B	D3-1	UNK.	UNK.							1		X										GOOSE BAY DR (PVT); FIELD LOCATE FOR VISIBILITY FROM VT-125		12			
		A/B	D3-1	68	12			5.67							2	12.0 X 12.0								GOOSE BAY DR (PVT); FIELD LOCATE FOR VISIBILITY FROM VT-125		12			
EB	0.071	A/B	D3-1	UNK.	UNK.			5.67				1		X										GOOSE BAY DR (PVT); FIELD LOCATE FOR VISIBILITY FROM VT-125		12			
		A/B	D3-1	68	12			5.67							2	13.0 X 12.0								GOOSE BAY DR (PVT); FIELD LOCATE FOR VISIBILITY FROM VT-125		12			
EB	1.063	A	W1-10L	36	36		MODIFIED LEFT CURVE					1		X															
EB	1.120	A	W1-10L	36	36			9.00							2	14.0 X 14.75								INSTALL 300 FT EAST OF EXISTING	X				
EB	1.211	C	VR-017	24	30			5.00							1	14.75 X								LAKE ST (TH-3)		9			
EB	1.212	A/B	D3-1	UNK.	UNK.			2.67				1		X										LAKE ST (TH-3); FIELD LOCATE FOR VISIBILITY FROM VT-125		12			
		A/B	D3-1	32	12			2.67							1	12.75 X								LAKE ST (TH-3); FIELD LOCATE FOR VISIBILITY FROM VT-125		12			
EB	1.218	D	R1-1	30	30			6.25				1		X										LAKE ST (TH-3)	X				
		D	R1-1	30	30			6.25							1	14.0 X								LAKE ST (TH-3)					
EB	1.647	A	W1-10R	30	30		MODIFIED RIGHT CURVE					1		X															
SIGN SUMMARY SHEET							SHEET TOTALS	40.10	0.00	0	0	0	7 6	0	0	11	145.0 165.0	0	0.0	0.0	0.0	0.0	0.0	PROJECT NAME: STATEWIDE-SOUTHWEST PROJECT NUMBER: STPG SIGN(47)					
VERMONT AGENCY OF TRANSPORTATION							TOWN DIRECTIONAL TOTALS	250.6	0.0	9	1	1	49	0	0	42	630.0	0		0.0			FILE NAME: z12c534TSS.xlsm PROJECT MANAGER: D. BRYANT DESIGNED BY: B. TOOTHAKER BRIDPORT EB SHEET 1				PLOT DATE: 9/15/2014 DRAWN BY: B. TOOTHAKER CHECKED: K. KERN SHEET 81 OF 107		