

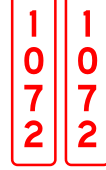


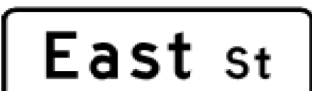



DIRECTION	MILEPOINT	LOCATION CODE (SHEET 2)	SIGN CODE	WIDTH (IN)	HEIGHT (IN)	SHEETING REMARKS	SIGN LEGEND	NEW SIGNS		EXISTING SIGNS				EXIST POST		NUMBER OF NEW POSTS	SQUARE STEEL (IN)			TUBULAR STEEL Ø (IN)				SIGN FRAME REQUIRED	REMARKS	SIGN DETAIL LOCATION											
								"A"	"B"	RETAIN	SALVAGE FROM	SALVAGE TO	REMOVE	RETAIN	REMOVE		1.75	2.00	2.50	FOUNDATION	3.00	3.50	4.00			5.00	SHSM	PROJECT SHEET #	STANDARD SHEET #								
																	(LB / FT)				(LB / FT)																
<b>BRIDPORT VT-125 WB</b>							FY-FLUORESCENT YELLOW FYG-FLUORESCENT YELLOW GREEN																"SHSM"-STANDARD HIGHWAY SIGNS AND MARKINGS														
WB	7.708	F	W1-10L	36	36		MODIFIED LEFT CURVE			1																											
		F	W16-8A	36	8		MARKET RD			1																											
WB	7.634	G	VR-017	24	30		LLL 24,000 LBS						1																								
WB	7.634	G	VR-017	24	30			5.00							1																	INSTALL 20 FT NORTH OF DRIVEWAY		9			
WB	7.630	H	R1-1	30	30		MM PLAQUE 0764						1																								
		H	R1-1	30	30			6.25							1																		MARKET RD (TH-24)	X			
WB	7.630	E/F	D3-1	UNK.	UNK.		MARKET RD (TH-24)			1																											
WB	7.104	E/F	D3-1	UNK.	UNK.								1																				(2) HOUSE NUMBER PLAQUES REMOUNTED ON NEW POST				
		E/F	D3-1	66	12			5.50					2																				PAYNE DR EAST (PVT); FIELD LOCATE FOR VISIBILITY FROM VT-125		13		
WB	6.456	G	VR-017	24	30		LLL 24,000 LBS						1																								
		E/F	UNK.	UNK.	UNK.		EAST ST 0 ->2830				1	1	1																				SALVAGE AND REMOUNT ABOVE LEGAL LOAD				
		G	VR-017	24	30			5.00																									EAST ST (TH-23)		9		
WB	6.450	H	R1-1	30	30		STOP	1.25					1																								
		E/F	D3-1	30	12			2.50																										EAST ST (TH-23); MOUNT TO STOP SIGN WITH BRACKET		13	
		H	R1-1	30	30			6.25																										EAST ST (TH-23)	X		
<b>SIGN SUMMARY SHEET</b>							SHEET TOTALS	33.0 30.50	0.00	3	4 4	4 4	9 6	0	0	4	46.75 60.0	0	0.0	0.0	0.0	0.0				PROJECT NAME: STATEWIDE-SOUTHWEST PROJECT NUMBER: STPG SIGN(47)											
VERMONT AGENCY OF TRANSPORTATION							TOWN DIRECTIONAL TOTALS	235.1	0.0	6	2	2	44	0	0	26	390.0	0		0.0					FILE NAME: z12c534TSS.xlsm PROJECT MANAGER: D. BRYANT DESIGNED BY: B. TOOTHAKER BRIDPORT WB SHEET 1	PLOT DATE: 9/15/2014 DRAWN BY: B. TOOTHAKER CHECKED: K. KERN SHEET 89 OF 107											