




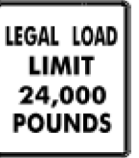


DIRECTION	MILEPOINT	LOCATION CODE (SHEET 2)	SIGN CODE	WIDTH (IN)	HEIGHT (IN)	SHEETING REMARKS	SIGN LEGEND	NEW SIGNS		EXISTING SIGNS				EXIST POST		NUMBER OF NEW POSTS	SQUARE STEEL (IN)			TUBULAR STEEL Ø (IN)				SIGN FRAME REQUIRED	REMARKS	SIGN DETAIL LOCATION			
								"A"	"B"	RETAIN	SALVAGE FROM	SALVAGE TO	REMOVE	RETAIN	REMOVE		1.75	2.00	2.50	FOUNDATION	3.00	3.50	4.00			5.00	SHSM	PROJECT SHEET #	STANDARD SHEET #
																	(LB / FT)				(LB / FT)								
CORNWALL VT-125 EB							FY-FLUORESCENT YELLOW FYG-FLUORESCENT YELLOW GREEN																"SHSM"-STANDARD HIGHWAY SIGNS AND MARKINGS						
		C	VR-017	24	30			5.00							1			14.25 X							CIDER MILL ROAD (TH-2)		9		
EB	3.260	A/B	D3-1	52	12			4.33							2			11.0 X 11.0							CIDER MILL ROAD (TH-2); FIELD LOCATE FOR VISIBILITY FROM VT125		13		
EB	3.267	D	R1-1	30	30		MM PLAQUE 0327																						
		A/B	D3-1	UNK.	UNK.		CIDER MILL RD (TH-2)																						
		D	R1-1	30	30			6.25							1			13.5 X								CIDER MILL ROAD (TH-2)	X		
EB	3.350	A	R2-1	24	30			5.00							1			12.5 X								INSTALL DIRECTLY ACROSS FROM WB SPEED LIMIT 40	X		
EB	3.365	A	R2-1	24	30		SPEED LIMIT 50																						
EB	3.708	A	VW-092	36	36		MM PLAQUE 0367																						
		A	VW-092	36	36			9.00							2			14.0 X 15.0										X	
EB	4.102	A	VW-092	36	36																								
		A	R4-1	36	36			9.00							2			15.0 X 14.5										X	
EB	4.140	A	VD-062B	72	16		BUSINESS SIGN			1																			
		A	VD-062B	72	16		BUSINESS SIGN			1																			
EB	4.278	A	VD-062B	72	16		BUSINESS SIGN			1																			
		A	VD-062B	72	16		BUSINESS SIGN			1																			
SIGN SUMMARY SHEET							SHEET TOTALS		38.58	0.00	4	2	2	7	0	0	9	120.75	0	0.0	0.0	0.0	0.0	PROJECT NAME: STATEWIDE - SOUTHWEST					
							SF	SF	EA	EA	EA	EA	EA	EA	EA	EA	EA	FT	EA	LB	LB	LB	LB	PROJECT NUMBER: STPG (SIGN 47)					
VERMONT AGENCY OF TRANSPORTATION							TOWN DIRECTIONAL TOTALS		199.67	0.0	23	1	4	40	0	0	35	420.5	0					FILE NAME: z12c534TSS.xlsm					
							192.7											525.0						PLOT DATE: 9/15/2014					
																								DRAWN BY: B. TOOTHAKER					
																								CHECKED: K. KERN					
																								SHEET 101 OF 107					
																								CORNWALL EB SHEET 6					