




120+00  
BEGIN APPROACH

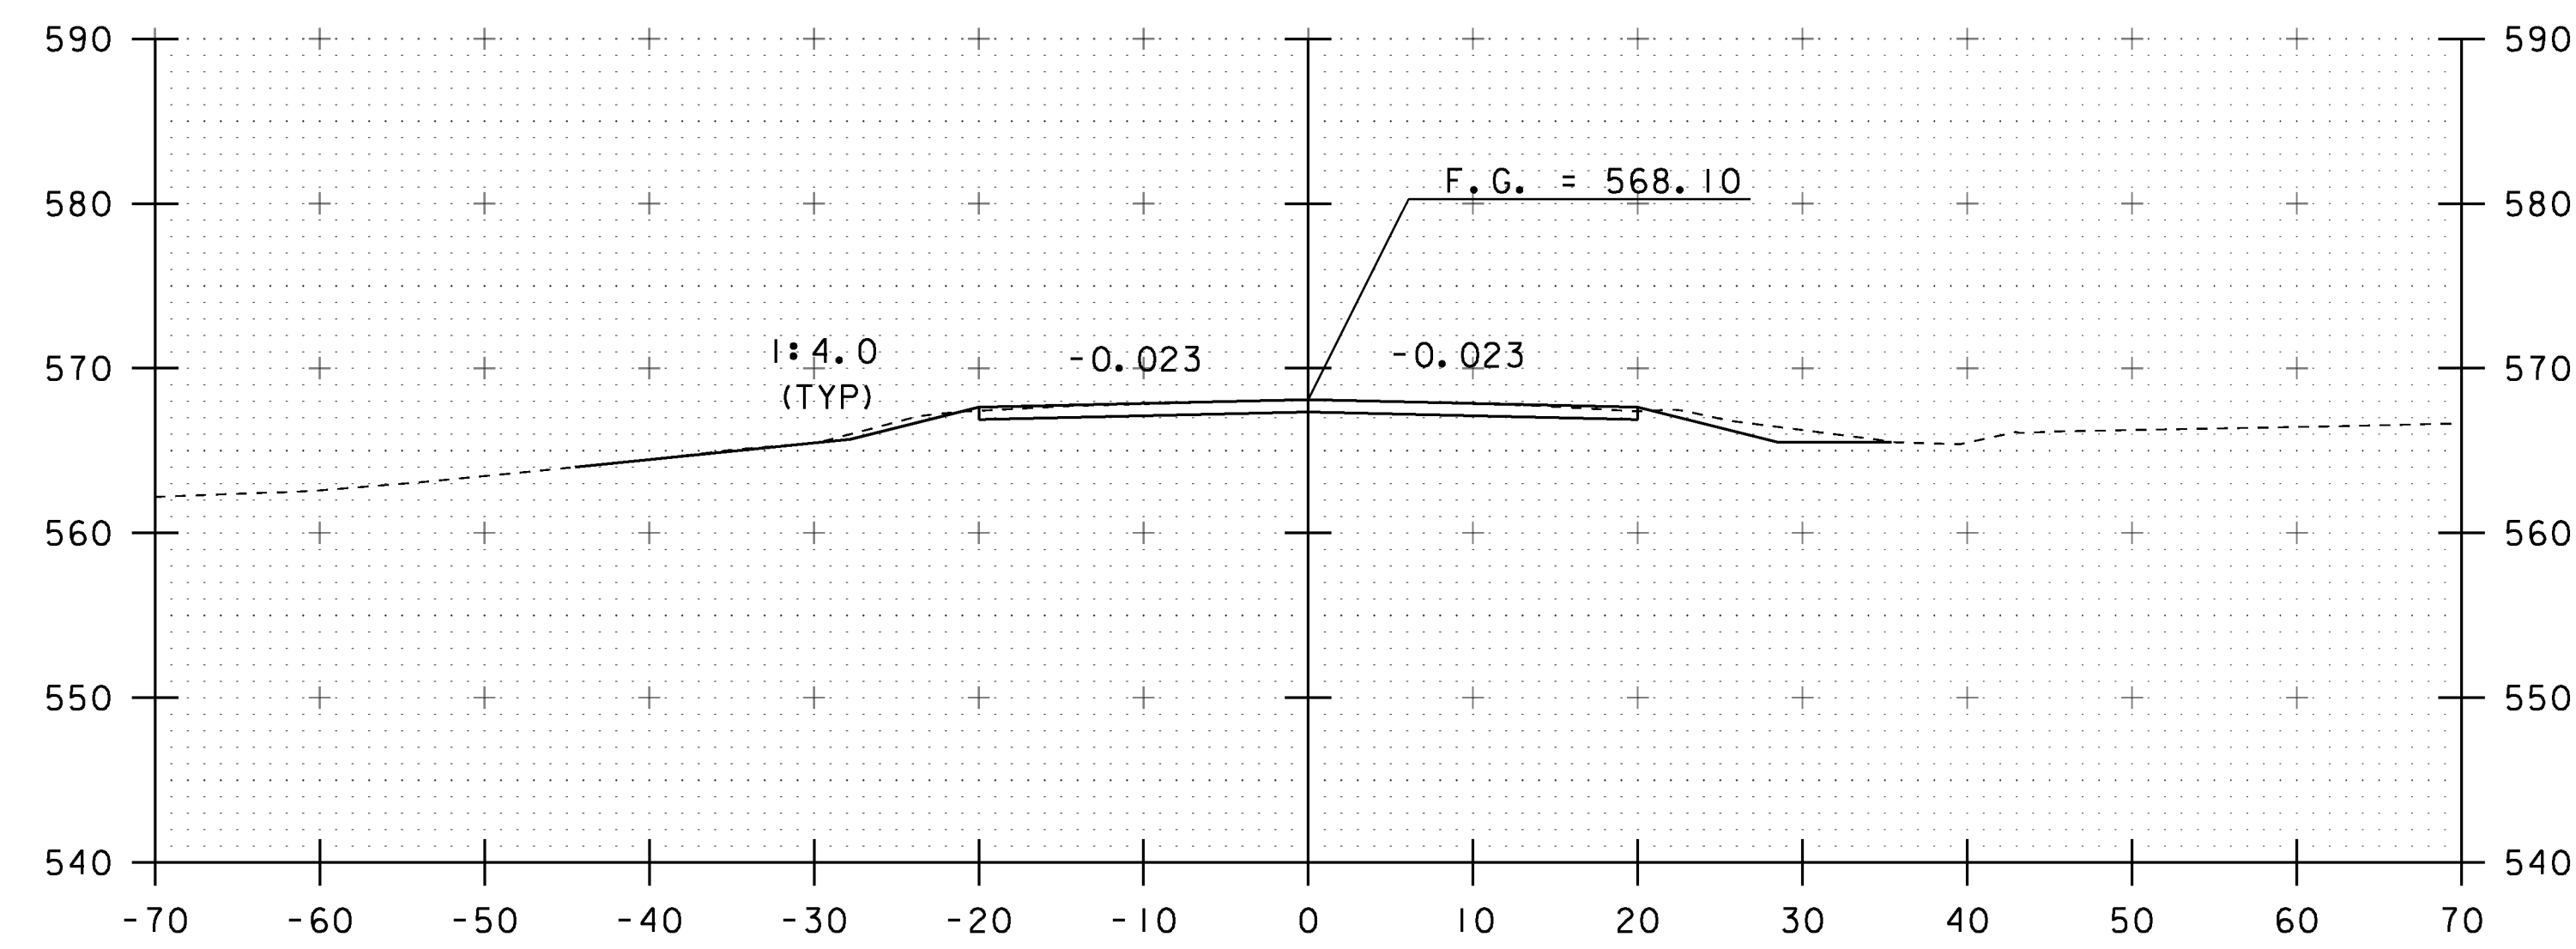

120+50

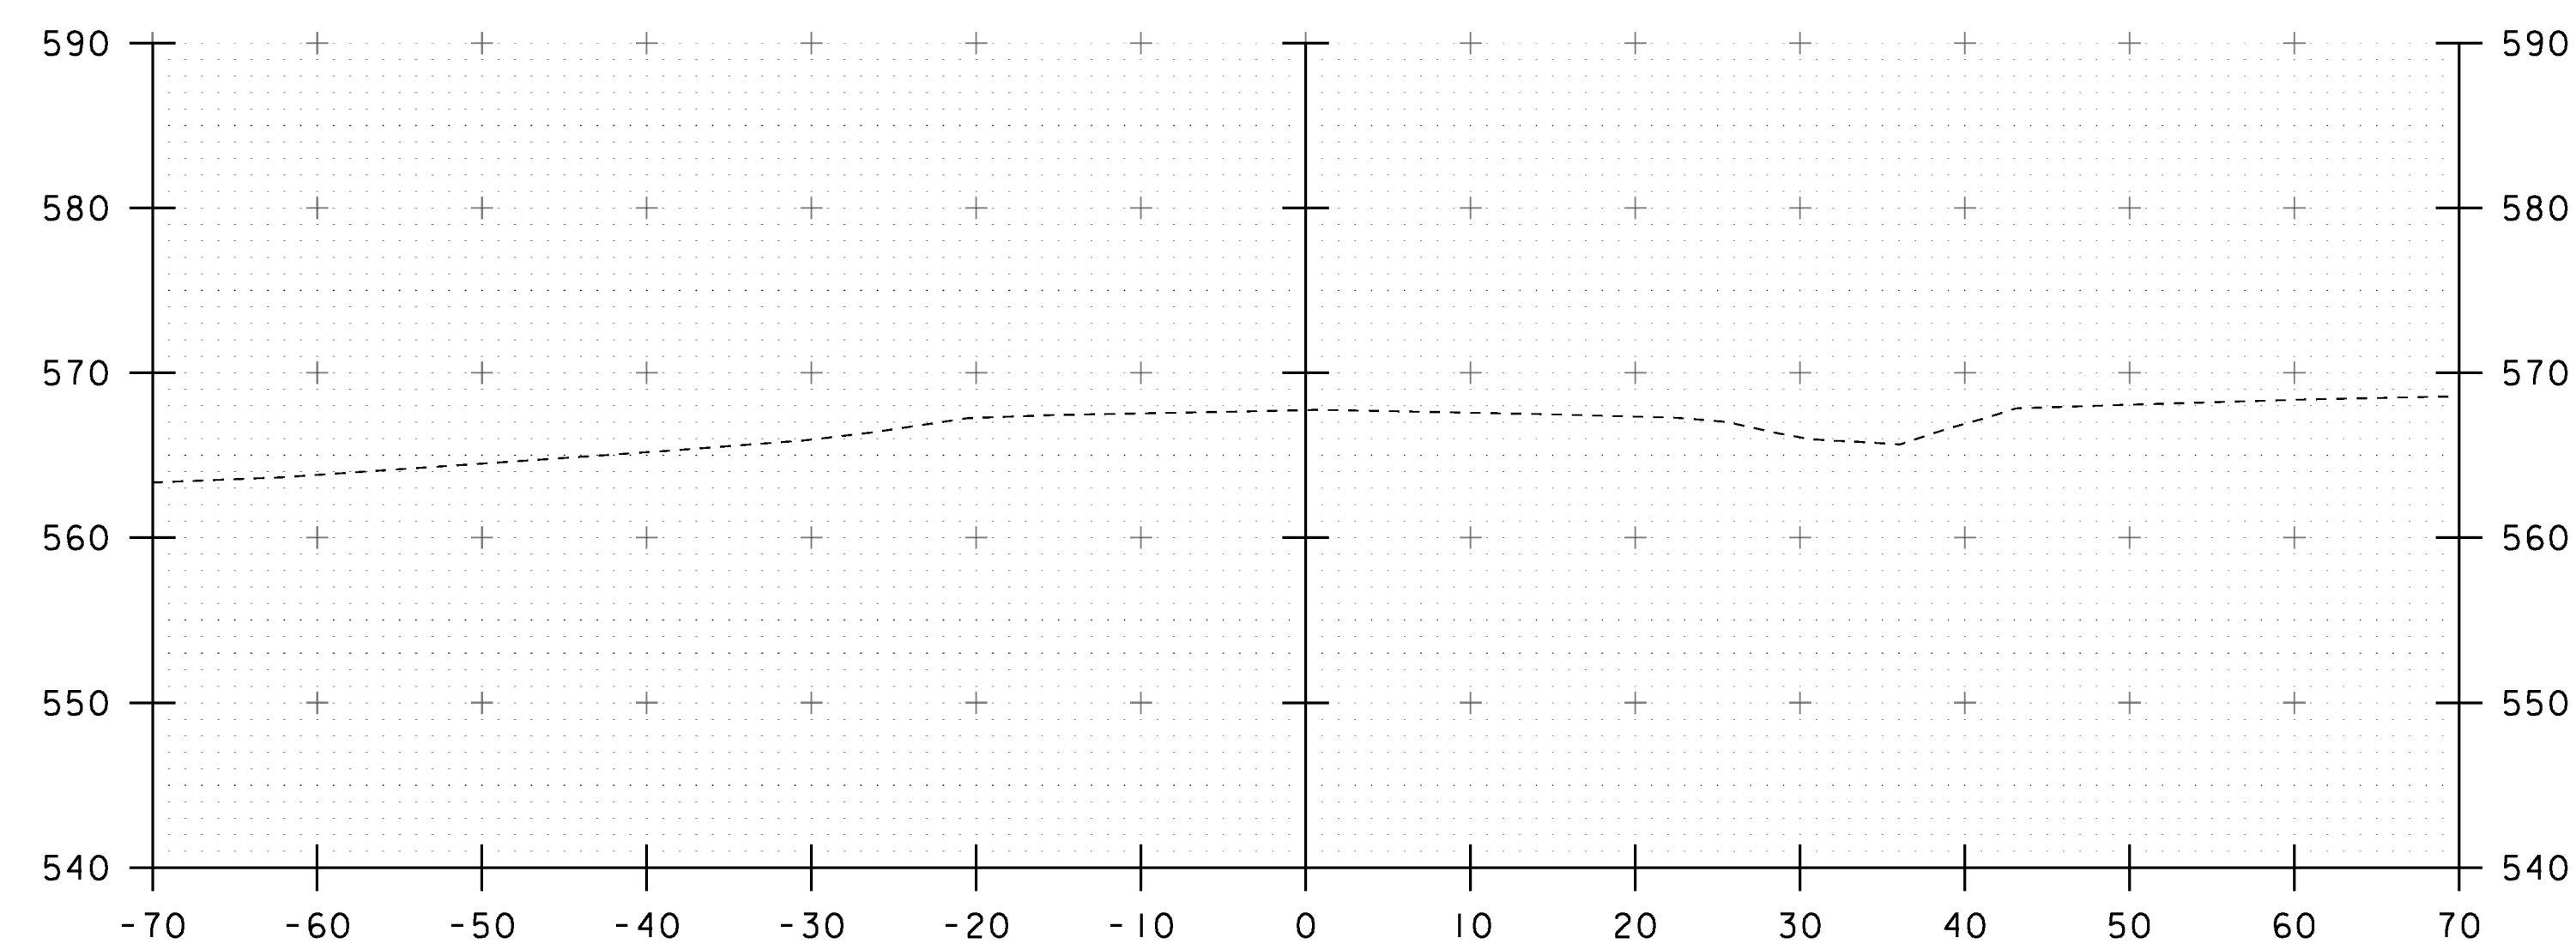

119+75

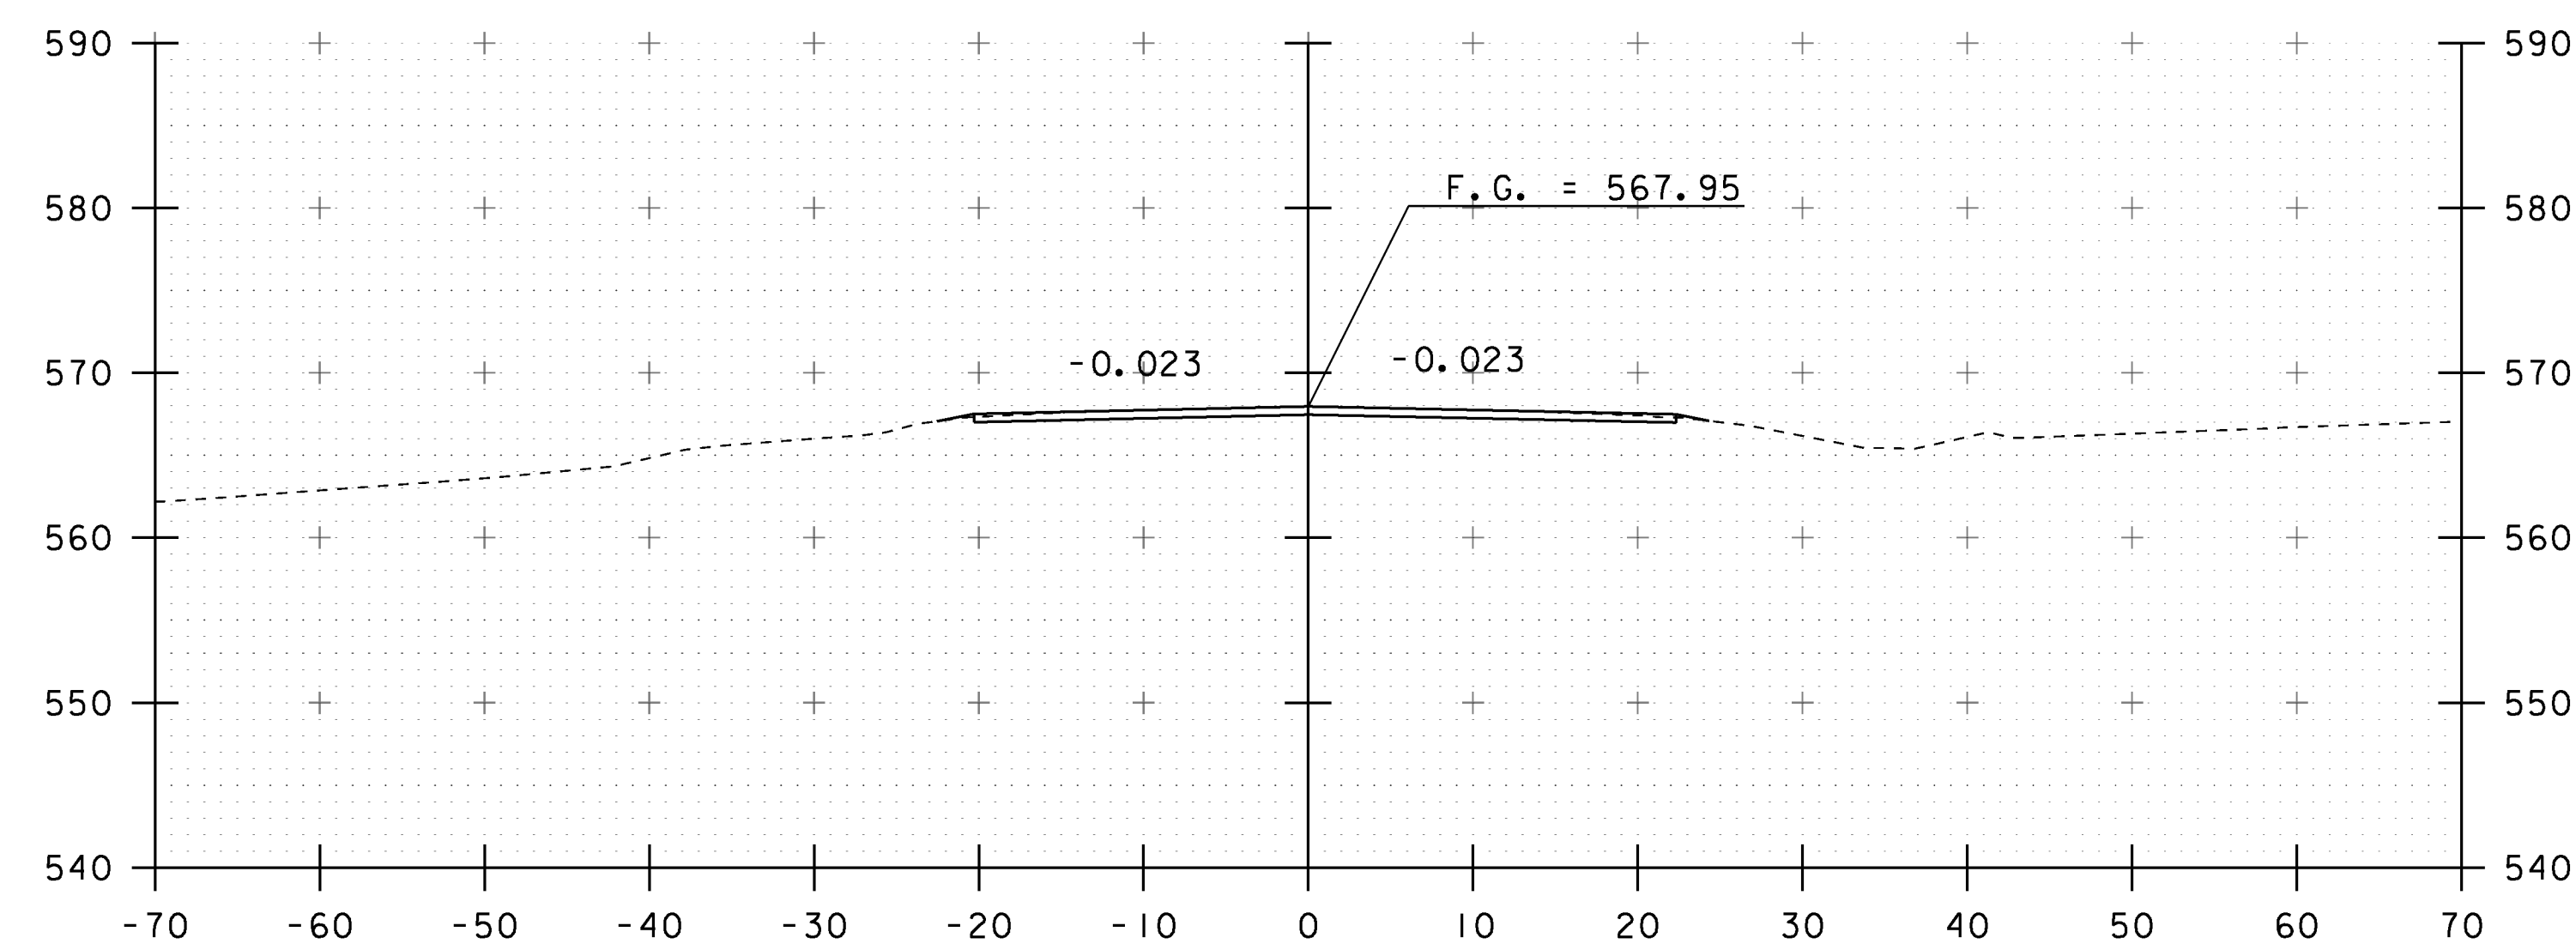

120+25

PROJECT NAME:	ST. ALBANS TOWN
PROJECT NUMBER:	BF 0279(5)
FILE NAME: sl2c598xs.dgn	PLOT DATE: 10-JAN-2017
PROJECT LEADER: J.B. MCCARTHY	DRAWN BY: J. SALVATORI
DESIGNED BY: J. SALVATORI	CHECKED BY: J.B. MCCARTHY
MAINLINE CROSS SECTIONS	SHEET 18 OF 29