




121+00
STA 121+12.50 END PROJECT

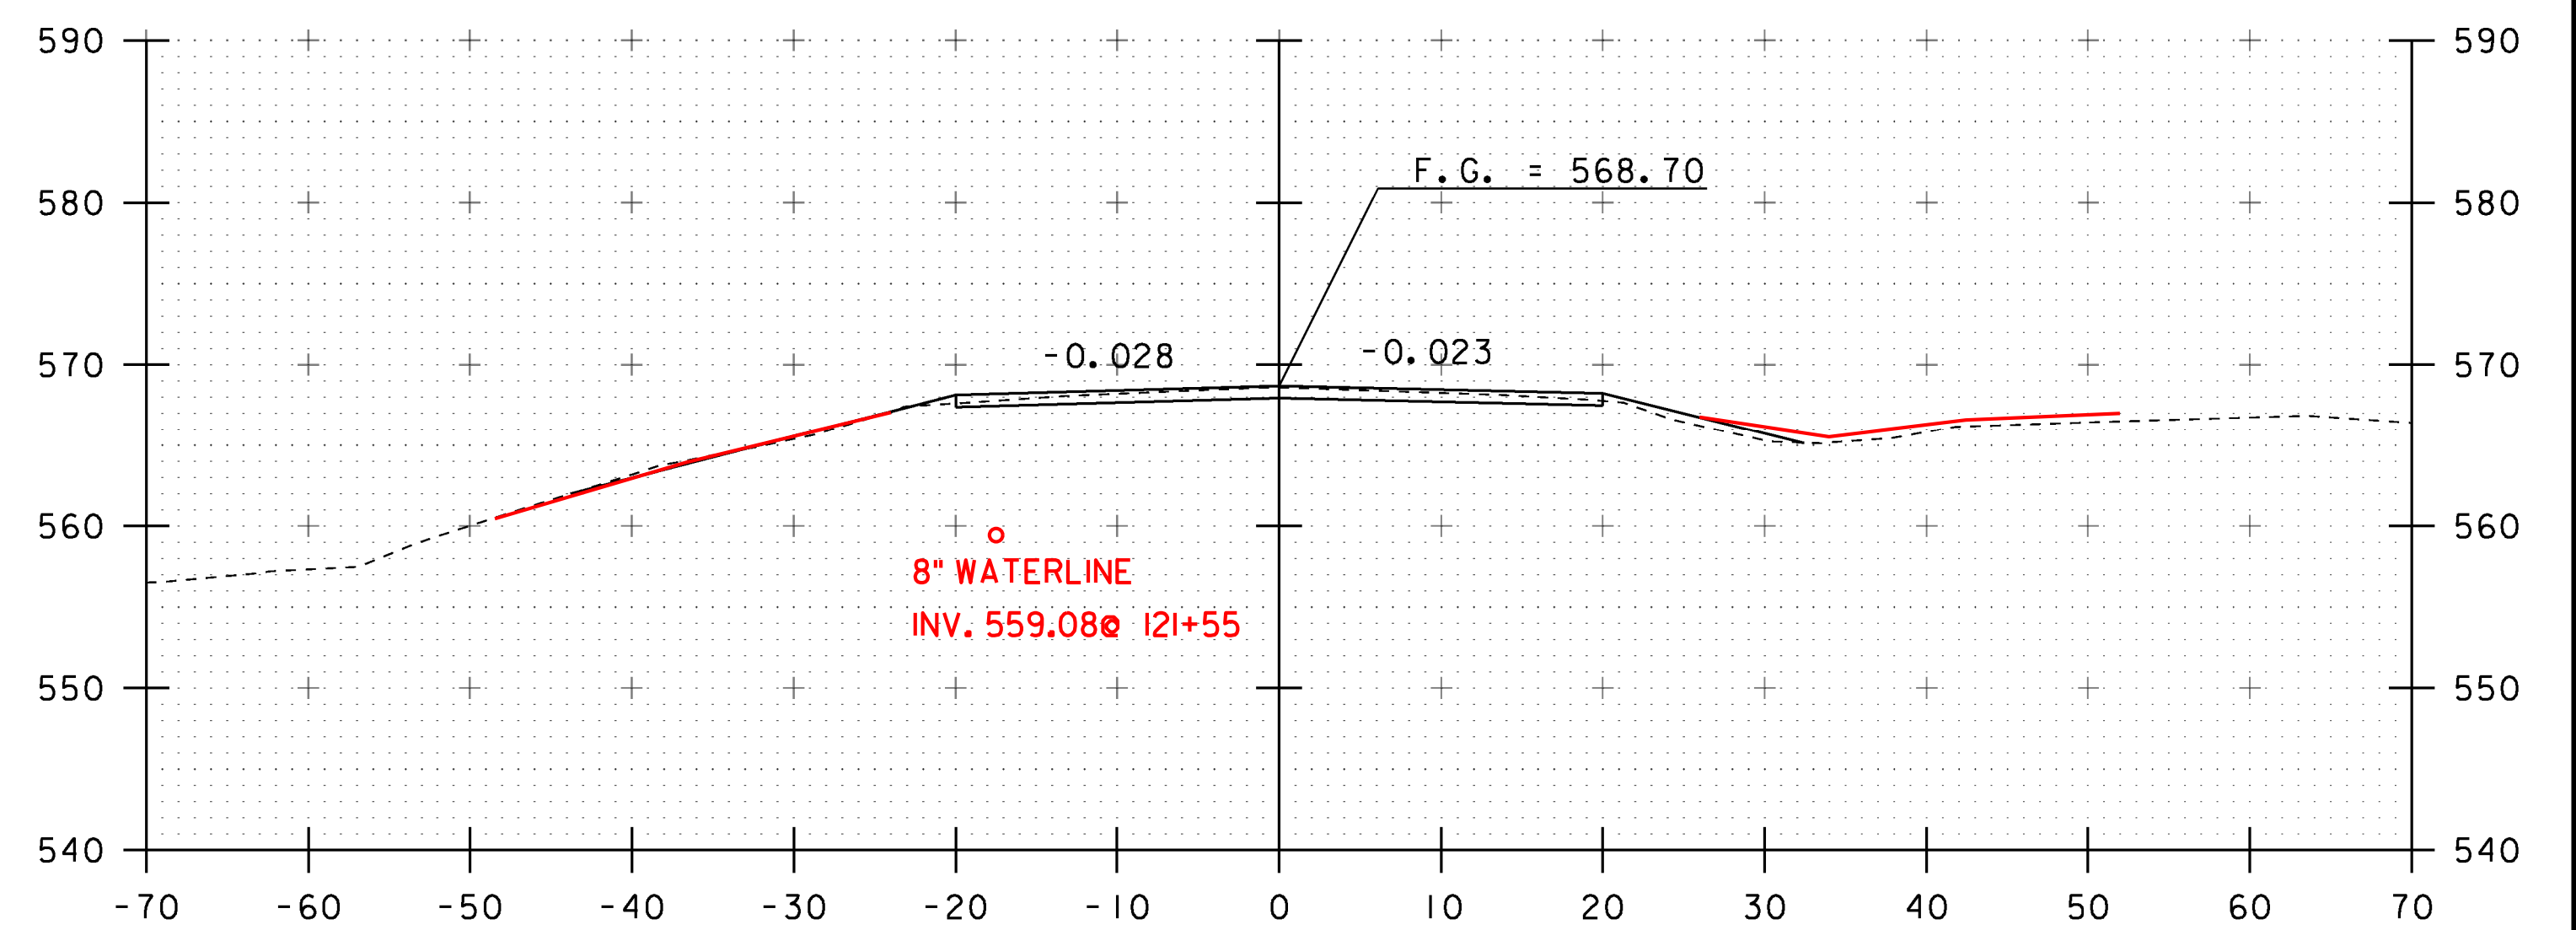

121+50

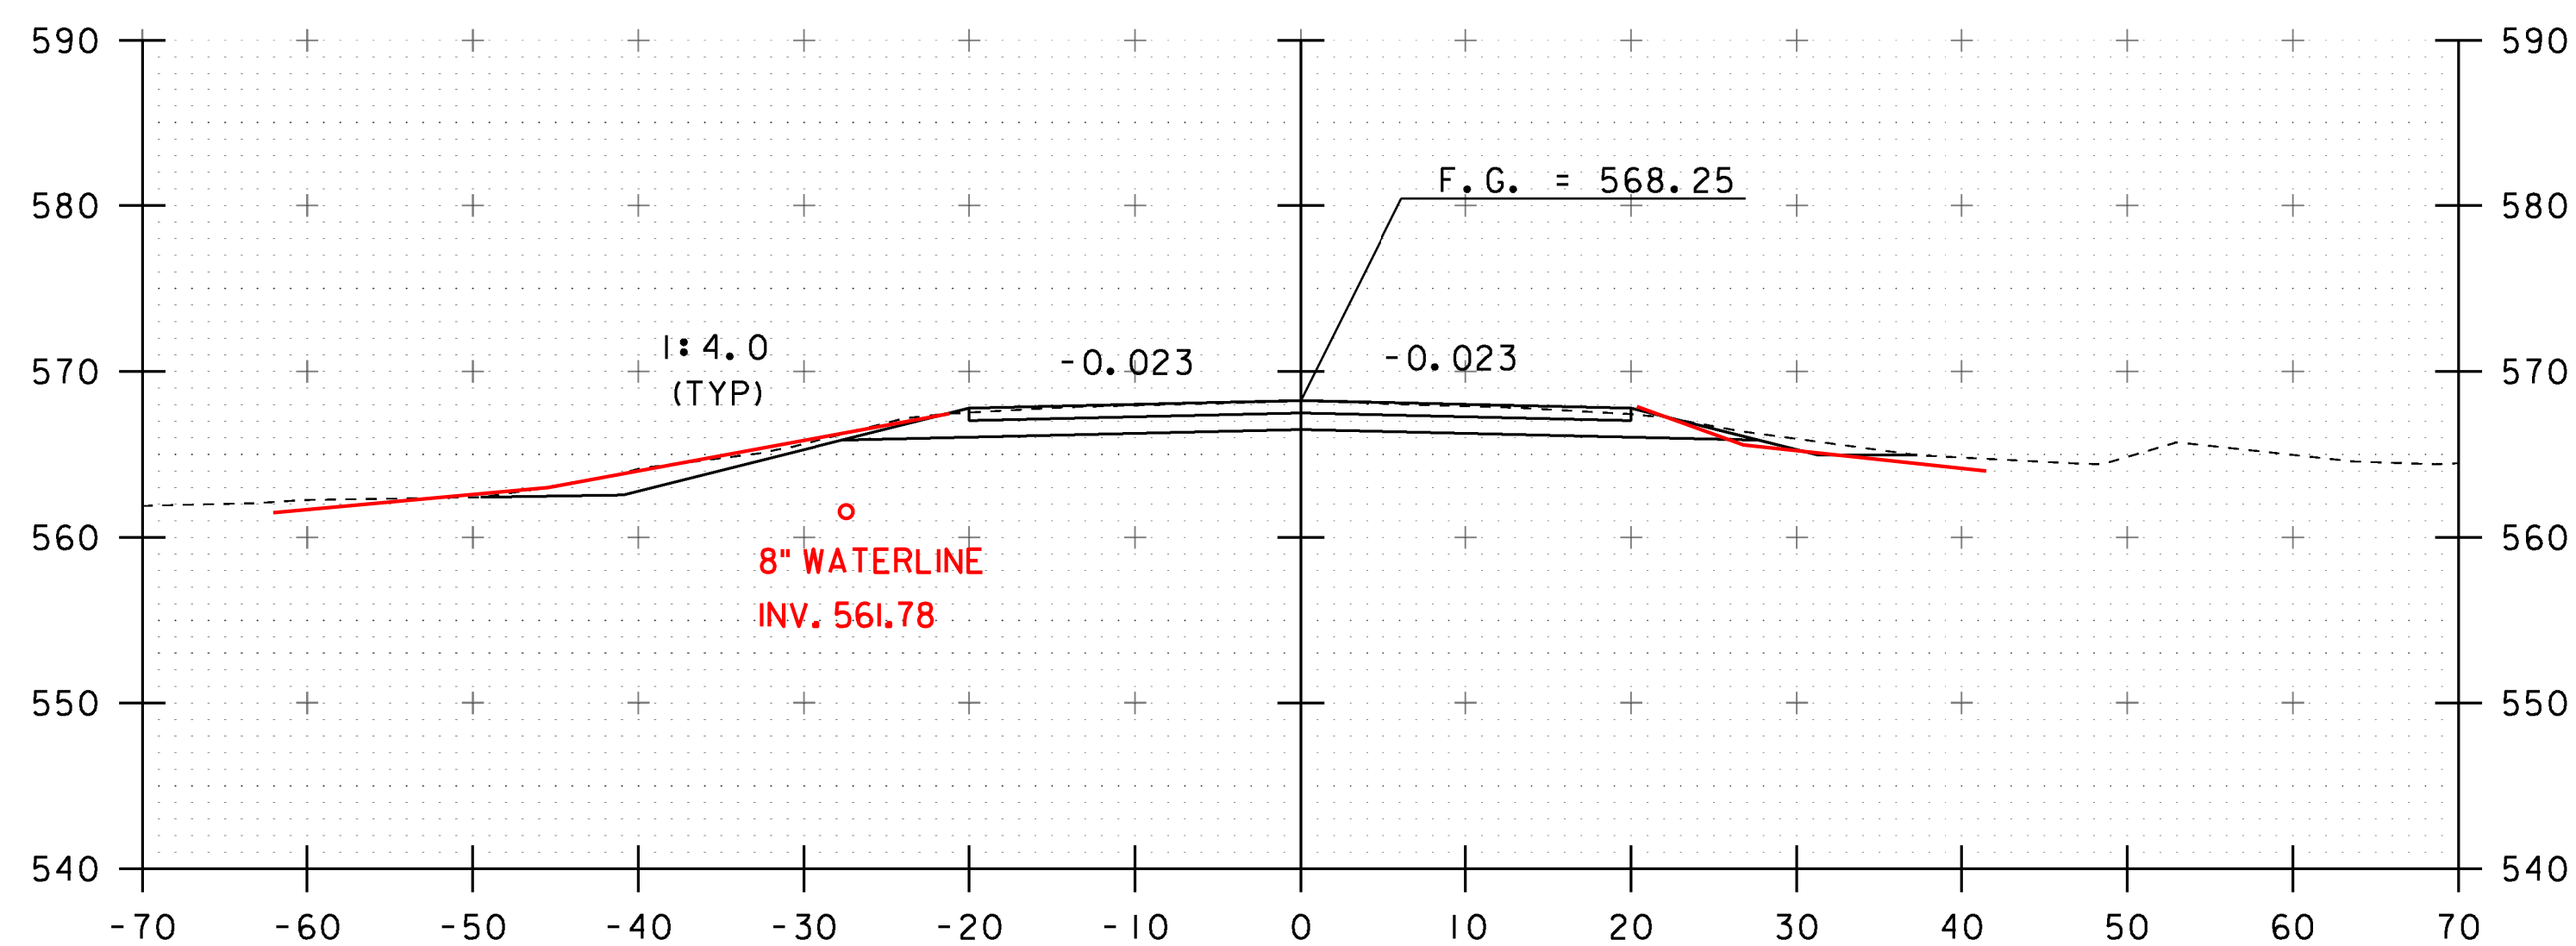

120+75
STA 120+87.50 BEGIN PROJECT

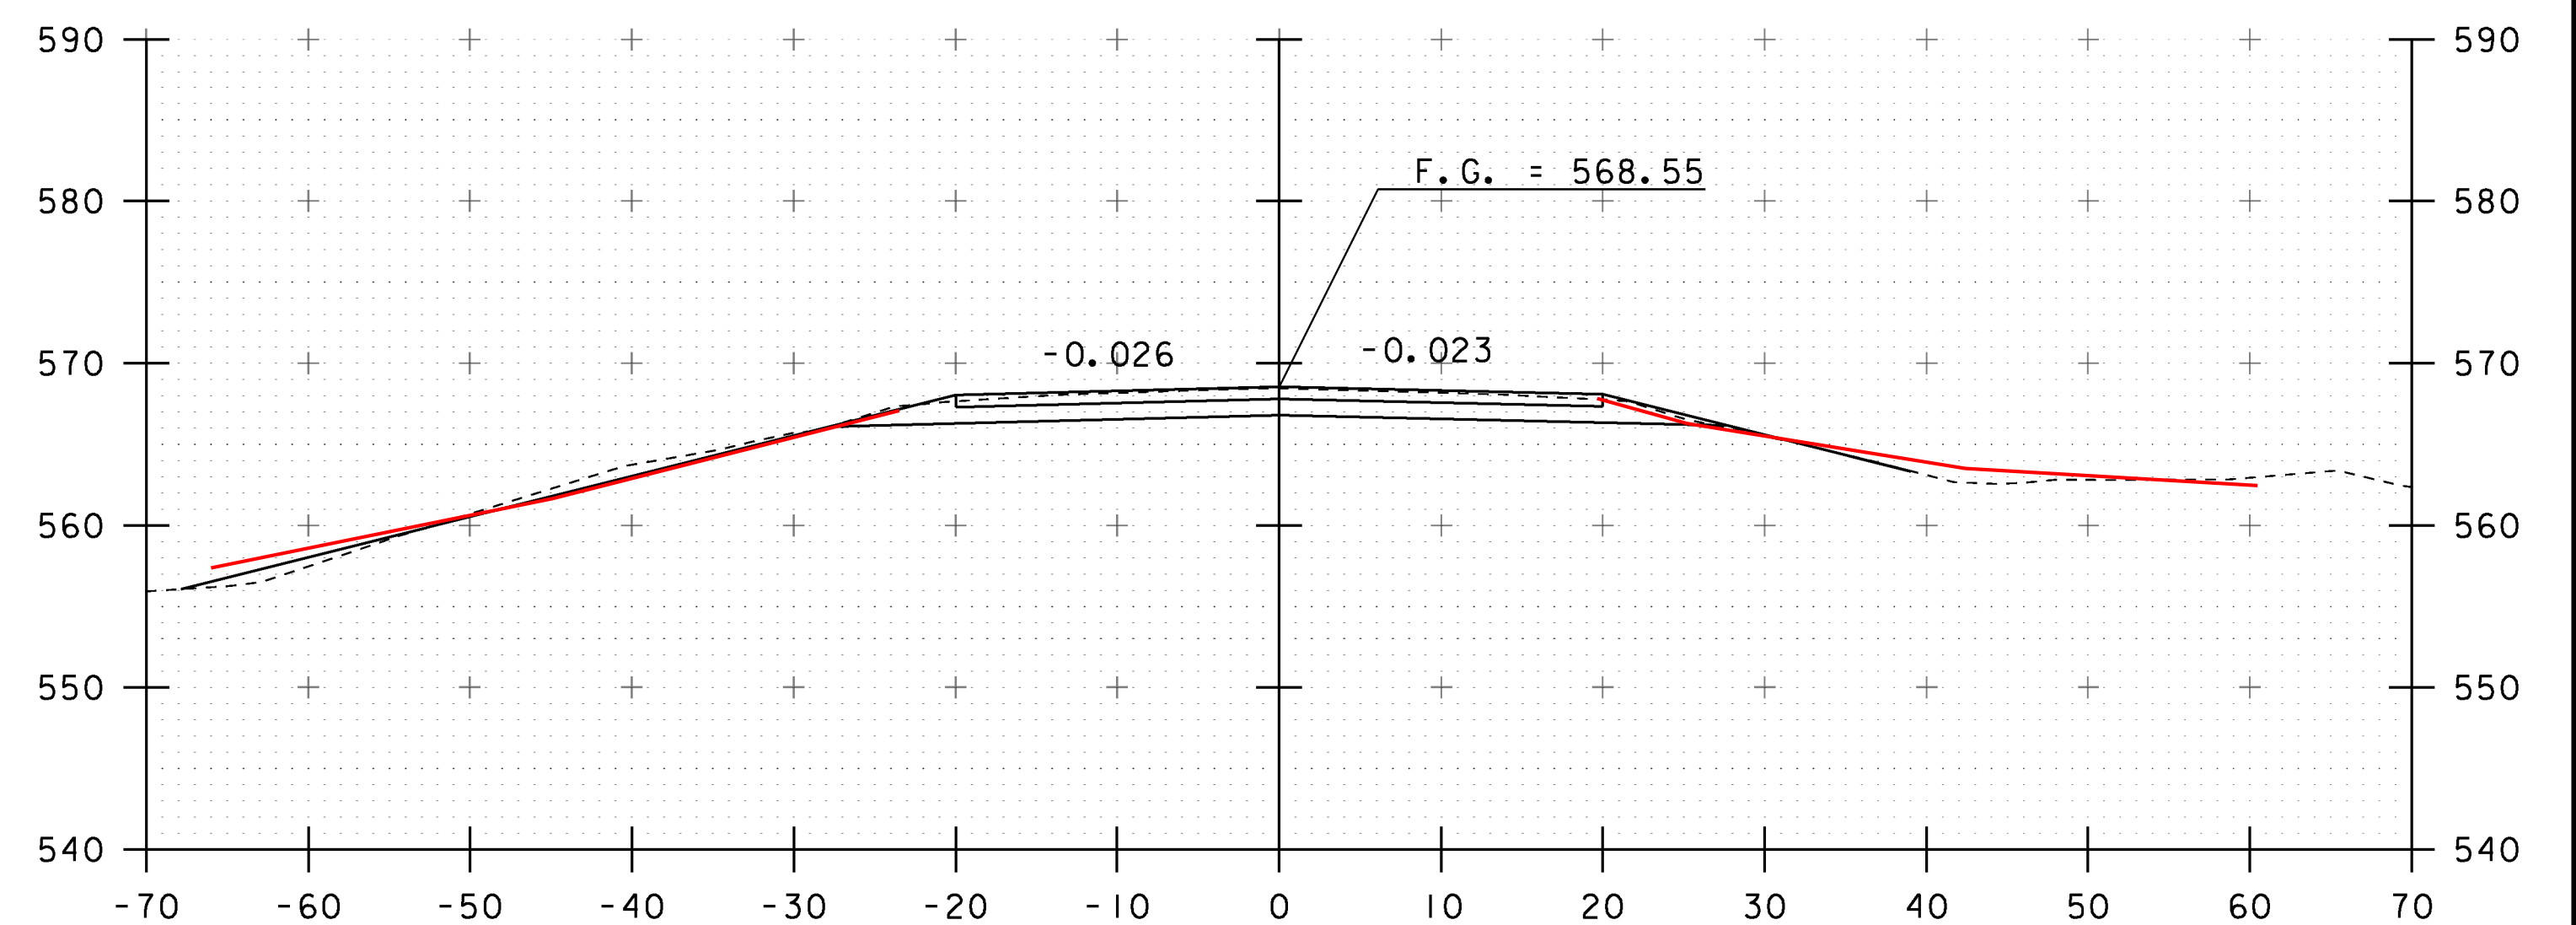

121+25

| | |
|-------------------------------|---------------------------|
| PROJECT NAME: ST. ALBANS TOWN | |
| PROJECT NUMBER: BF 0279(5) | |
| FILE NAME: s12c598xs.dgn | PLOT DATE: 10-JAN-2017 |
| PROJECT LEADER: J.B. MCCARTHY | DRAWN BY: J. SALVATORI |
| DESIGNED BY: J. SALVATORI | CHECKED BY: J.B. MCCARTHY |
| MAINLINE CROSS SECTIONS | SHEET 19 OF 29 |