


CULVERT ELEVATION
1/4" = 1'-0"

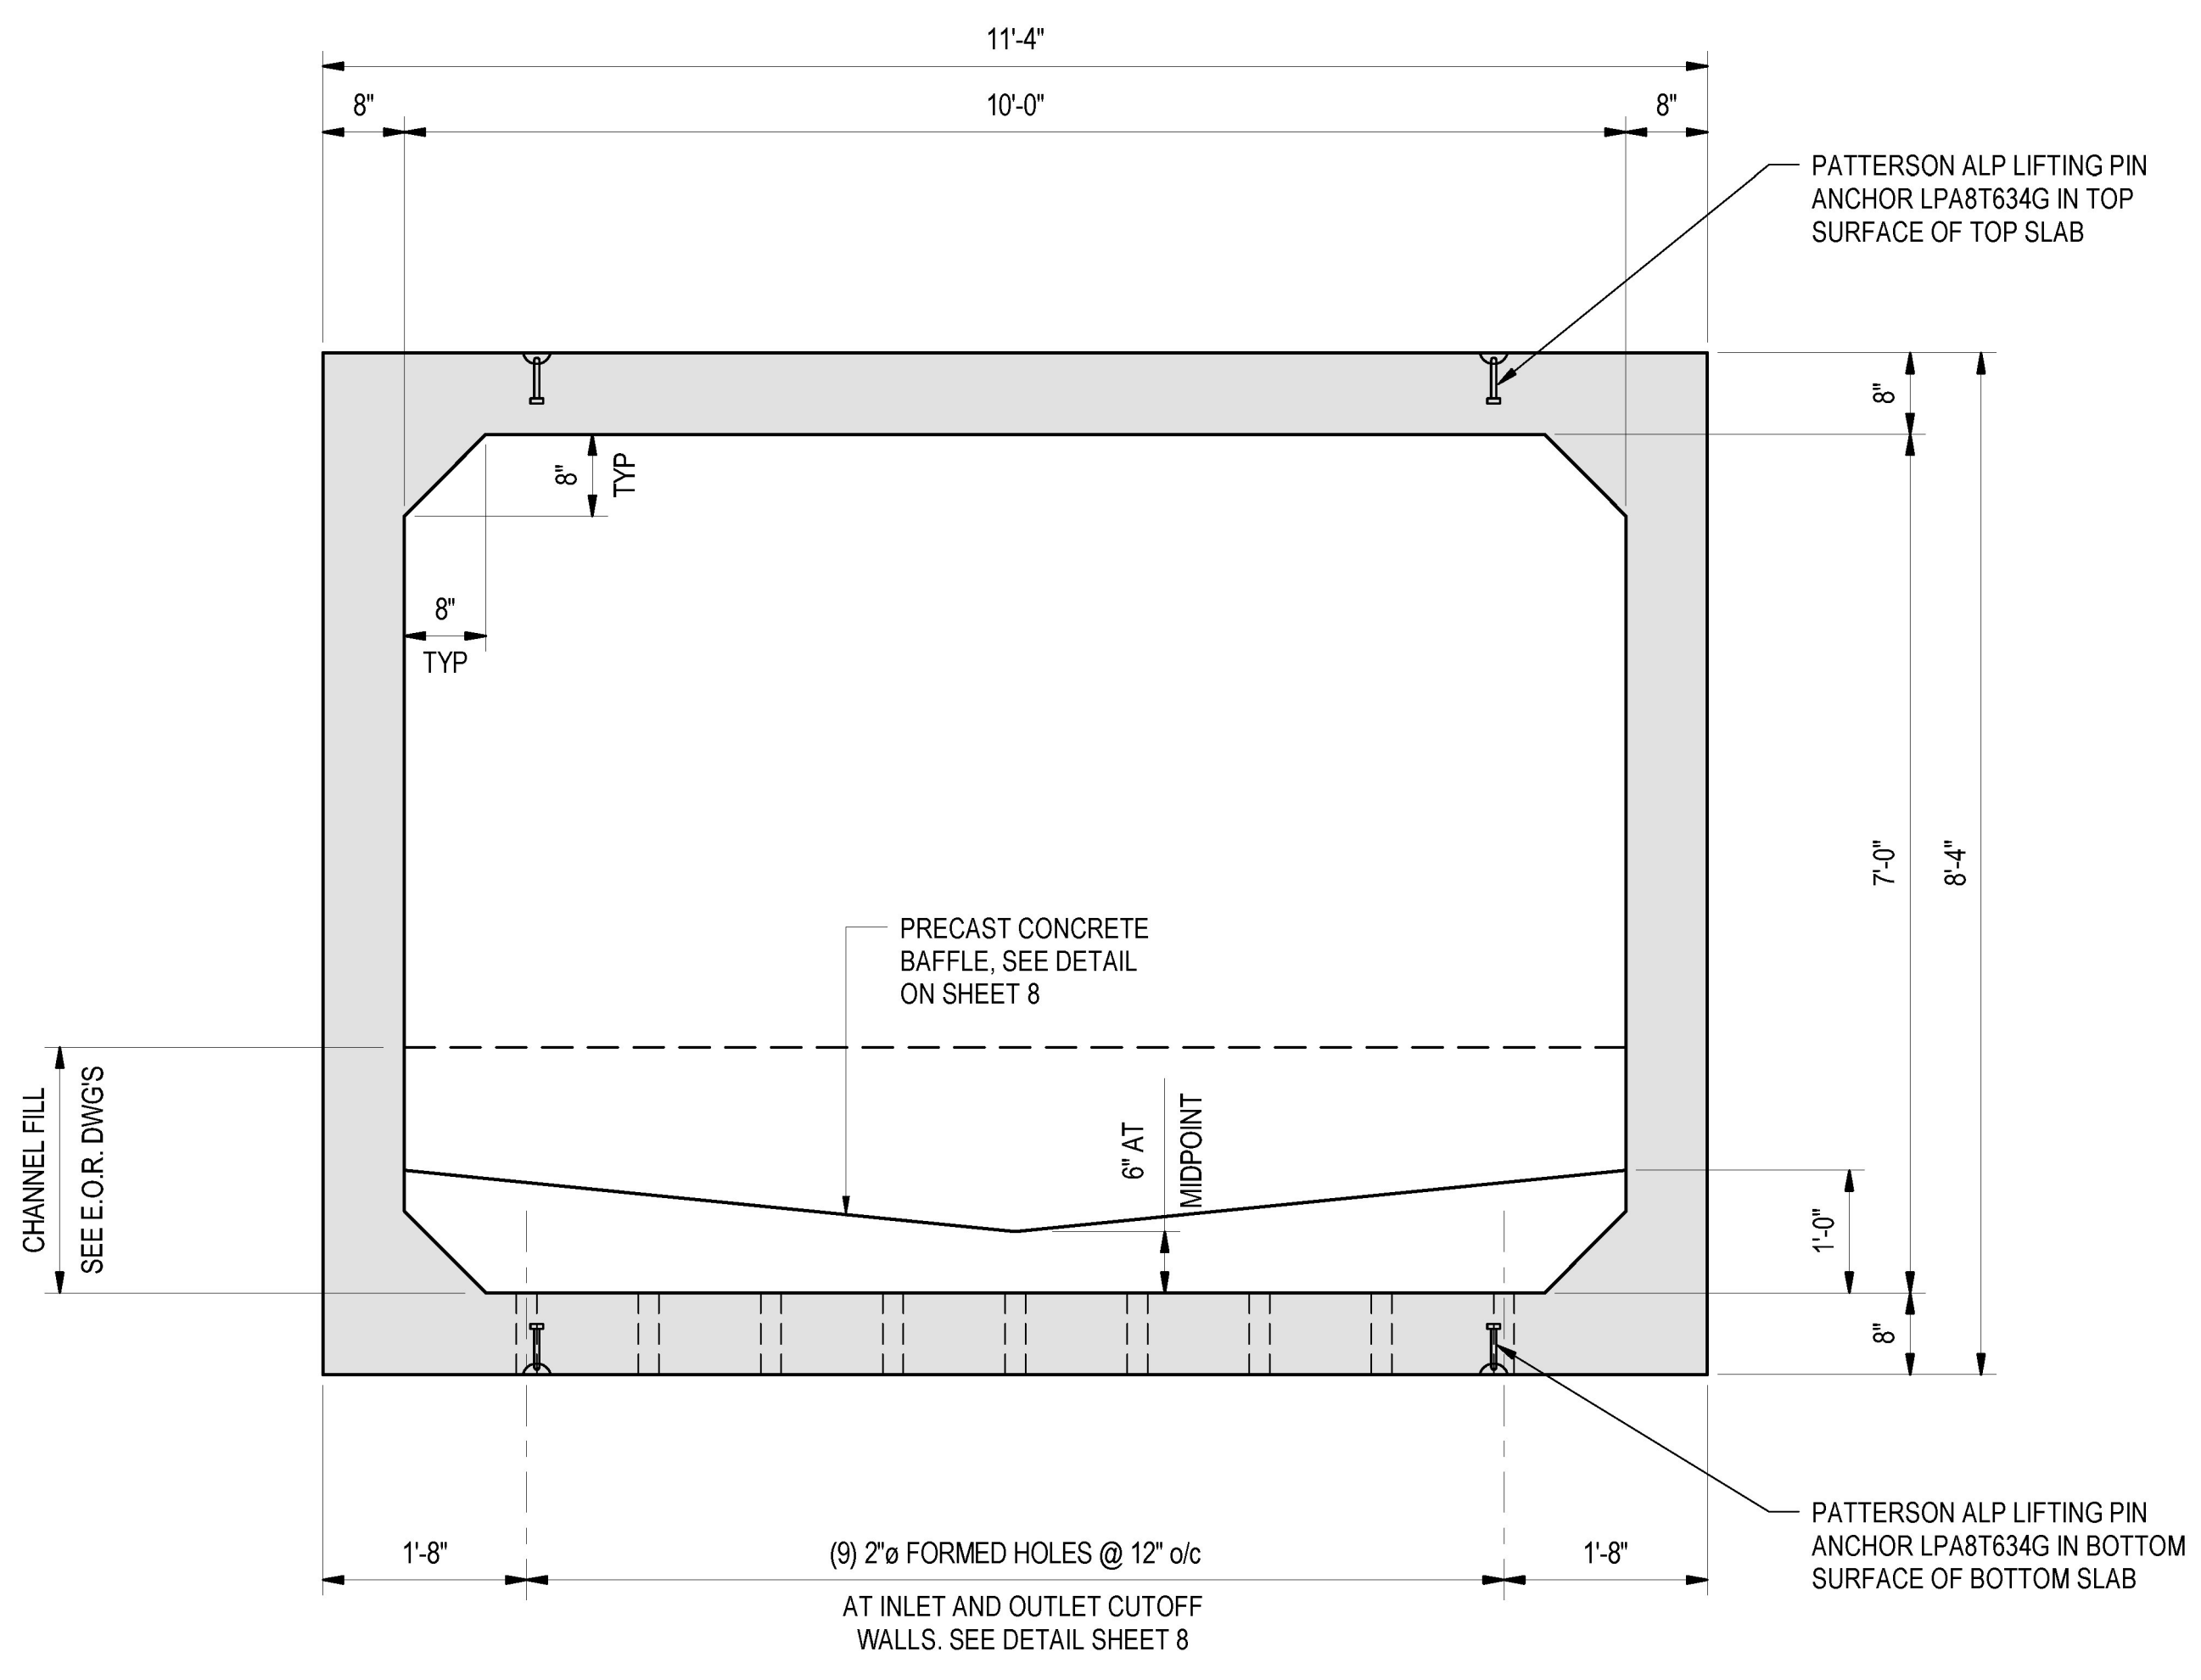

CULVERT SECTION
3/4" = 1'-0"

Date	04/26/17
Description	SUBMITTAL REVIEW COMMENTS
No.	1

ENGINEERING VENTURES PC
208 Flynn Avenue, Suite 2A, Burlington, VT 05401
tel. 802-863-6225 fax. 802-863-6306
85 Mechanic Street, Suite B2-2, Lebanon, NH 03766
tel. 603-442-9333 fax. 603-442-9331
www.engineeringventures.com

CAMP
PRECAST CONCRETE
78 PRECAST ROAD
MILTON, VT 05469
PHONE: (802) 893-2401
FAX: (802) 893-1542

Sheet Title: **CULVERT ELEVATION AND SECTION**
Project Title: **TOWN OF ST. ALBANS VT ROUTE 104, CULVERT #19**
ST. ALBANS, VERMONT

Vermont Agency of Transportation
RECEIVED
CK'D BY J. B. McCarthy OK'D BY J. B. McCarthy
May 17, 2017
RESUBMIT No Approved
BY J. B. McCarthy DATE 05/18/17

Designed By:	CPA
Checked By:	TWD
Drawn	JTM
Scale:	AS NOTED
Date:	04/04/2017

3
EV Project #17022.02