



CULVERT REINFORCING SECTION
3/4" = 1'-0"

BAR SCHEDULE							
MARK	BAR SIZE	MAX SPACING	LENGTH	TYPE	B	C	D
AS1	#5	6"	18'-0"	BENT	5'-0"	8'-0"	5'-0"
AS2	#6	4"	10'-8"	STR			
AS3	#6	4"	10'-8"	STR			
AS4	#4	12"	7'-8"	STR			
AS5	#4	18"	VARIES	STR			
AS6	#4	18"	VARIES	STR			
AS7	#4	18"	11'-0"	STR			
AS8	#4	18"	11'-0"	STR			
C1	#4	18"	VARIES	STR			

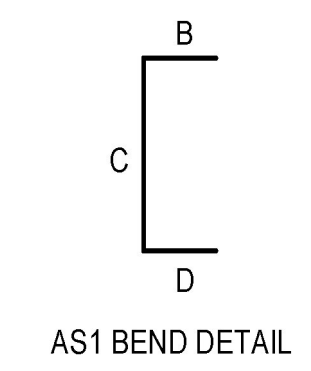

AS1 BEND DETAIL

Vermont Agency of Transportation
RECEIVED
St Albans_Box_Culvert_Drawings submittal 02_17_17.pdf
CK'D BY J. B. McCarthy OK'D BY J. B. McCarthy
May 17, 2017
RESUBMIT No Approved
BY J. B. McCarthy DATE 05/18/17

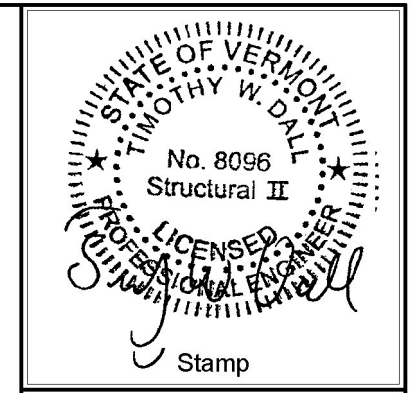

Date	
Description	
No.	

ENGINEERING VENTURES PC
 208 Flynn Avenue, Suite 2A, Burlington, VT 05401
 tel. 802-863-6225 fax. 802-863-6306
 85 Mechanic Street, Suite B2-2, Lebanon, NH 03766
 tel. 603-442-9333 fax. 603-442-9331
 www.engineeringventures.com

CAMP
 PRECAST CONCRETE
 78 PRECAST ROAD
 WILTON, VT 05499
 PHONE: (802) 893-2401
 FAX: (802) 893-1542

Sheet Title: **CULVERT REINFORCING SECTION**
 Project Title: **TOWN OF ST. ALBANS VT ROUTE 104, CULVERT #19**
ST. ALBANS, VERMONT

Designed By:	CPA
Checked By:	TWD
Drawn:	JTM
Scale:	AS NOTED
Date:	04/04/2017

4