


**ROUTE 2A STA 105+14
LOOKING NORTHERLY**

NOTES:

1. SIGNAL HEADS SHOULD BE MOUNTED OVER CENTER OF APPROACH LANE AND MAINTAIN AN 8 FOOT MINIMUM HORIZONTAL SPACING TO ADJACENT HEAD UNLESS OTHERWISE NOTED ABOVE.

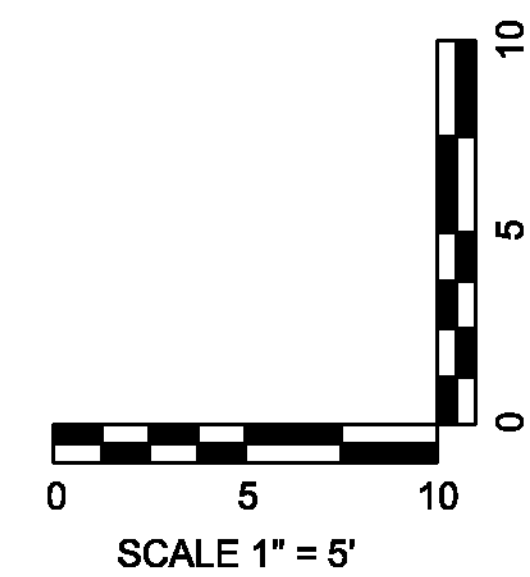

PROJECT NAME: **ESSEX**
PROJECT NUMBER: **STPG SGNL(41)**

FILE NAME: ...plotfiles\signal x-section.dgn
PROJECT LEADER: T. LUTHER
DESIGNED BY: D. DEBAIE
CROSS SECTION XS-1

PLOT DATE: 7/10/2012
DRAWN BY: C. GENDRON
CHECKED BY: T. LUTHER
SHEET 6 OF 9

