
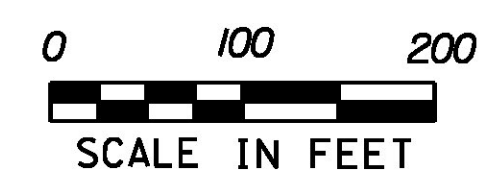
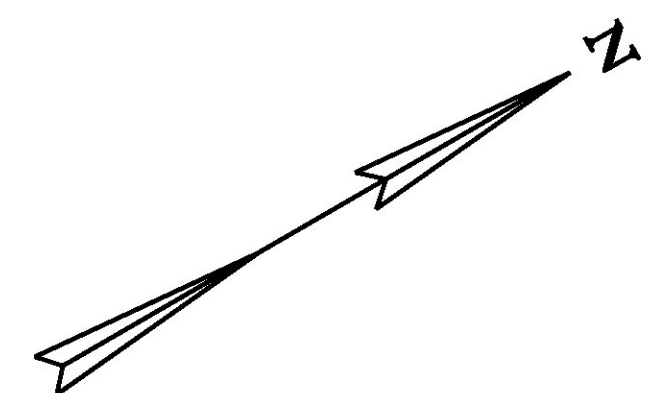


FILE NAME = I:\2012\30\ACADD\MSTN\12E008\_gp\_01.dgn  
 DATE/TIME = 7/12/2012  
 USER = 4666

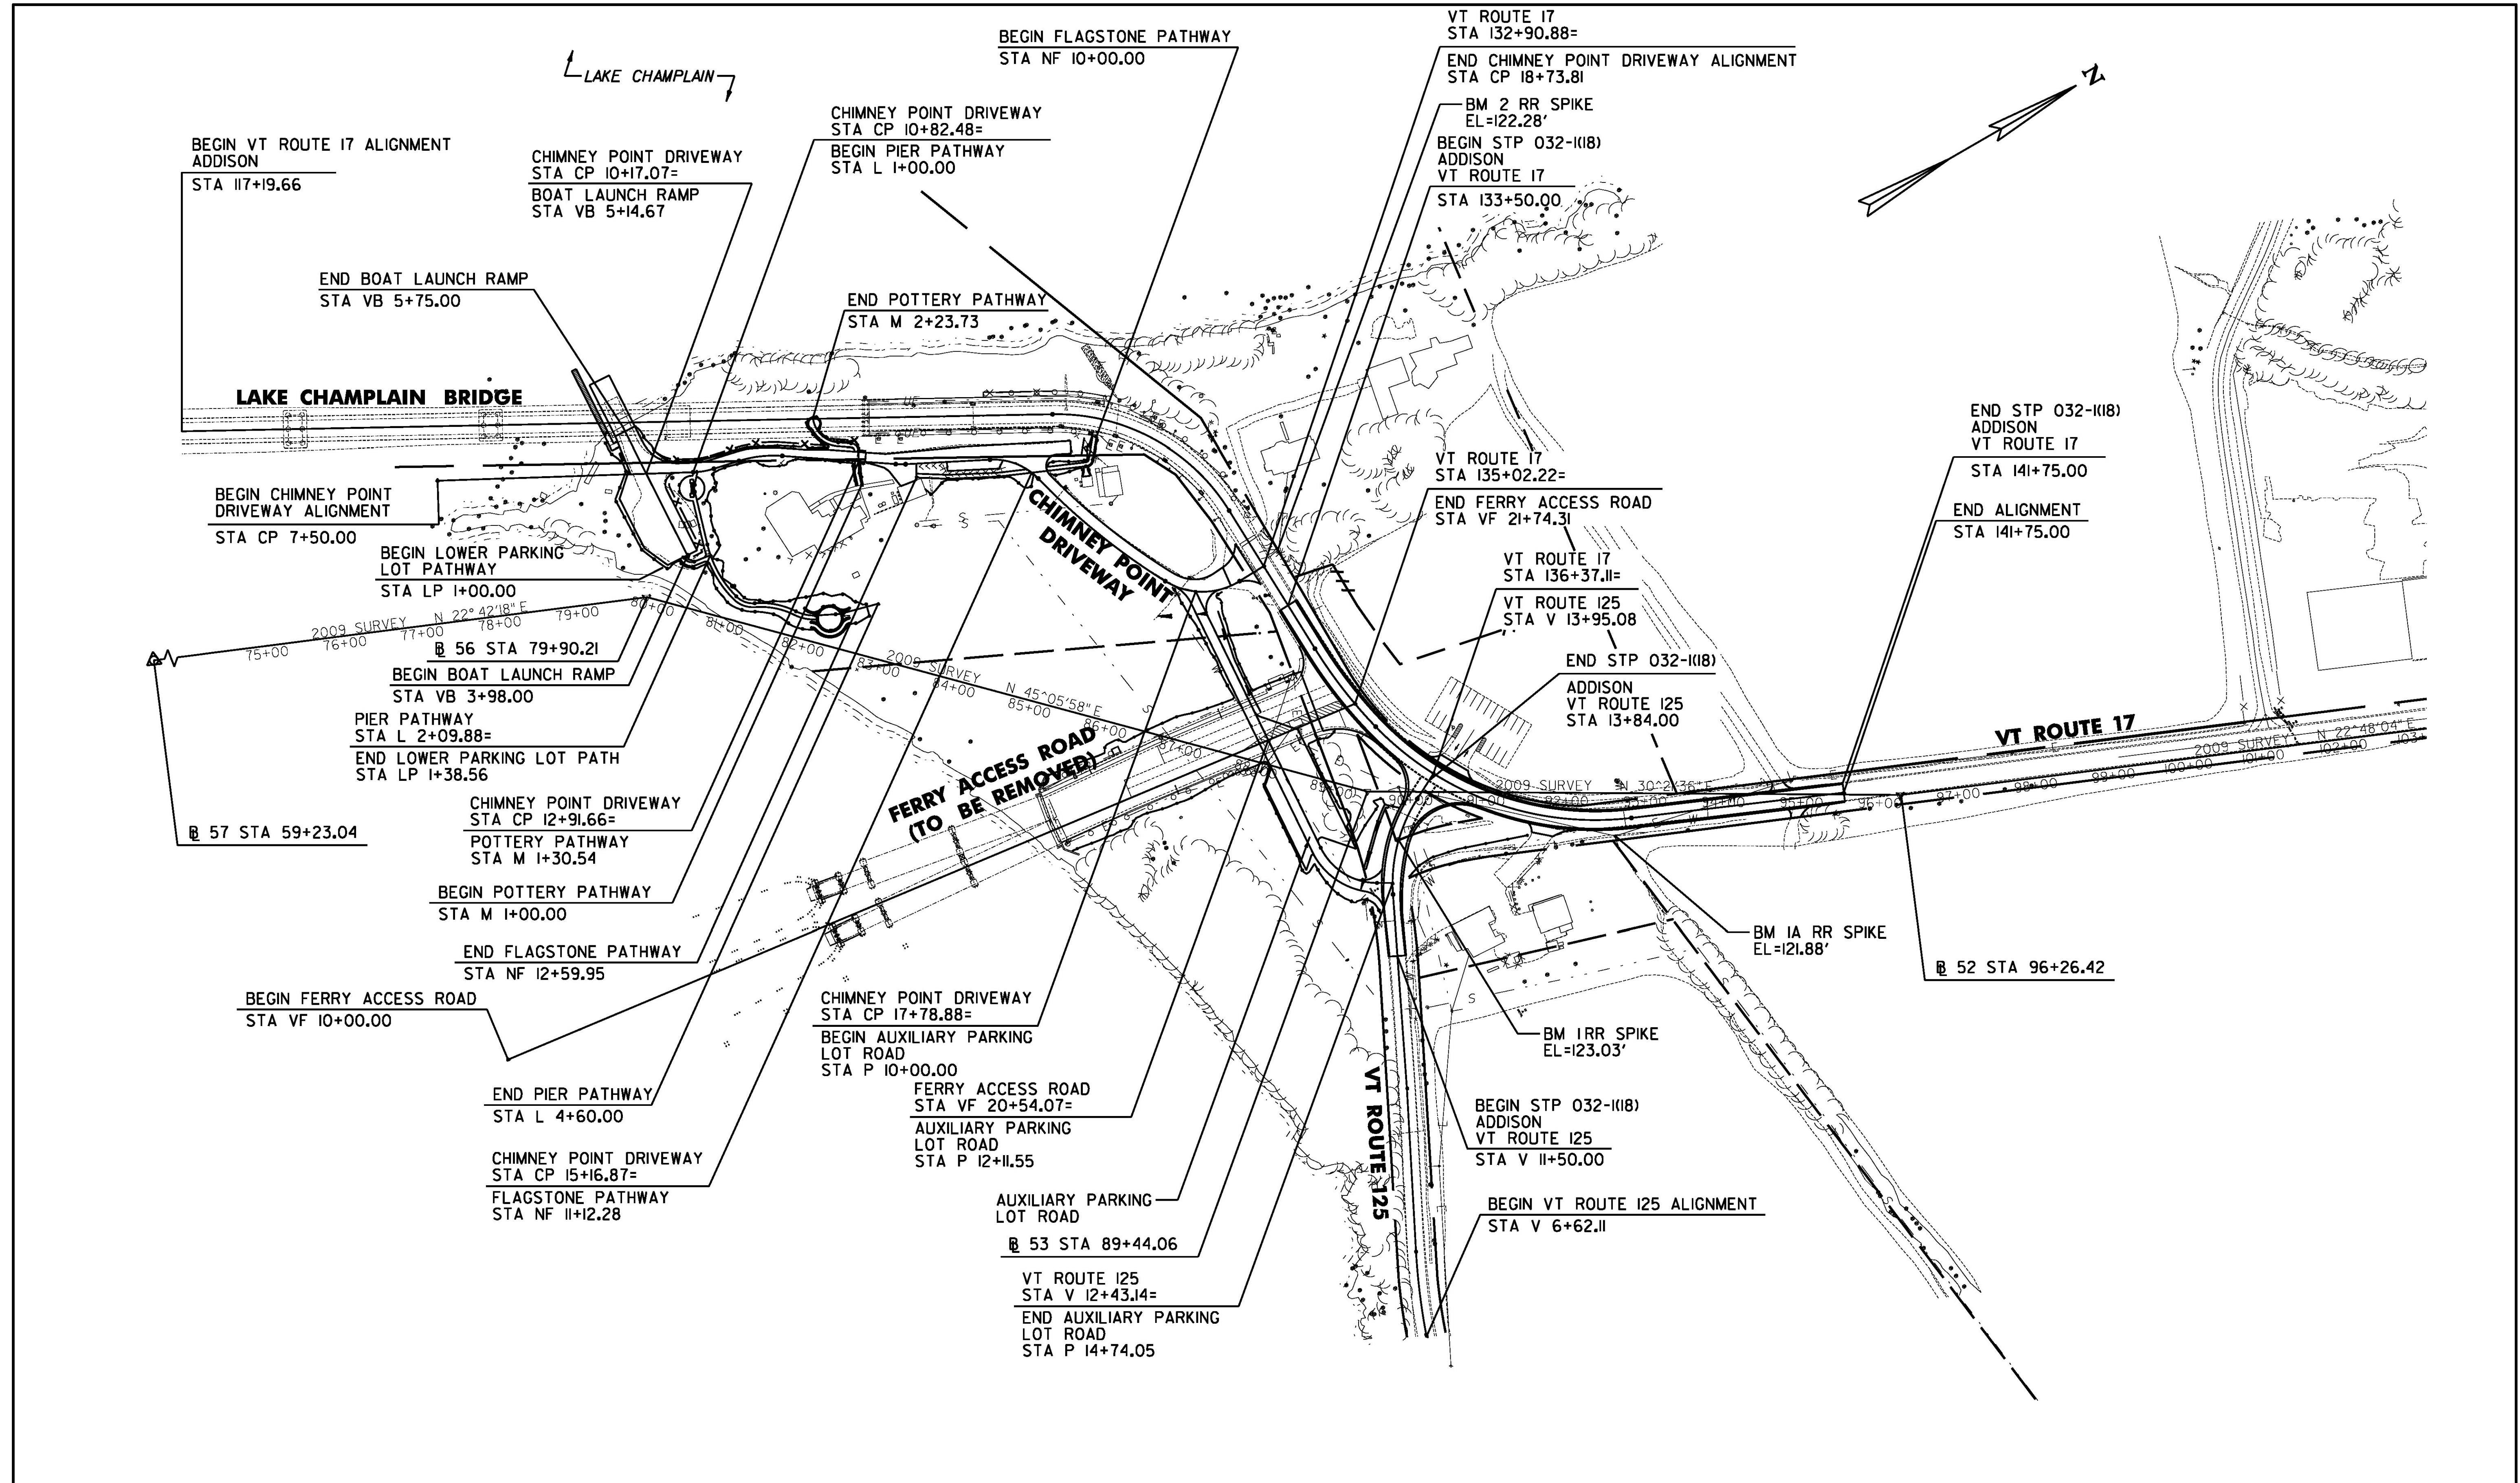

<b>GENERAL PLAN</b>	PROJECT NAME: LAKE CHAMPLAIN SITE RESTORATION	PLOT DATE: 7/12/2012
	PROJECT NUMBER: STP 032-I(18)	DRAWN BY: W.G.P.
	FILE NAME: z12E008_gp_01.dgn	DESIGNED BY: B.T.H.
	DWG. NO.: GP-1	CHECKED BY: D.E.G.
		SHEET 15 OF 100