

N/F  
KAYHART

AGRICULTURAL FIELD

END STP 032-(118)  
ADDISON  
VT ROUTE 17  
MM 0.465 = STA 141+75.00

STA 141+50.00  
BEGIN LT & RT SHOULDER TAPER

STA 141+75.00  
END LT & RT SHOULDER TAPER

NOTE:


1. LOCATION OF UTILITIES, PUBLIC AND/OR PRIVATE, INDICATED ON THE PLANS AS EXISTING AND/OR TO BE CONSTRUCTED ARE APPROXIMATE ONLY. THEIR EXACT LOCATIONS SHALL BE DETERMINED IN THE FIELD. ADDITIONAL UTILITY LINES, WHETHER ABANDONED OR IN SERVICE, MAY EXIST AND IT SHALL BE THE CONTRACTOR'S RESPONSIBILITY TO CONDUCT HIS OPERATIONS AND TAKE NECESSARY PRECAUTIONS SUCH THAT INTERFERENCE WITH OR DAMAGE TO THESE OR OTHER FACILITIES DURING THE COURSE OF CONSTRUCTION IS PREVENTED. PRIOR TO ANY EXCAVATION, THE CONTRACTOR IS TO CALL DIG SAFELY VERMONT AT 1-888-344-7233 TO HAVE UNDERGROUND UTILITIES LOCATED.

**CURVE 5**

$\Delta = 52^{\circ}52'04''$   
 $D = 141'28''$   
 $R = 390.00'$   
 $T = 193.89'$   
 $L = 359.86'$   
 $E = 45.54'$

601.995 CLEANING CULV. PIPE, IN-PLACE (0 TO 24 IN., INCL.)  
 ADDISON:  
 STA 137+63.0 - STA 138+07.0 RT (52.0 LF)  
 STA 140+80.0 - STA 141+09.0 LT (30.0 LF)

900.675 SPECIAL PROVISION (HAND PLACED BITUMINOUS CONCRETE MATERIAL, DRIVES)  
 ADDISON:  
 STA 137+91.0 RT (48.8 SY)  
 STA 140+91.0 LT (24.6 SY)  
 STA 141+10.0 RT (22.7 SY)

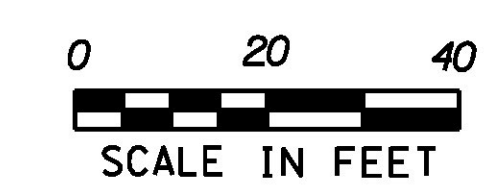

<b>PROJECT LAYOUT SHEET #4</b>	PROJECT NAME: LAKE CHAMPLAIN SITE RESTORATION	PLOT DATE: 7/12/2012
	PROJECT NUMBER: STP 032-(118)	DRAWN BY: W.G.P.
	FILE NAME: z12E008.L.04.dgn	CHECKED BY: D.E.G.
	DESIGNED BY: B.T.H.	SHEET 21 OF 100
	DWG. NO.: P-4	

FILE NAME = I:\A\2012\30\ACADD\MSTIN\z12E008.L.04.dgn  
 DATE/TIME = 7/12/2012  
 USER = 4666