


**CHIMNEY POINT DRIVEWAY**

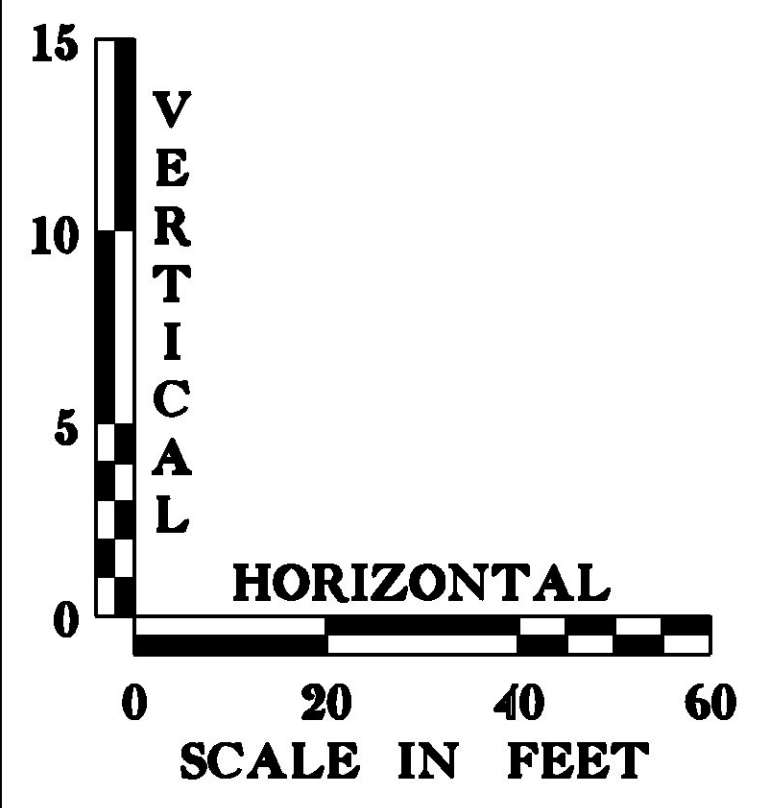

THE GRADES SHOWN TO THE NEAREST TENTH ARE THE ORIGINAL GROUND ELEVATIONS ALONG THE PROPOSED ALIGNMENT. THE GRADES SHOWN TO THE NEAREST HUNDREDTH ARE THE PROPOSED PROFILE GRADES FOR THE NEW ALIGNMENT.

**PROFILE SHEET #2**

PROJECT NAME: LAKE CHAMPLAIN SITE RESTORATION	
PROJECT NUMBER: STP 032-K(18)	
FILE NAME: z12E008_pro_02.dgn	PLOT DATE: 7/12/2012
PROJECT LEADER: D.E.G.	DRAWN BY: W.G.P.
DESIGNED BY: B.T.H.	CHECKED BY: D.E.G.
DWG. NO.: PRO-2	SHEET 24 OF 100

FILE NAME: I:\A\2012\30\ACADD\MSTN\z12E008\_pro\_02.dgn  
DATE/TIME: 7/12/2012  
USER: 4666