


**AUXILIARY PARKING LOT ROAD**

FILE NAME: I:\A\2012\30\ACADD\MSTN\212E008\_pro\_03.dgn  
 DATE/TIME: 7/12/2012  
 USER: 4666

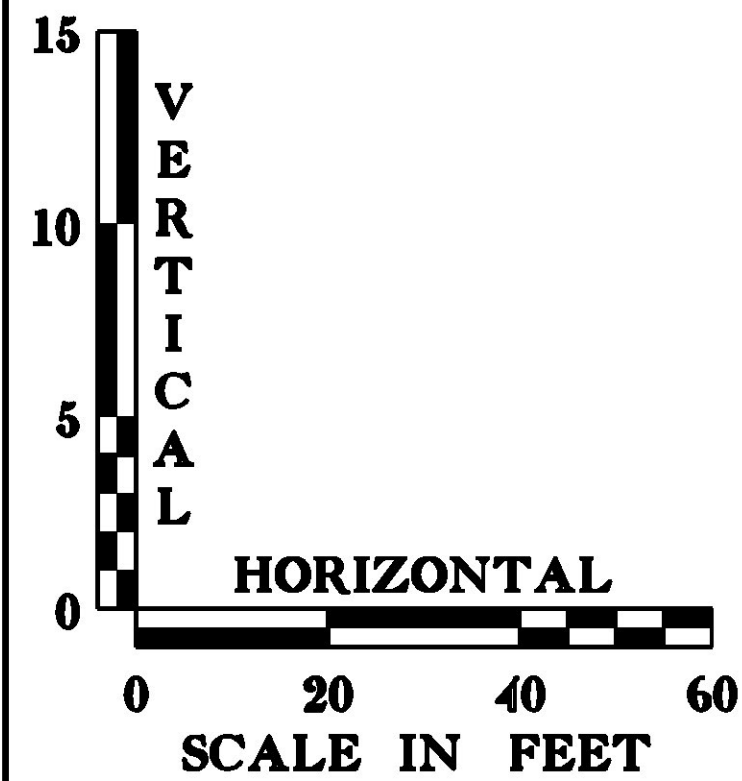

THE GRADES SHOWN TO THE NEAREST TENTH ARE THE ORIGINAL GROUND ELEVATIONS ALONG THE PROPOSED ALIGNMENT. THE GRADES SHOWN TO THE NEAREST HUNDRETH ARE THE PROPOSED PROFILE GRADES FOR THE NEW ALIGNMENT.

**PROFILE SHEET #3**

PROJECT NAME: LAKE CHAMPLAIN SITE RESTORATION	PLOT DATE: 7/12/2012
PROJECT NUMBER: STP 032-1(18)	DRAWN BY: W.G.P.
FILE NAME: z12E008_pro_03.dgn	DESIGNED BY: B.T.H.
PROJECT LEADER: D.E.G.	CHECKED BY: D.E.G.
DWG. NO.: PRO-3	SHEET 25 OF 100