

**653.20 TEMPORARY EROSION MATTING**  
 ADDISON:  
 STA CP 11+52.0 - STA CP 12+14.0, RT (55.1 SY)


**653.60 EROSION LOG**  
 ADDISON:  
 STA VB 5+68.0 - STA VB 5+77.0, LT (16.0 LF)  
 STA VB 5+48.0 - STA VB 5+61.0, LT (18.0 LF)  
 STA L 1+16.0 - STA L 4+54.0, RT (469.5 LF)  
 STA VB 5+25.0 - STA VB 5+74.0, RT (59.0 LF)  
 STA VB 5+12.0 - STA VB 5+31.0, RT (21.0 LF)  
 STA 126+04.0 - STA 126+09.0, RT (44.0 LF)  
 STA 126+19.0 - STA 126+38.0, LT (19.0 LF)

**653.50 BARRIER FENCE**  
 ADDISON:  
 STA CP 10+21.0 - STA CP 12+75.0, LT (323 LF)  
 STA VB 4+40.0 - STA VB 5+65.0, LT (132 LF)  
 STA L 1+87.4 - STA L 4+60.0, RT (376 LF)  
 STA L 4+60.0 RT - STA L 4+52.5, LT (75 LF)  
 STA L 1+73.1 - STA L 4+52.5, LT (250 LF)

**653.55 PROJECT DEMARCATION FENCE**  
 ADDISON:  
 STA L 1+03.3 - STA L 1+73.1, LT (55 LF)  
 STA CP 11+12.6 - STA CP 12+75.0, RT (174 LF)

**EROSION LOG (TYP)**  
 PIER PATHWAY  
 STA L 2+09.88=  
 LOWER PARKING LOT PATH  
 STA LP 1+38.56

LEGEND	
SYMBOL	DESCRIPTION
	PROJECT DEMARCATION FENCE
	BARRIER FENCE
	FIBER ROLL (EROSION LOG)
	SURFACE ROUGHENING
	ROLLED EROSION CONTROL PRODUCT

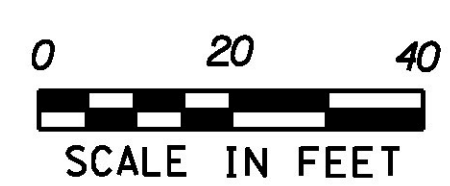

**EROSION CONTROL PLAN SHEET #1**

PROJECT NAME: LAKE CHAMPLAIN SITE RESTORATION  
 PROJECT NUMBER: STP 032-118)  
 FILE NAME: z12E008\_ero\_01.dgn  
 PROJECT LEADER: D.E.G.  
 DESIGNED BY: B.T.H.  
 DWG. NO.: EC-1

PLOT DATE: 7/12/2012  
 DRAWN BY: W.G.P.  
 CHECKED BY: D.E.G.  
 SHEET 35 OF 100

FILE NAME = I:\A\2012\30\CA\DWG\MSTIN\z12E008\_ero\_01.dgn  
 DATE/TIME = 7/12/2012 10:46:56  
 USER = 4666