

VT ROUTE 17
 STA 132+90.88 =
 CHIMNEY POINT DRIVEWAY
 STA CP 18+73.81

VT ROUTE 17
 STA 136+37.11 =
 VT ROUTE 125
 STA V 13+95.08

VT ROUTE 17
 STA 135+02.22 =
 FERRY ACCESS ROAD
 STA VF 21+74.32

BEGIN STP 032-I(18)
 ADDISON
 VT ROUTE 17
 MM 0.309 = STA 133+50.00

(TYP)
 TEST PIT

VT ROUTE 17

STATE OF VERMONT
 HWY. EASE. V26 P342
 40' 1929

COTTONWOOD ON
 LAKE CHAMPLAIN, LLC
 (FRANKLIN, DANA G.
 & LORRAINE A.)

VT ROUTE 125
 STA V 12+43.14 =
 AUXILIARY PARKING
 LOT ROAD
 STA P 14+74.05



CLOUTIER,
 LISA A.

STATE OF VERMONT
 AGENCY OF NATURAL RESOURCES
 DEPT. OF FORESTS, PARKS &
 RECREATION

CHIMNEY POINT DRIVEWAY
 STA CP 17+78.88 =
 AUXILIARY PARKING LOT ROAD
 STA P 10+00.00

FERRY ACCESS ROAD
 STA VF 20+54.07 =
 AUXILIARY PARKING LOT ROAD
 STA P 12+11.55

BEGIN STP 032-I(18)
 ADDISON
 VT ROUTE 125
 MM 0.218 = STA V 11+50.00

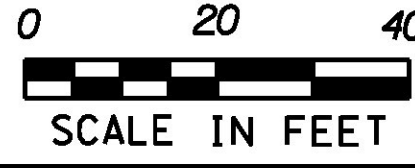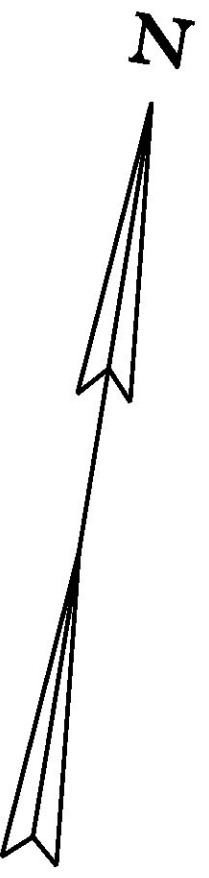

EROSION CONTROL FINAL CONDITIONS SHEET #3	PROJECT NAME: LAKE CHAMPLAIN SITE RESTORATION	PLOT DATE: 7/12/2012
	PROJECT NUMBER: STP 032-I(18)	DRAWN BY: W.G.P.
	FILE NAME: z12E008_ero_fc.03.dgn	DESIGNED BY: B.T.H.
	PROJECT LEADER: D.E.G.	CHECKED BY: D.E.G.
	DWG. NO.: FC-3	SHEET 42 OF 100

FILE NAME = I:\A\2012\30\ACADD\MSTN\z12E008_ero_fc.03.dgn
 DATE/TIME = 7/12/2012
 USER = 4666