


FILE NAME = I:\A\2023\30\ACADD\MSTN\z12E008\_ero\_fc\_04.dgn  
DATE/TIME = 7/12/2012  
USER = 4666

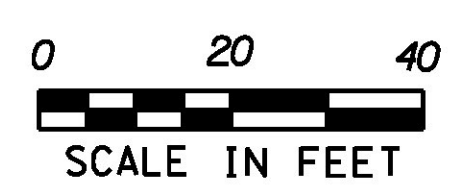

<b>EROSION CONTROL FINAL CONDITIONS SHEET #4</b>	PROJECT NAME: LAKE CHAMPLAIN SITE RESTORATION	PLOT DATE: 7/12/2012
	PROJECT NUMBER: STP 032-I(18)	DRAWN BY: W.G.P.
	FILE NAME: z12E008_ero_fc_04.dgn	CHECKED BY: D.E.G.
	DESIGNED BY: B.T.H.	SHEET 43 OF 100
	DWG. NO.: FC-4	