


FILE NAME = I:\A\202\30\ACADD\MSTN\12\2008.ssp\_01.dgn  
 DATE/TIME = 7/12/2012  
 USER = 4666

- SIGN LEGEND**
- R = REMOVE
  - S = SALVAGE
  - N = NEW
  - RET = RETAIN
  - B-B = BACK TO BACK
  - EXISTING =
  - NEW =

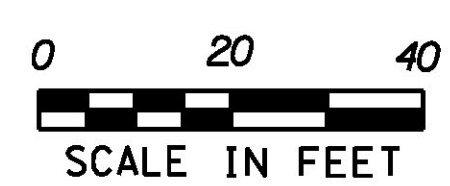

<b>SIGNING AND STRIPING SHEET #1</b>	PROJECT NAME: LAKE CHAMPLAIN SITE RESTORATION	
	PROJECT NUMBER: STP 032-1(18)	
	FILE NAME: z12E008.ssp_01.dgn	PLOT DATE: 7/12/2012
	PROJECT LEADER: D.E.G.	DRAWN BY: W.G.P.
DESIGNED BY: B.T.H.	CHECKED BY: D.E.G.	
DWG. NO.: SSP-1	SHEET 49	OF 100