

INSTALL BAT HOUSE
(SEE DETAIL, SHEET 70)
STA 129+40.0, 45.0' LT

INSTALL BAT HOUSE
(SEE DETAIL, SHEET 70)
STA 128+90.0, 45.0' LT

10 CV

STATE OF VERMONT
WD V25 P120 1928

VT ROUTE 17

STATE OF VERMONT
WD V25 P120 1928

FLAGSTONE
PATHWAY

INSTALL BICYCLE RACK
(SEE DETAIL, SHEET 66)
STA NF 12+55.0, 6.0' RT

INFORMATIONAL SIGN
(SEE DETAIL, SHEET 67)
STA NF 10+43.0, 12.8' LT

3 MS

MOVED

3MS


CHIMNEY POINT DRIVEWAY

900.620 SPECIAL PROVISION (BAT HOUSE)
ADDISON:
STA 128+90.0, 45.0' LT (1EA)
STA 129+40.0, 45.0' LT (1EA)

900.620 SPECIAL PROVISION (INFORMATIONAL SIGN WITH STAND-OFF SIGN HOLDERS)
ADDISON:
STA NF 10+43.0, 12.8' LT (1EA)

900.620 SPECIAL PROVISION (BICYCLE RACK)
ADDISON:
STA NF 12+55.0, 6.0' RT (1EA)

QTY.	SYM.	BOTANICAL NAME	COMMON NAME	SIZE	NOTES
10	CV	CARYA OVATA	SHAGBARK HICKORY	1 1/2"-2" CAL.	B&B
3	MS	MALUS SP.	SNOW APPLE	3/4"-1" CAL.	B&B

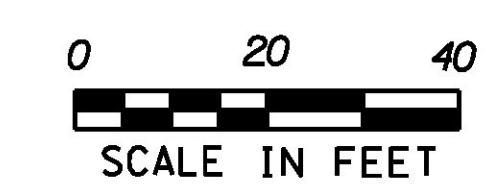

LANDSCAPING PLAN SHEET #2	PROJECT NAME: LAKE CHAMPLAIN SITE RESTORATION	PLOT DATE: 7/12/2012
	PROJECT NUMBER: STP 032-K(18)	DRAWN BY: W.G.P.
	FILE NAME: z12E008_lsp_02.dgn	CHECKED BY: D.E.G.
	DESIGNED BY: B.T.H.	SHEET 72 OF 100
	DWG. NO.: LP-2	

FILE NAME = I:\A\2012\30\ACADD\MSTN\z12E008_1sp_02.dgn
 DATE/TIME = 7/12/2012 10:46:56
 USER = 4666