



REVISED LANDSCAPING PLAN

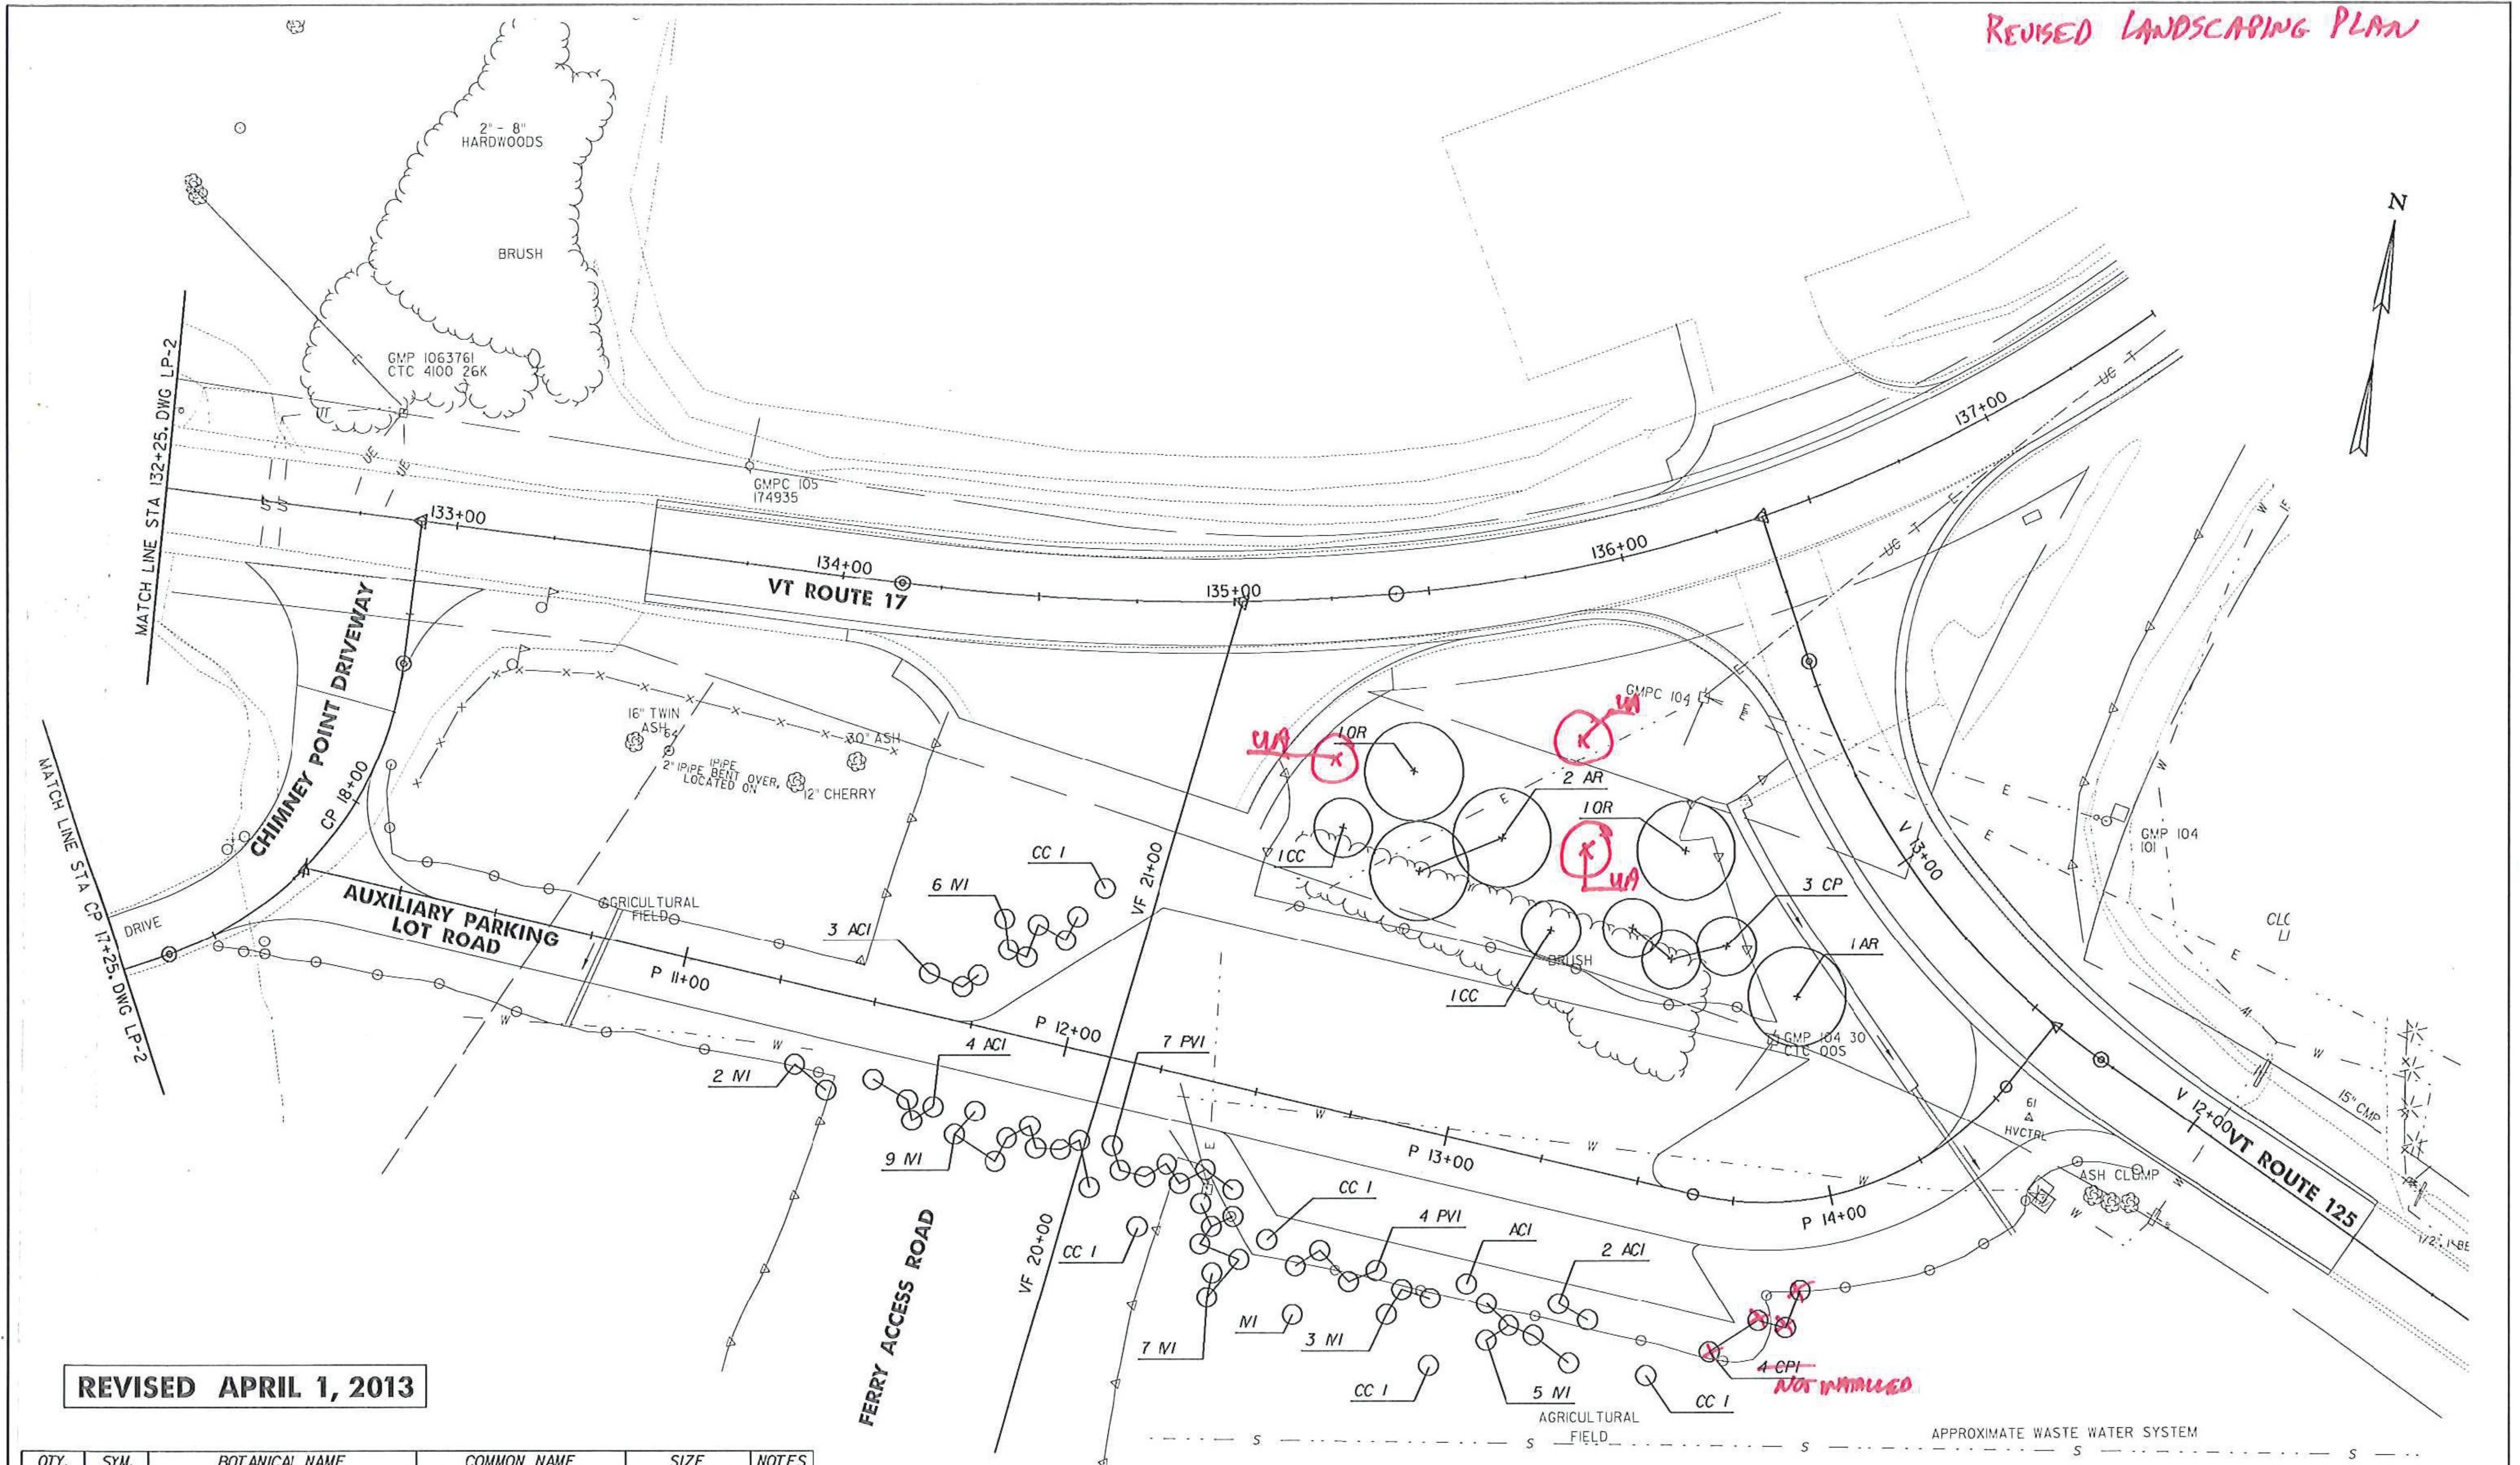

REVISED APRIL 1, 2013

QTY.	SYM.	BOTANICAL NAME	COMMON NAME	SIZE	NOTES
10	ACI	AMELANCHIER CANADENSIS	SERVICEBERRY	5 GAL.	CONT.
3	AR	ACER RUBRUM 'OCTOBER GLORY'	RED MAPLE	2" - 2 1/2" CAL.	B&B
2	CC	CERCIS CANADENSIS	EASTERN REDBUD	6' - 7' HT.	B&B
5	CCI	CERCIS CANADENSIS	EASTERN REDBUD	5 GAL.	CONT.
3	CP	CRATAEGUS PHAENOPYRUM	WASHINGTON HAWTHORNE	1 3/4" - 2" CAL.	B&B
4	CPI	CRATAEGUS PHAENOPYRUM	WASHINGTON HAWTHORNE	5 GAL.	CONT.
33	NI	ILEX VETICILLATA	WINTERBERRY	3 GAL.	CONT.
11	PVI	PRUNUS VIRGINIANA	CHOKECHERRY	3 GAL.	CONT.
2	OR	QUERCUS RUBRA	RED OAK	2" - 2 1/2" CAL.	B&B

3 LVA ILEX AMERICANA VAR. AMERICANA 2" - 2 1/2" CAL. B&B

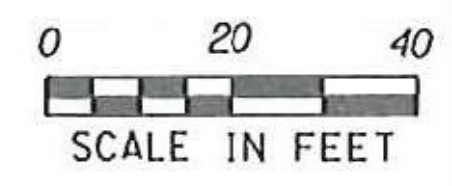

LANDSCAPING PLAN SHEET #3

PROJECT NAME: LAKE CHAMPLAIN SITE RESTORATION  
 PROJECT NUMBER: STP 032-1(18)  
 FILE NAME: z12E008-isp.03.dgn  
 PROJECT LEADER: D.E.G.  
 DESIGNED BY: B.T.H.  
 DWG. NO.: LP-3  
 PLOT DATE: 4/3/2013  
 DRAWN BY: W.G.P.  
 CHECKED BY: D.E.G.  
 SHEET 73A OF 100

FILE NAME: LA200308\CGDD\MS\TN\Apr-11-2013-Revision\z12E008-isp.03.dgn  
 DATE/TIME: 4/2/2013 10:58:46  
 USER: wgs