




CP 16+00

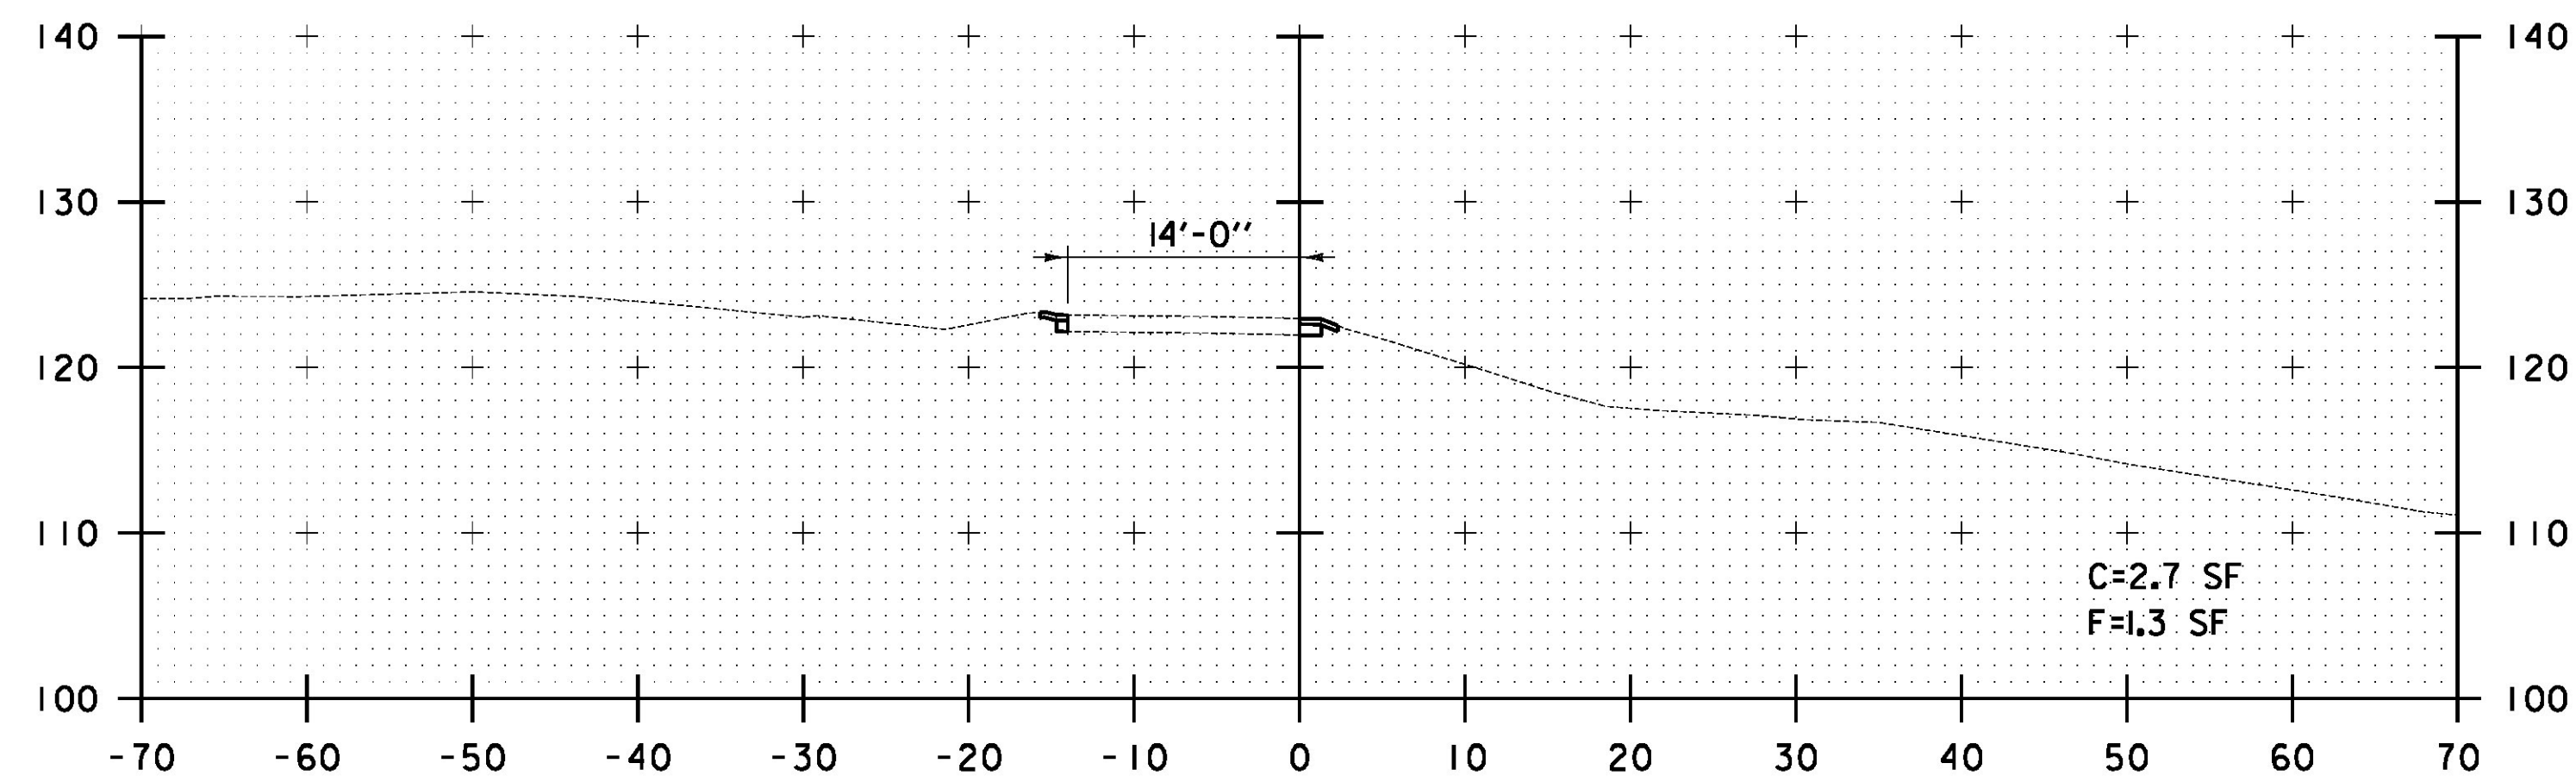


CP 15+50

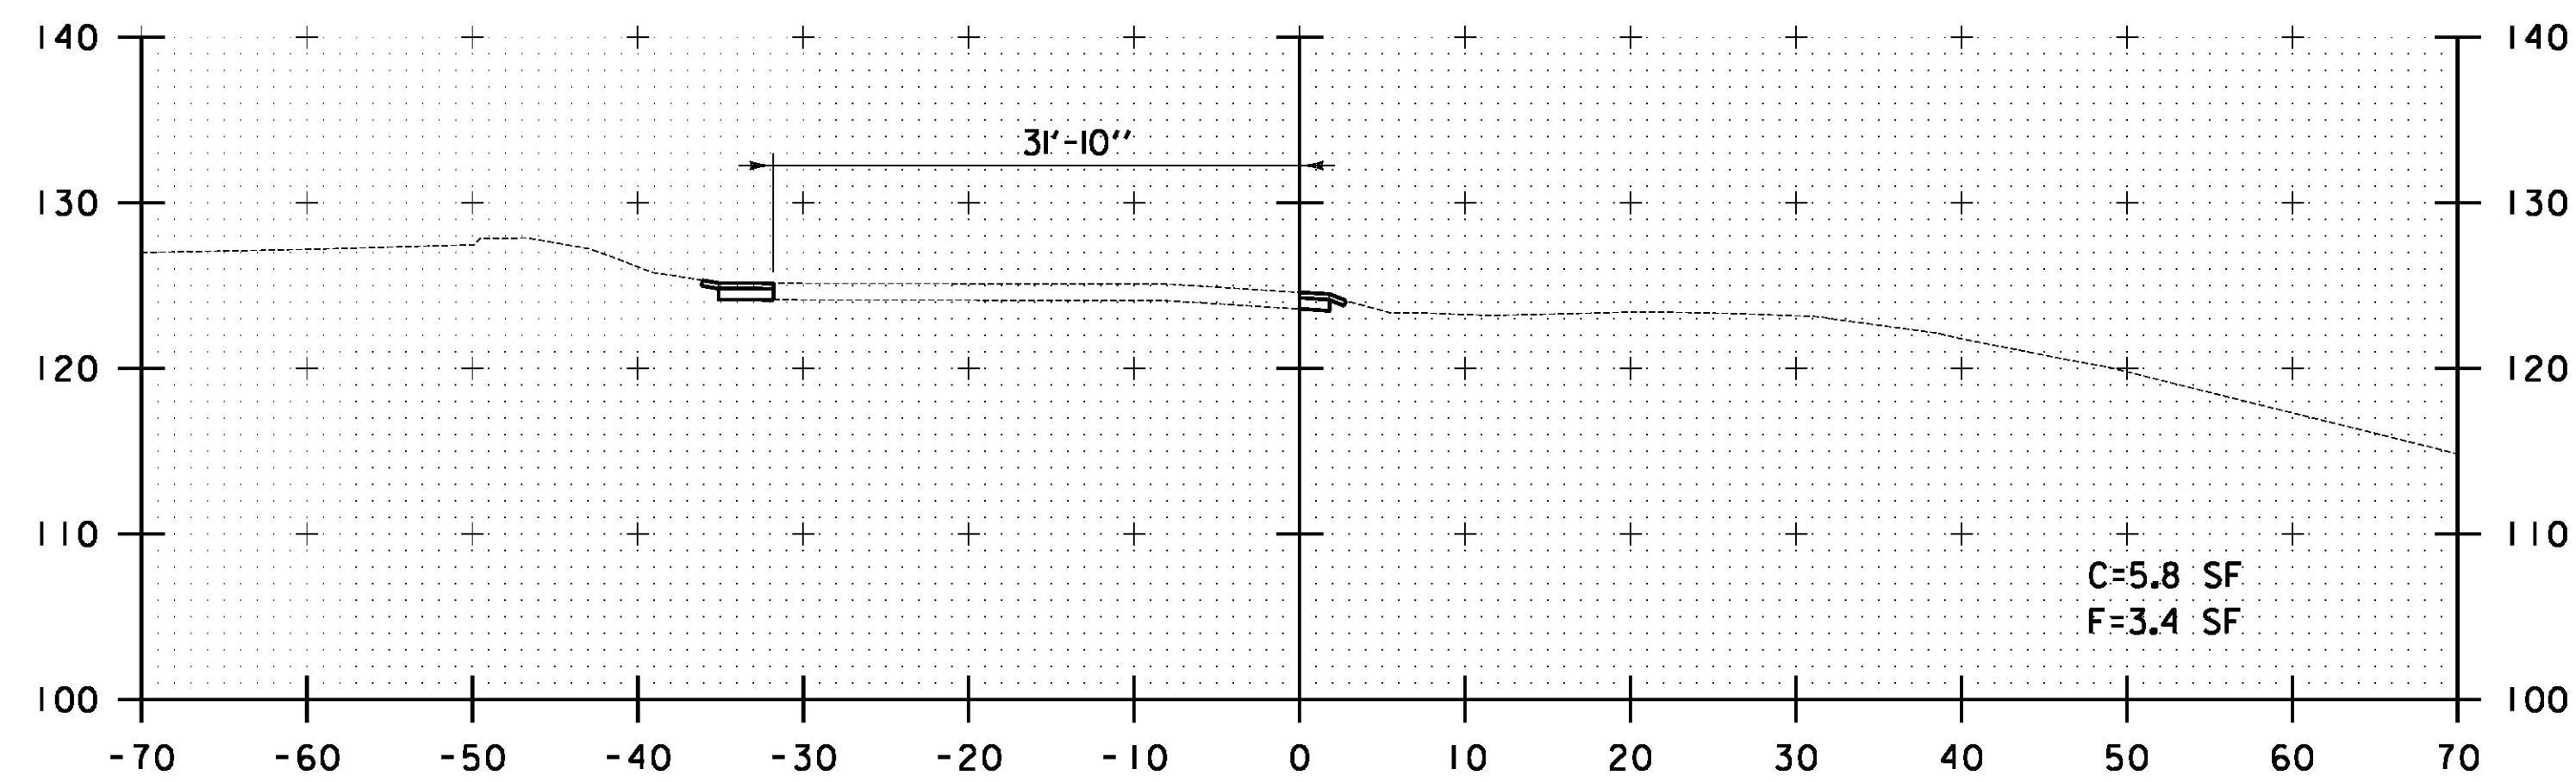


CP 15+00

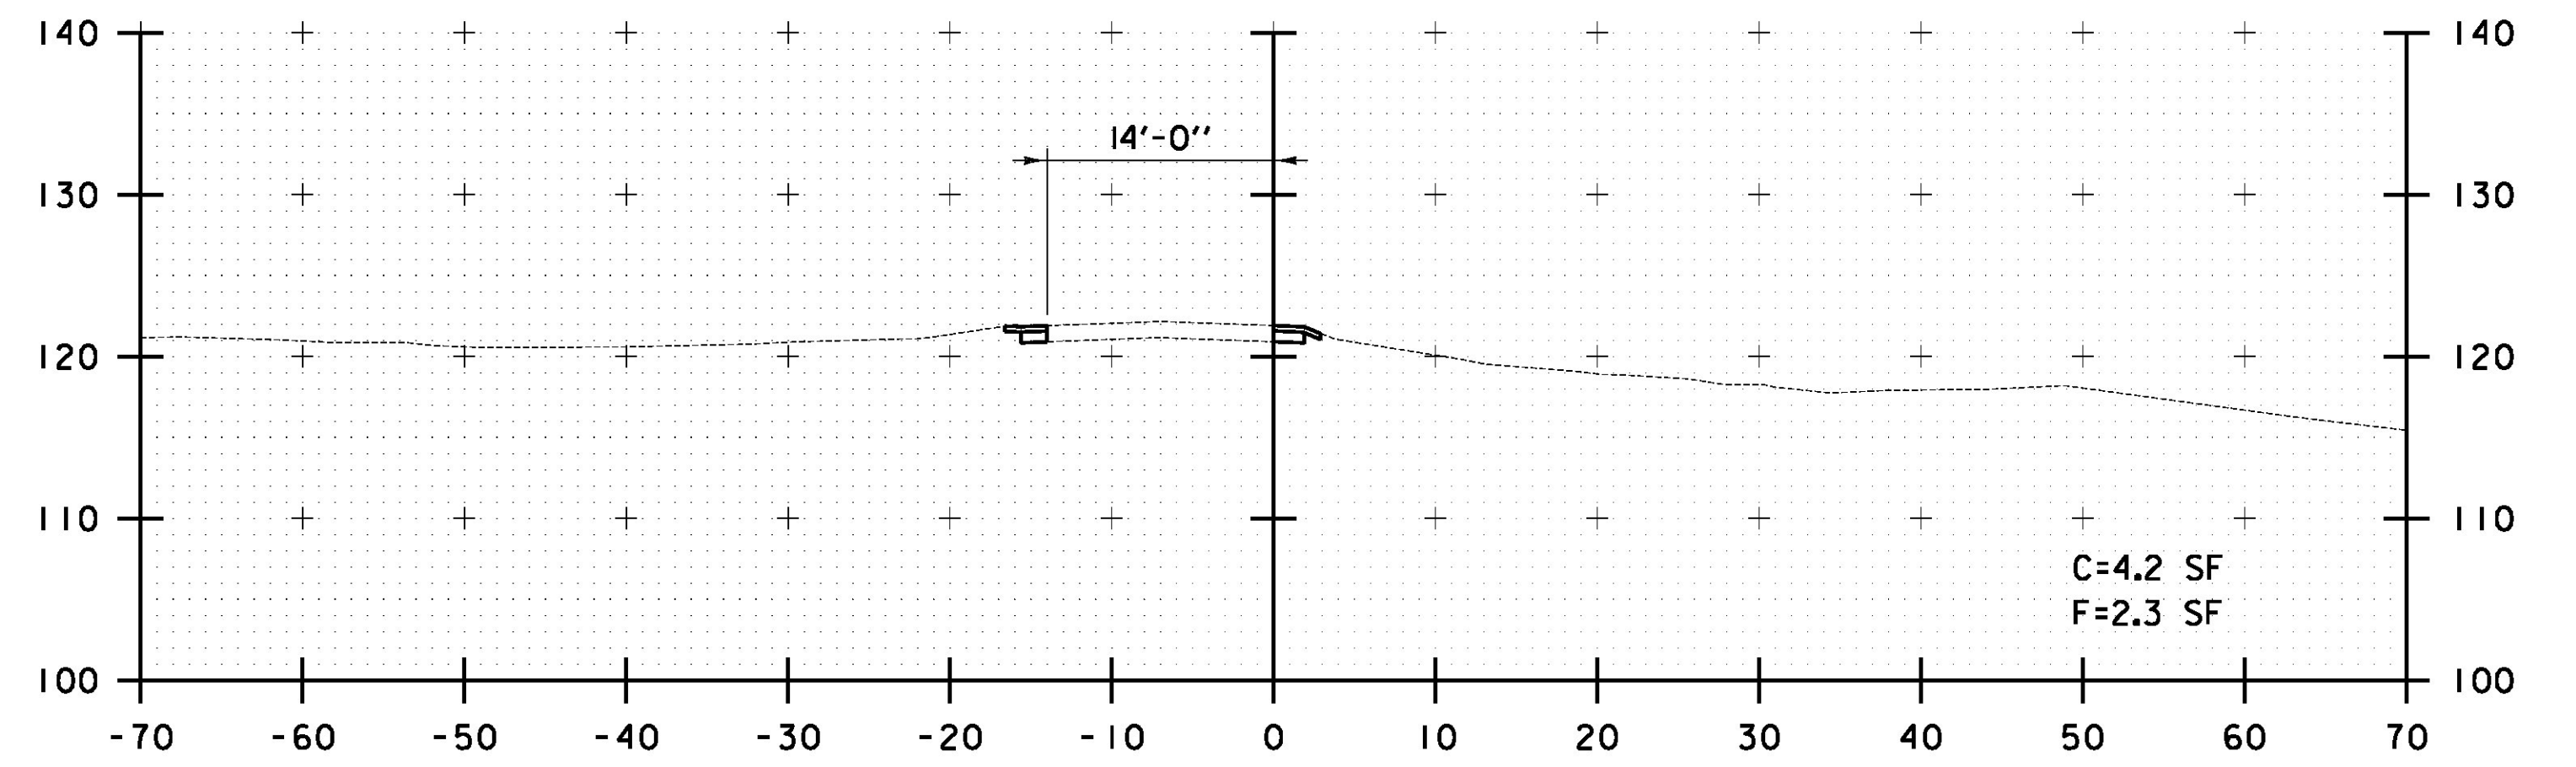


CP 17+50

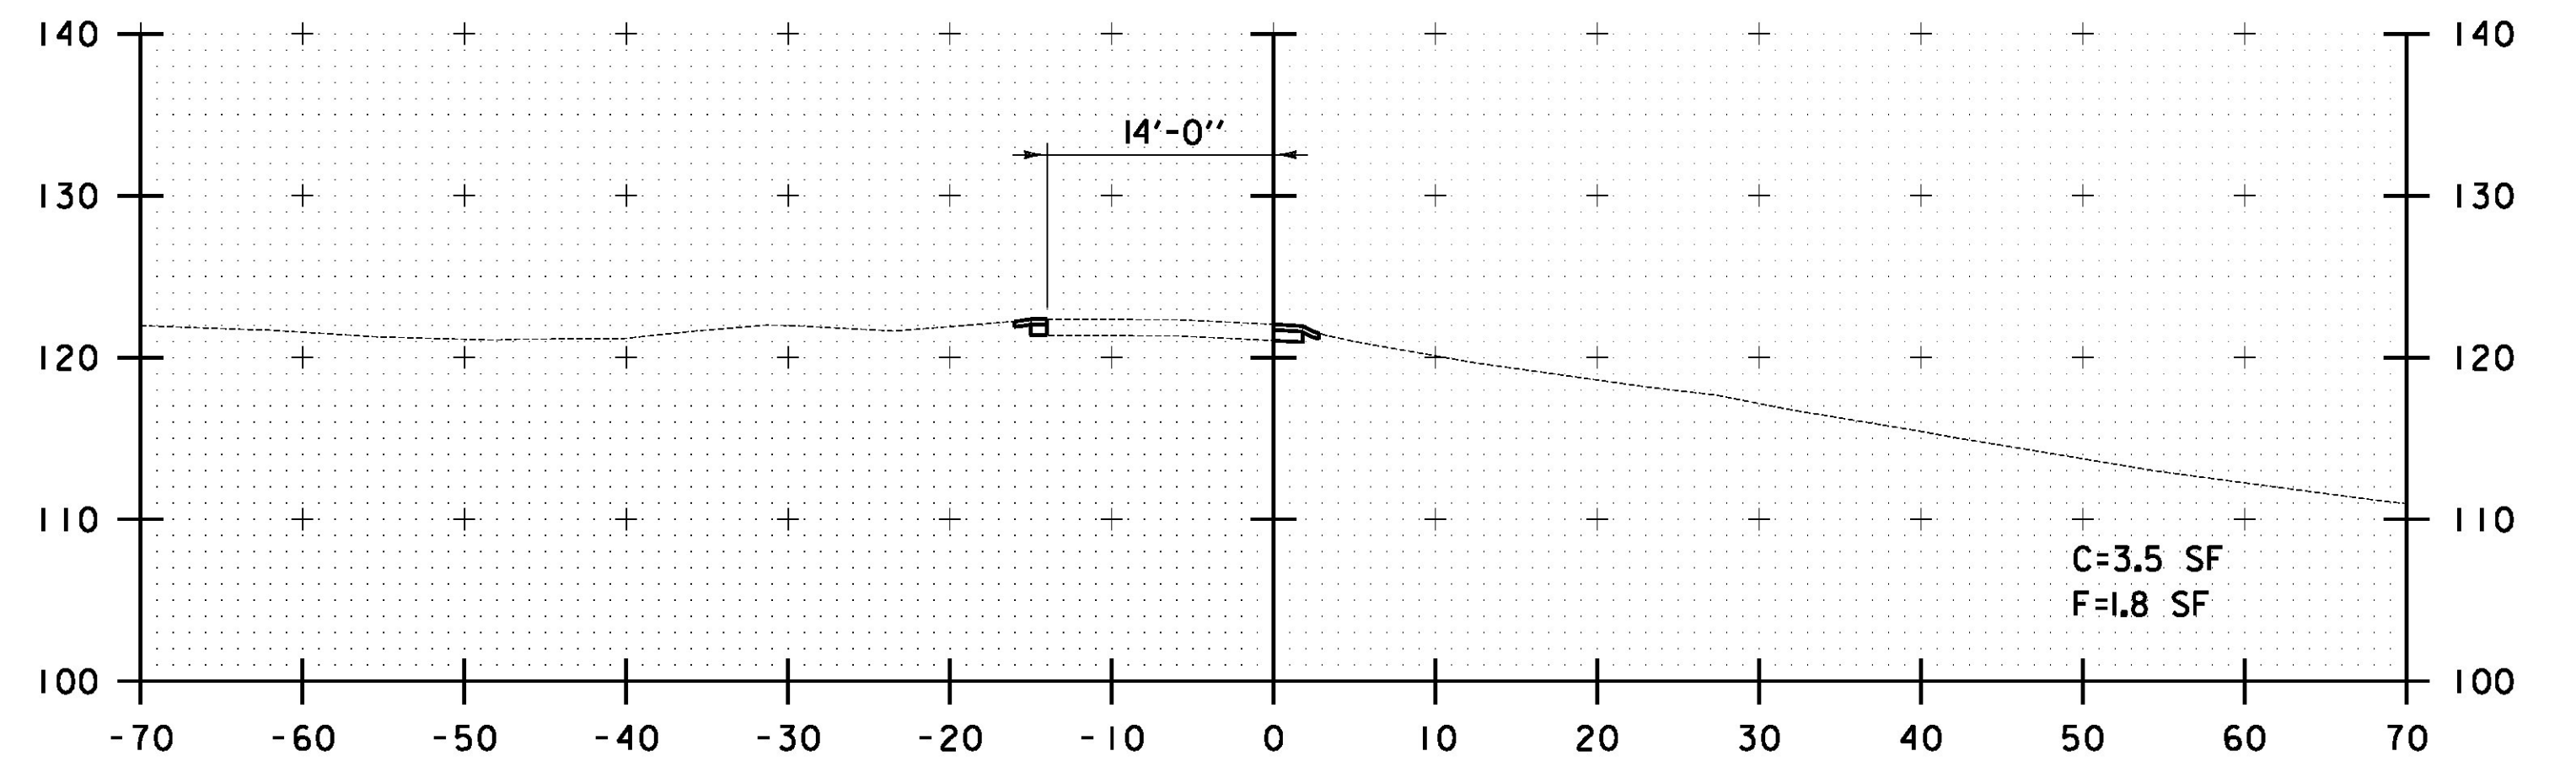

CP 17+00

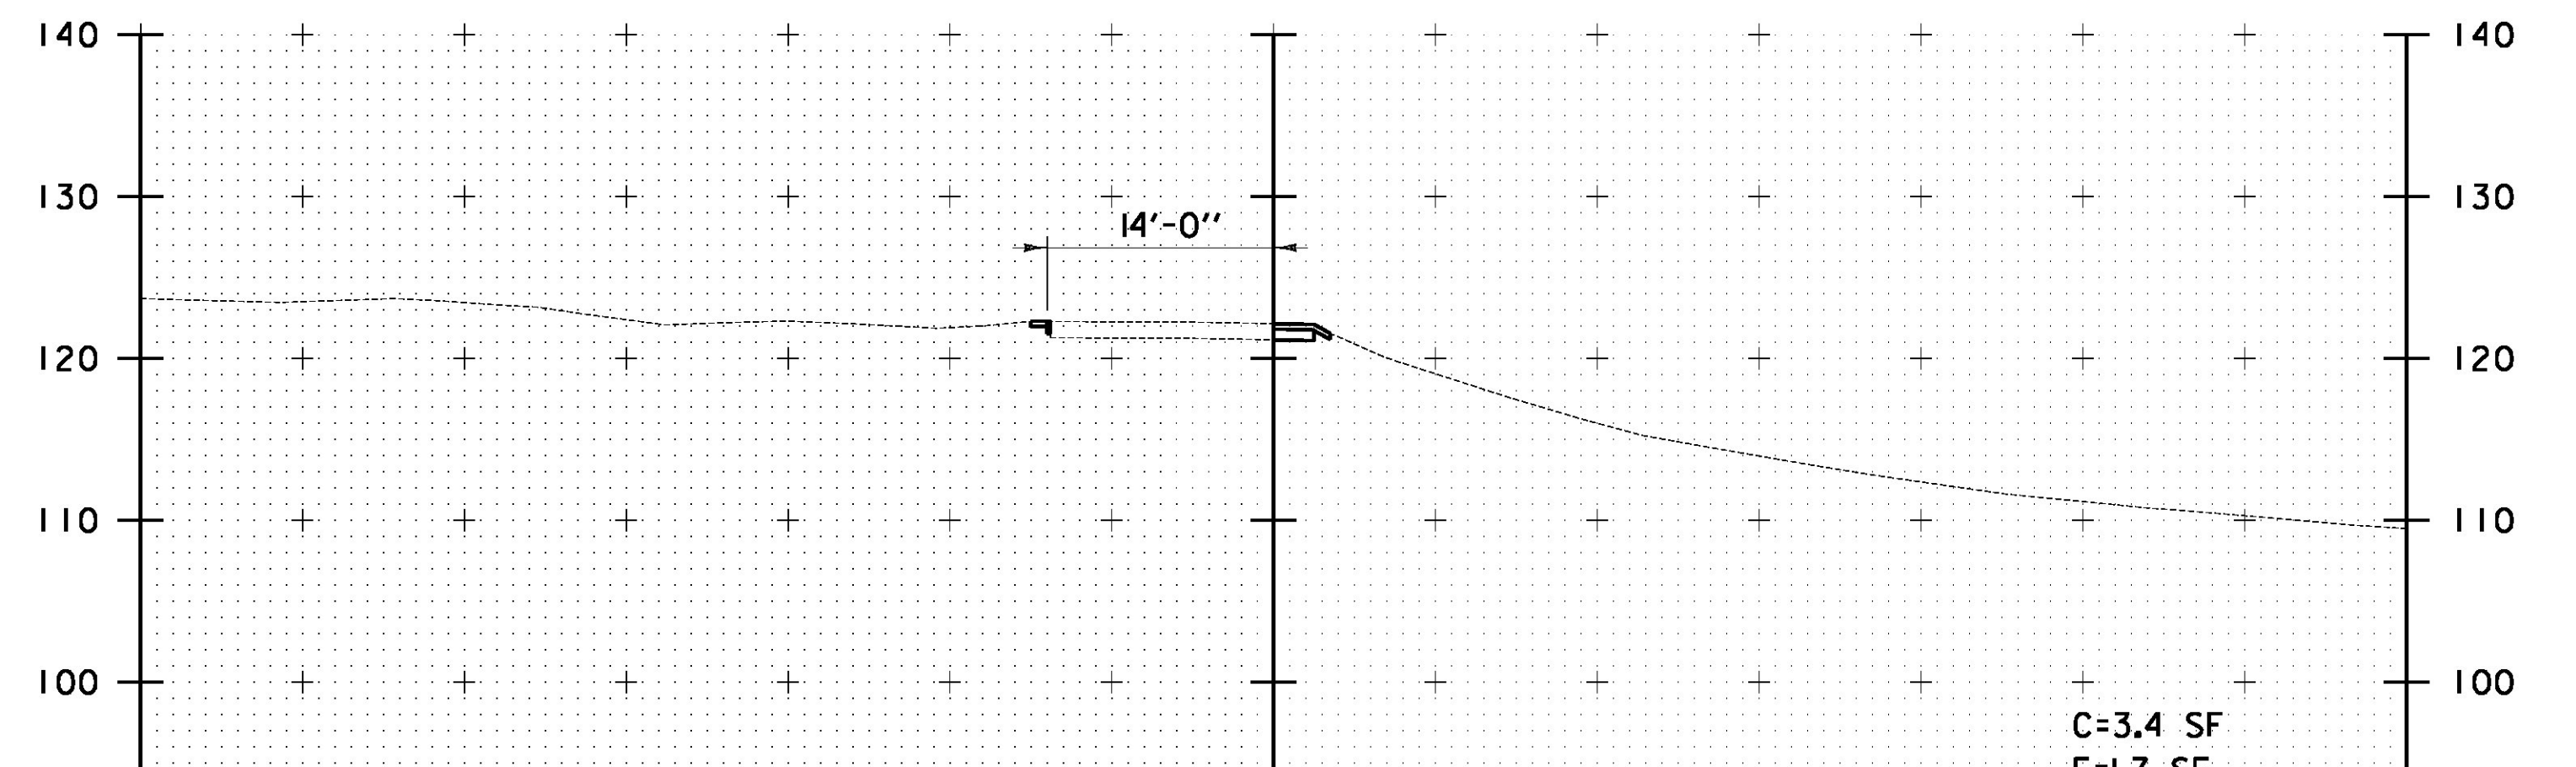

CP 16+50

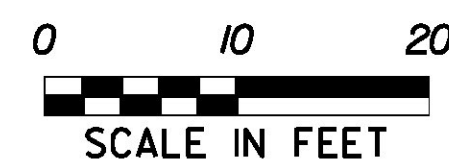

STA. CP 15+00 TO STA. CP 17+50

FILE NAME = I:\2012\08\CADD\MSTN\12E008_xsec_01.dgn
DATE/TIME = 7/12/2012
USER = 4666

CROSS SECTION SHEET #3	PROJECT NAME: LAKE CHAMPLAIN SITE RESTORATION
	PROJECT NUMBER: STP 032-I(18)
	FILE NAME: z12E008_xsec_01.dgn
	PLOT DATE: 7/12/2012
	DRAWN BY: W.G.P.
	CHECKED BY: D.E.G.
	DESIGNED BY: B.T.H.
	DWG. NO.: XS-3
	SHEET 77 OF 100