




CP 18+50

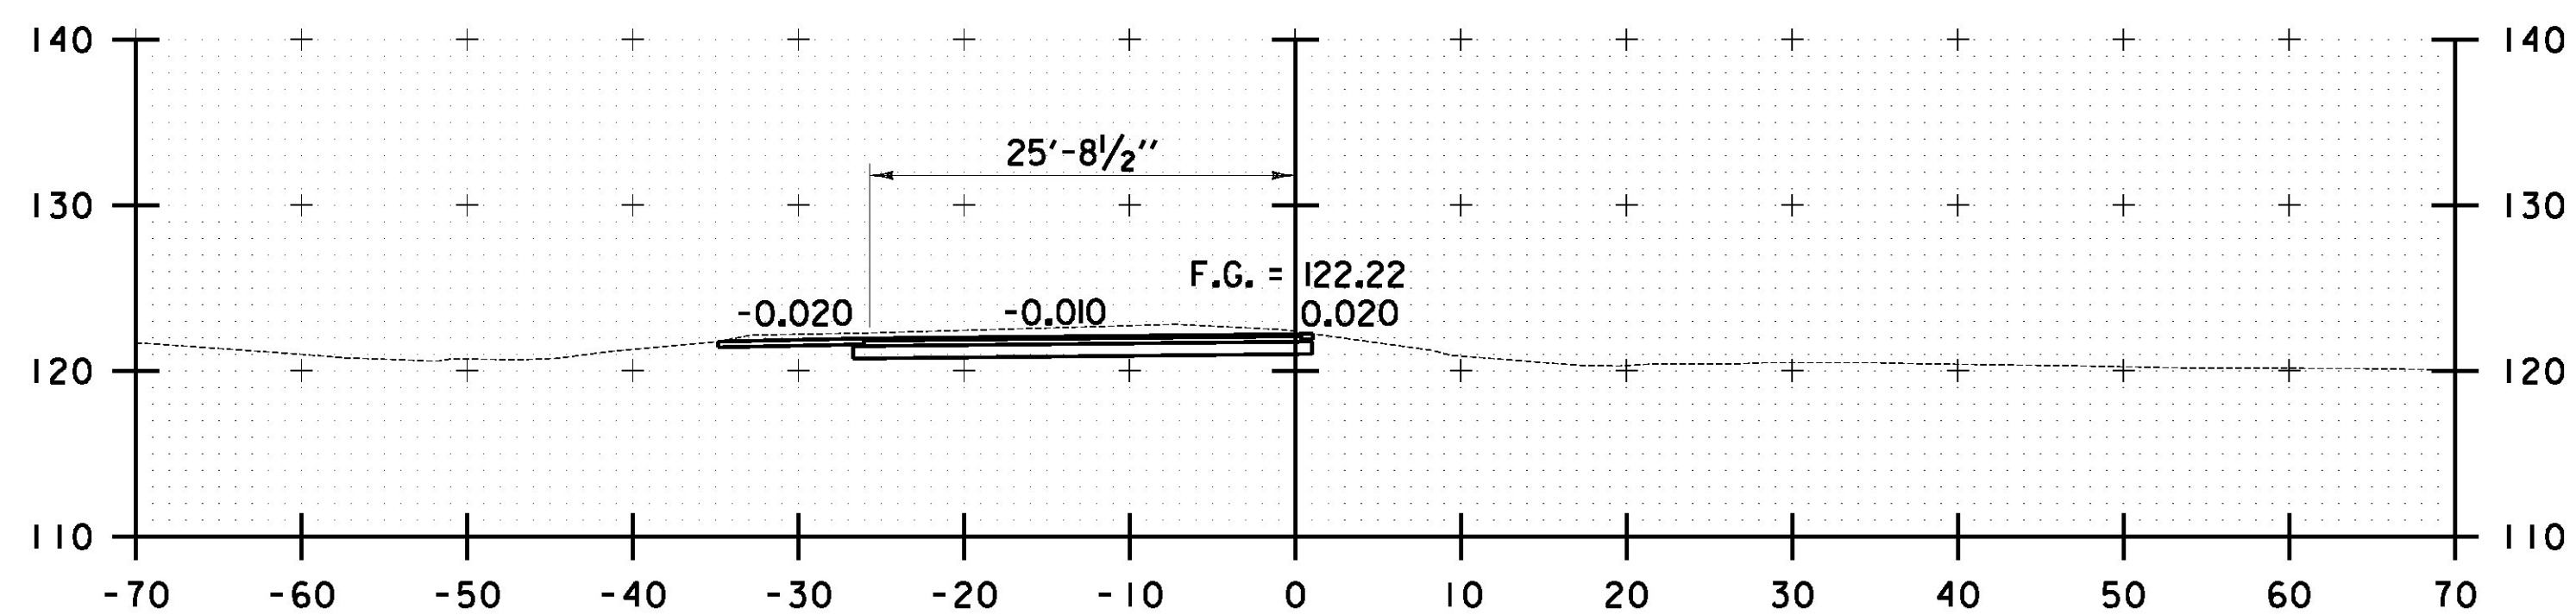


VB 18+25

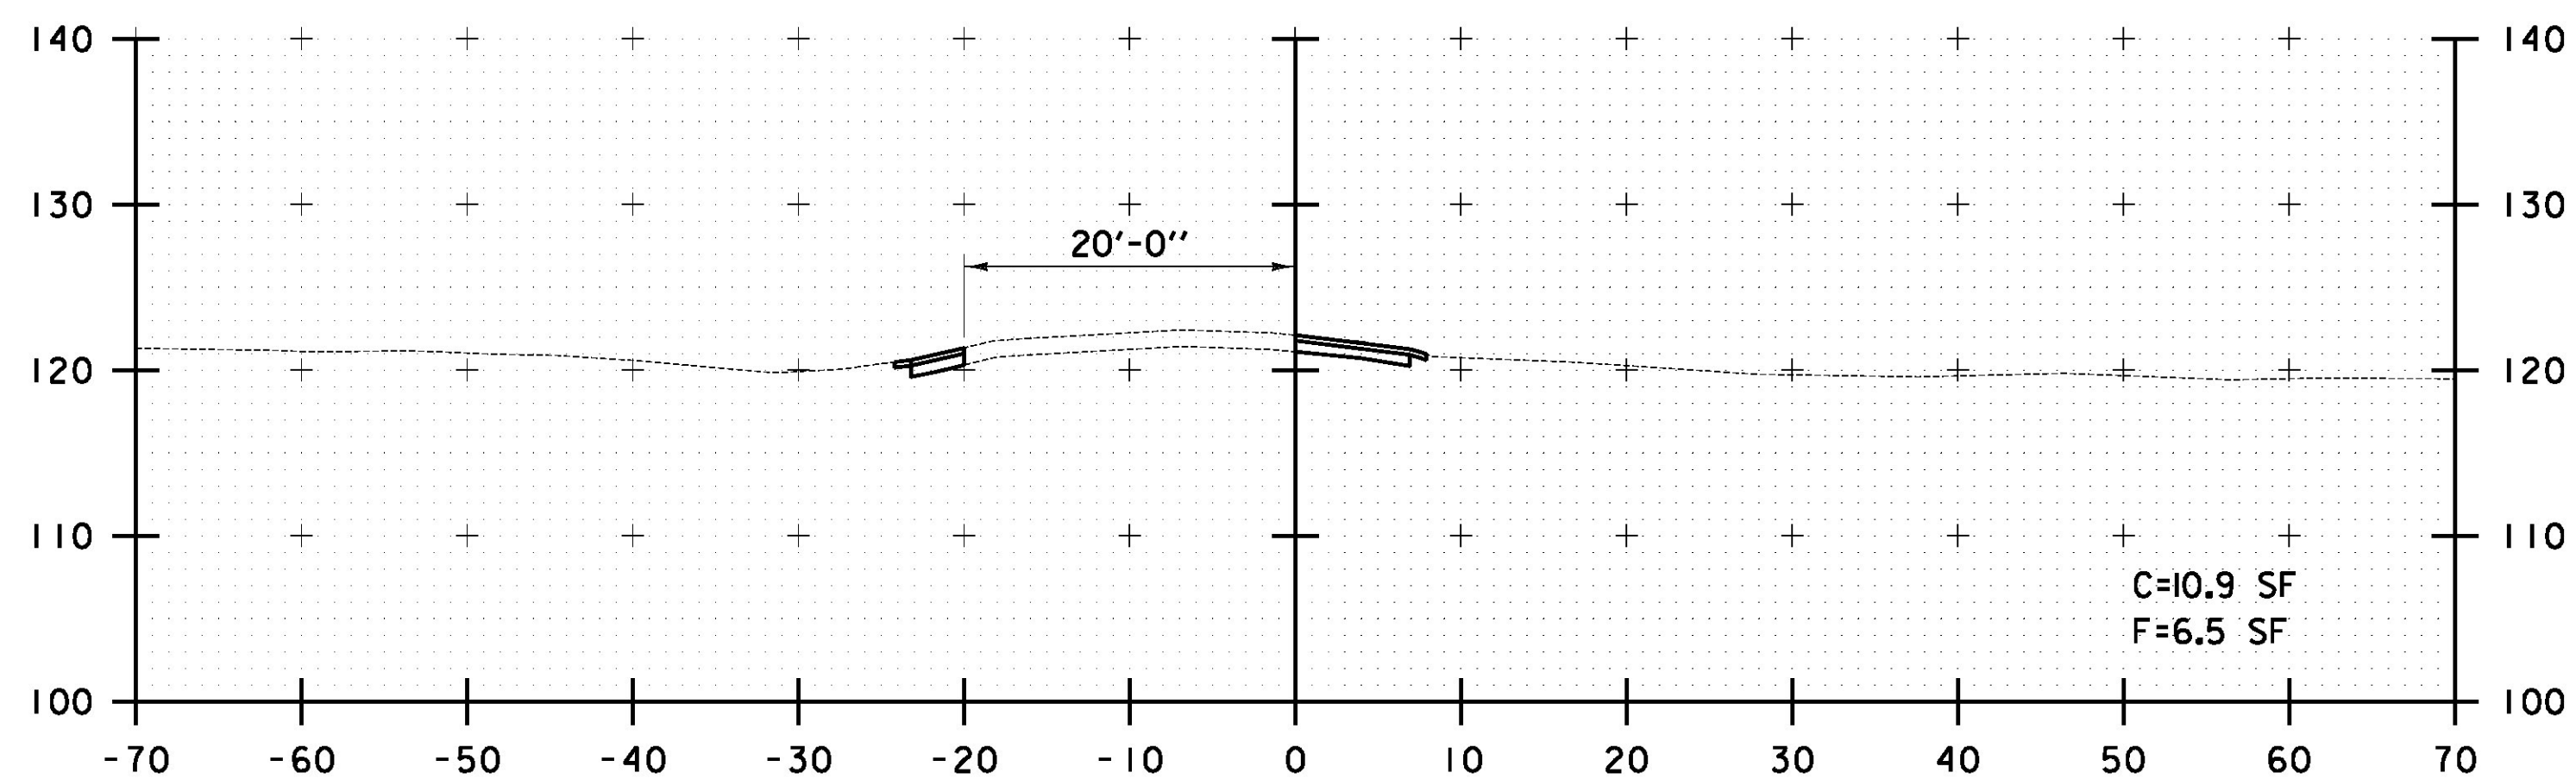

CP 18+00

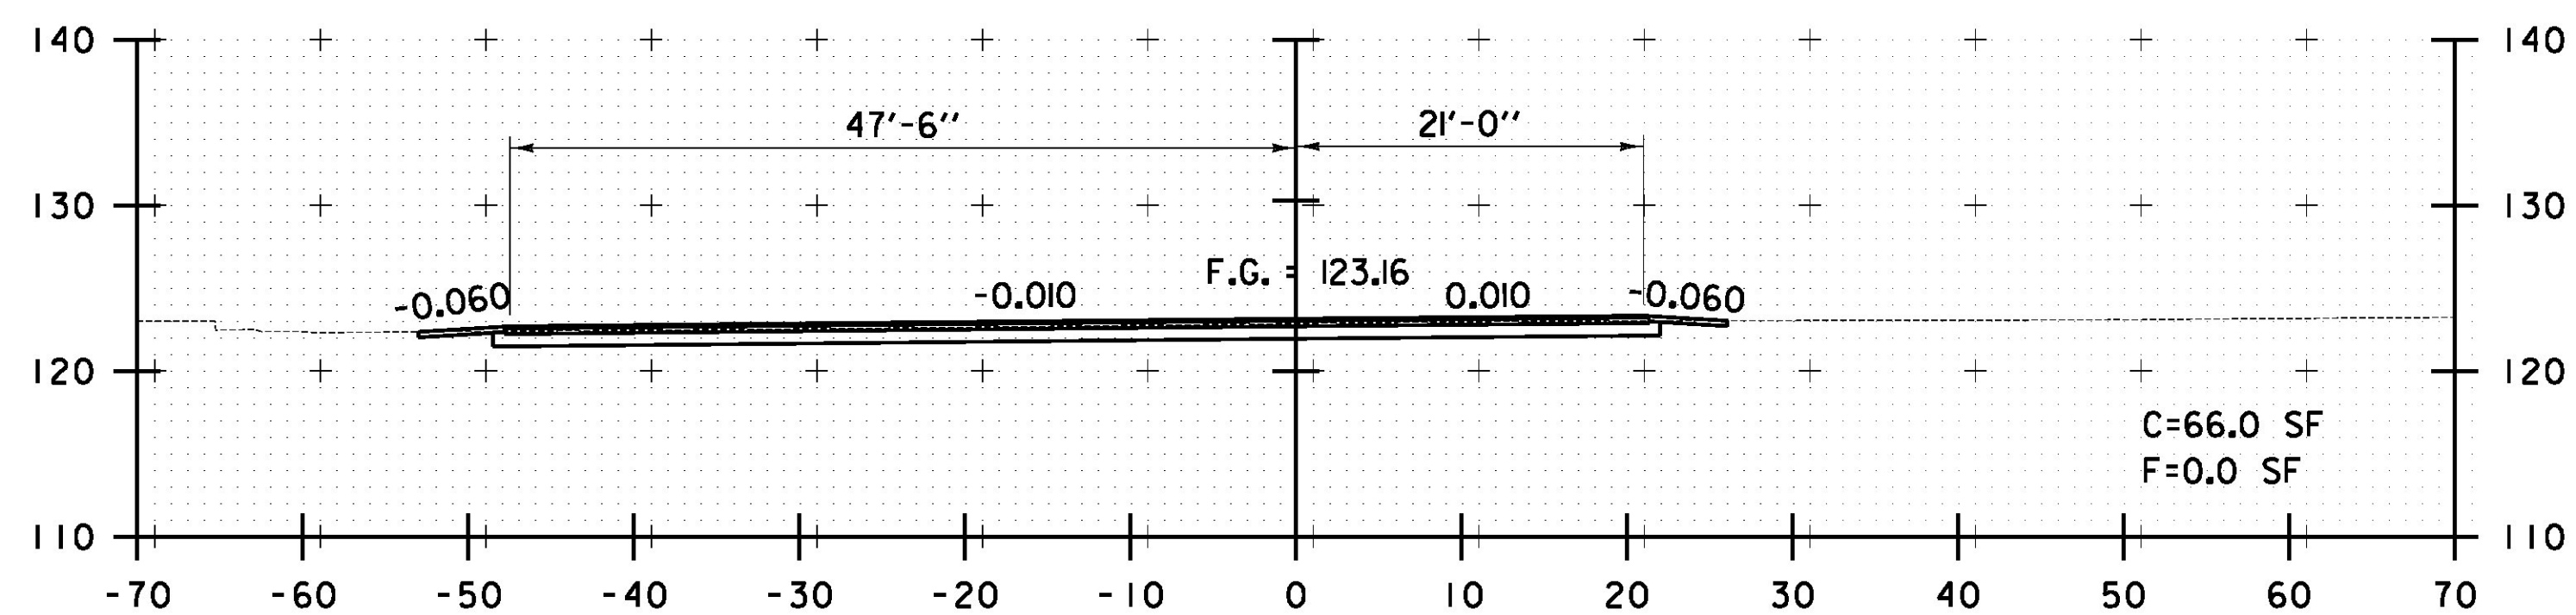

CP 18+60

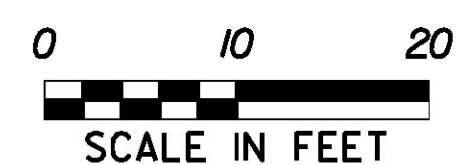

STA. CP 18+00 TO STA. CP 18+60

FILE NAME = I:\212\212008\CADD\MSTN\212E008_xsec_01.dgn
 DATE/TIME = 7/12/2012
 USER = 4666

CROSS SECTION SHEET #4	PROJECT NAME: LAKE CHAMPLAIN SITE RESTORATION
	PROJECT NUMBER: STP 032-1(18)
	FILE NAME: 212E008_xsec_01.dgn
	PLOT DATE: 7/12/2012
	PROJECT LEADER: D.E.G.
	DRAWN BY: W.G.P.
	DESIGNED BY: B.T.H.
	CHECKED BY: D.E.G.
	DWG. NO.: XS-4
	SHEET 78 OF 100