




VF 18+50

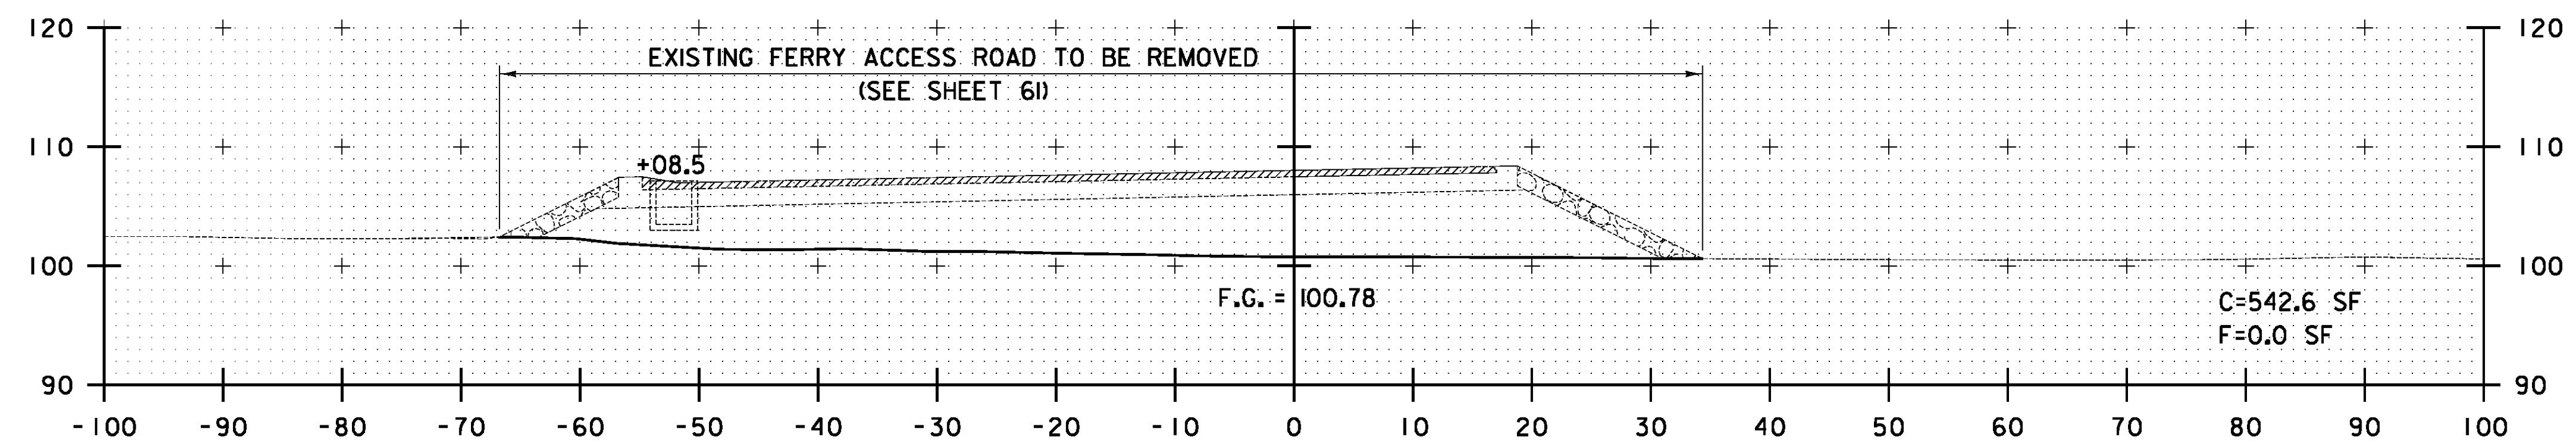

VF 18+00

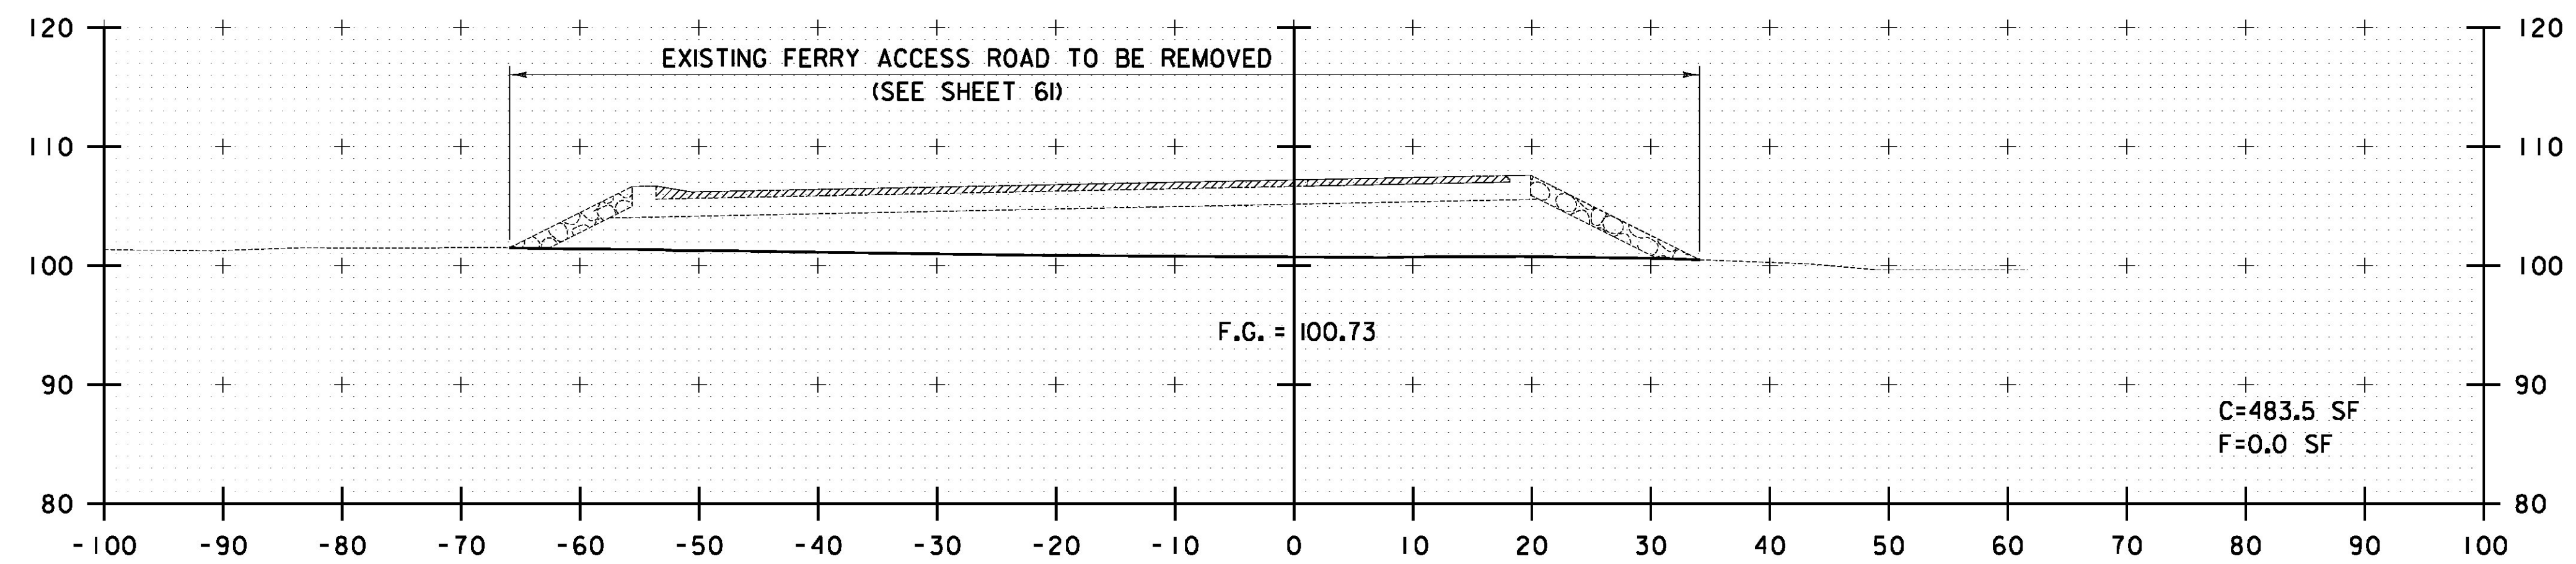

VF 17+59

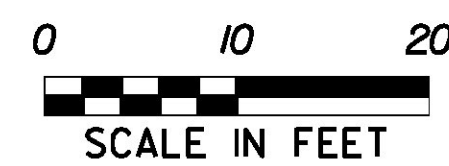

STA. VF 17+59 TO STA. VF 18+50

FILE NAME = I:\2012\30\ACADD\MSTN\12E008_xsec_02.dgn
DATE/TIME = 7/12/2012
USER = 4666

CROSS SECTION SHEET #5	PROJECT NAME: LAKE CHAMPLAIN SITE RESTORATION
	PROJECT NUMBER: STP 032-I(18)
	FILE NAME: z12E008_xsec_02.dgn
DESIGNED BY: B.T.H.	PLOT DATE: 7/12/2012
DWG. NO.: XS-5	CHECKED BY: D.E.G.
	DRAWN BY: W.G.P.
	SHEET 79 OF 100