




VF 20+00

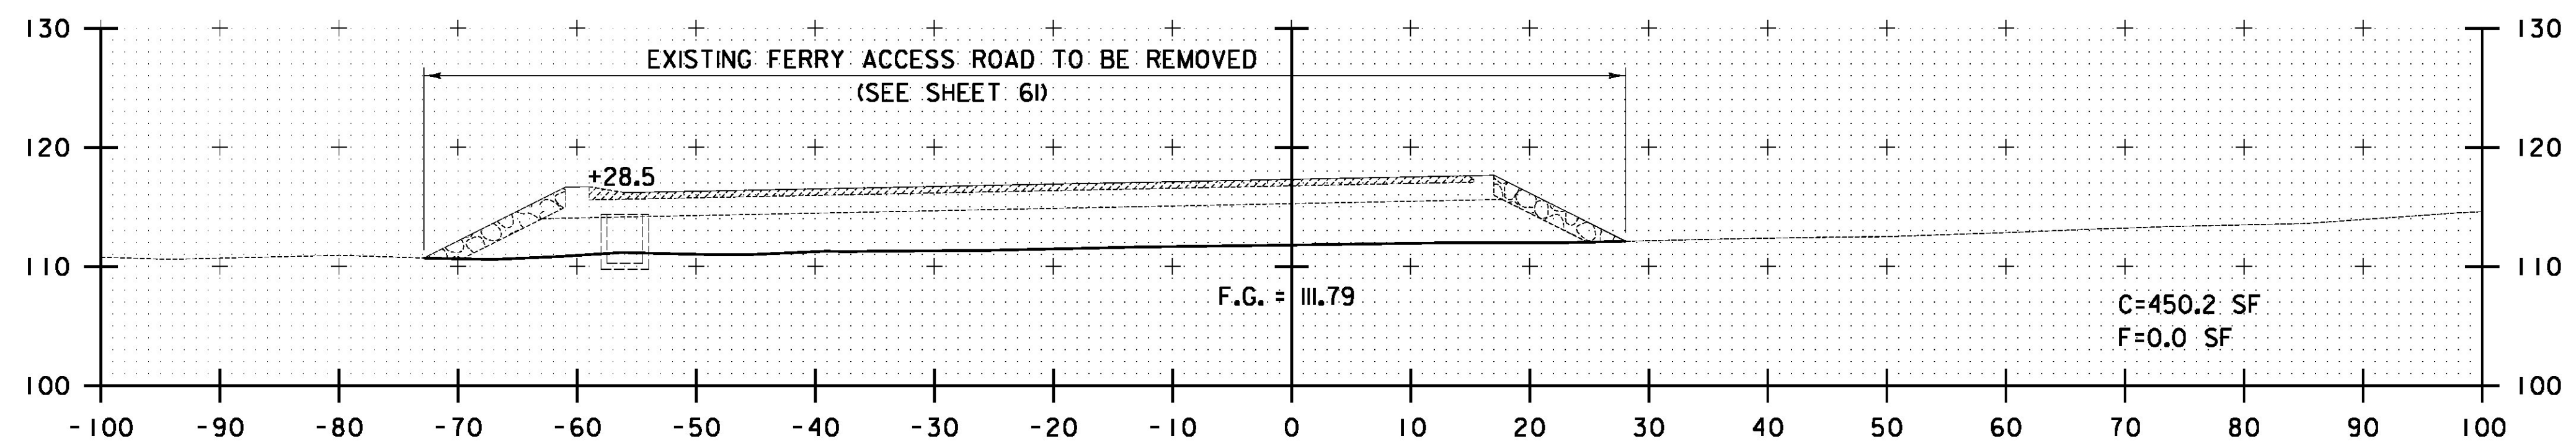

VF 19+50

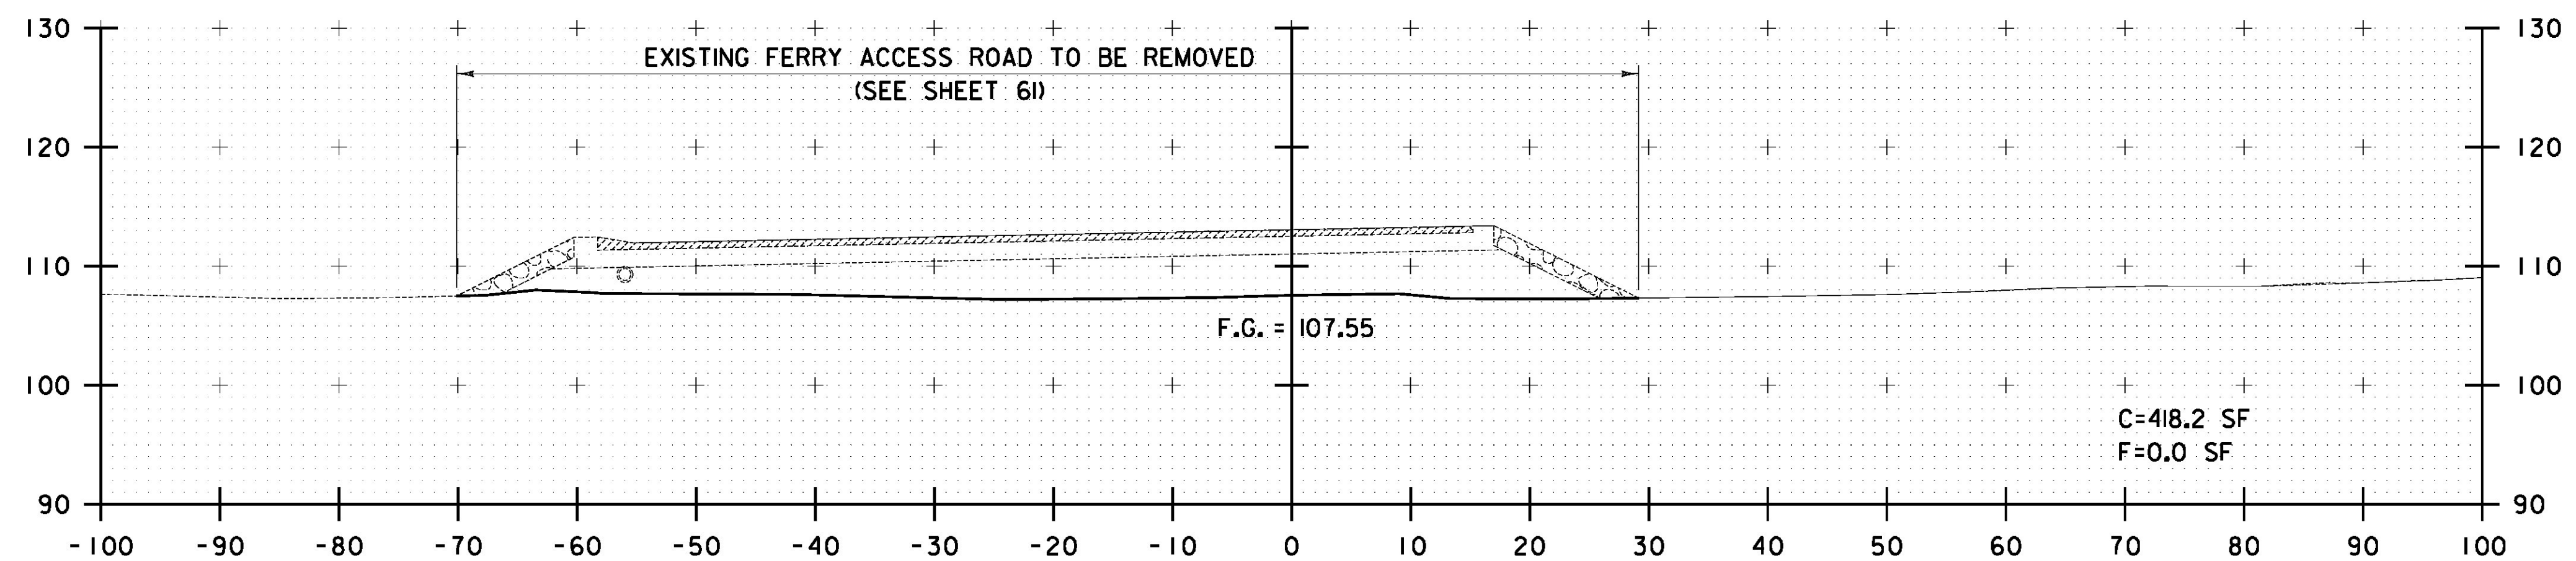

VF 19+00

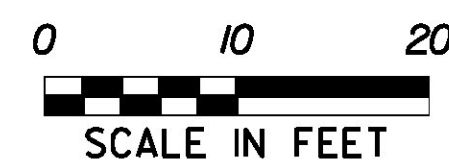

STA. VF 19+00 TO STA. VF 20+00

FILE NAME = I:\2012\08\CADD\MSTN\12\2012\08\08.xsec.02.dgn  
 DATE/TIME = 7/12/2012 10:46:56  
 USER = 4666

<b>CROSS SECTION SHEET #6</b>	PROJECT NAME: LAKE CHAMPLAIN SITE RESTORATION
	PROJECT NUMBER: STP 032-1(18)
	FILE NAME: z12E008_xsec.02.dgn
	PLOT DATE: 7/12/2012
	DRAWN BY: W.G.P.
	DESIGNED BY: B.T.H.
	CHECKED BY: D.E.G.
	DWG. NO.: XS-6
	SHEET 80 OF 100