




P 11+00

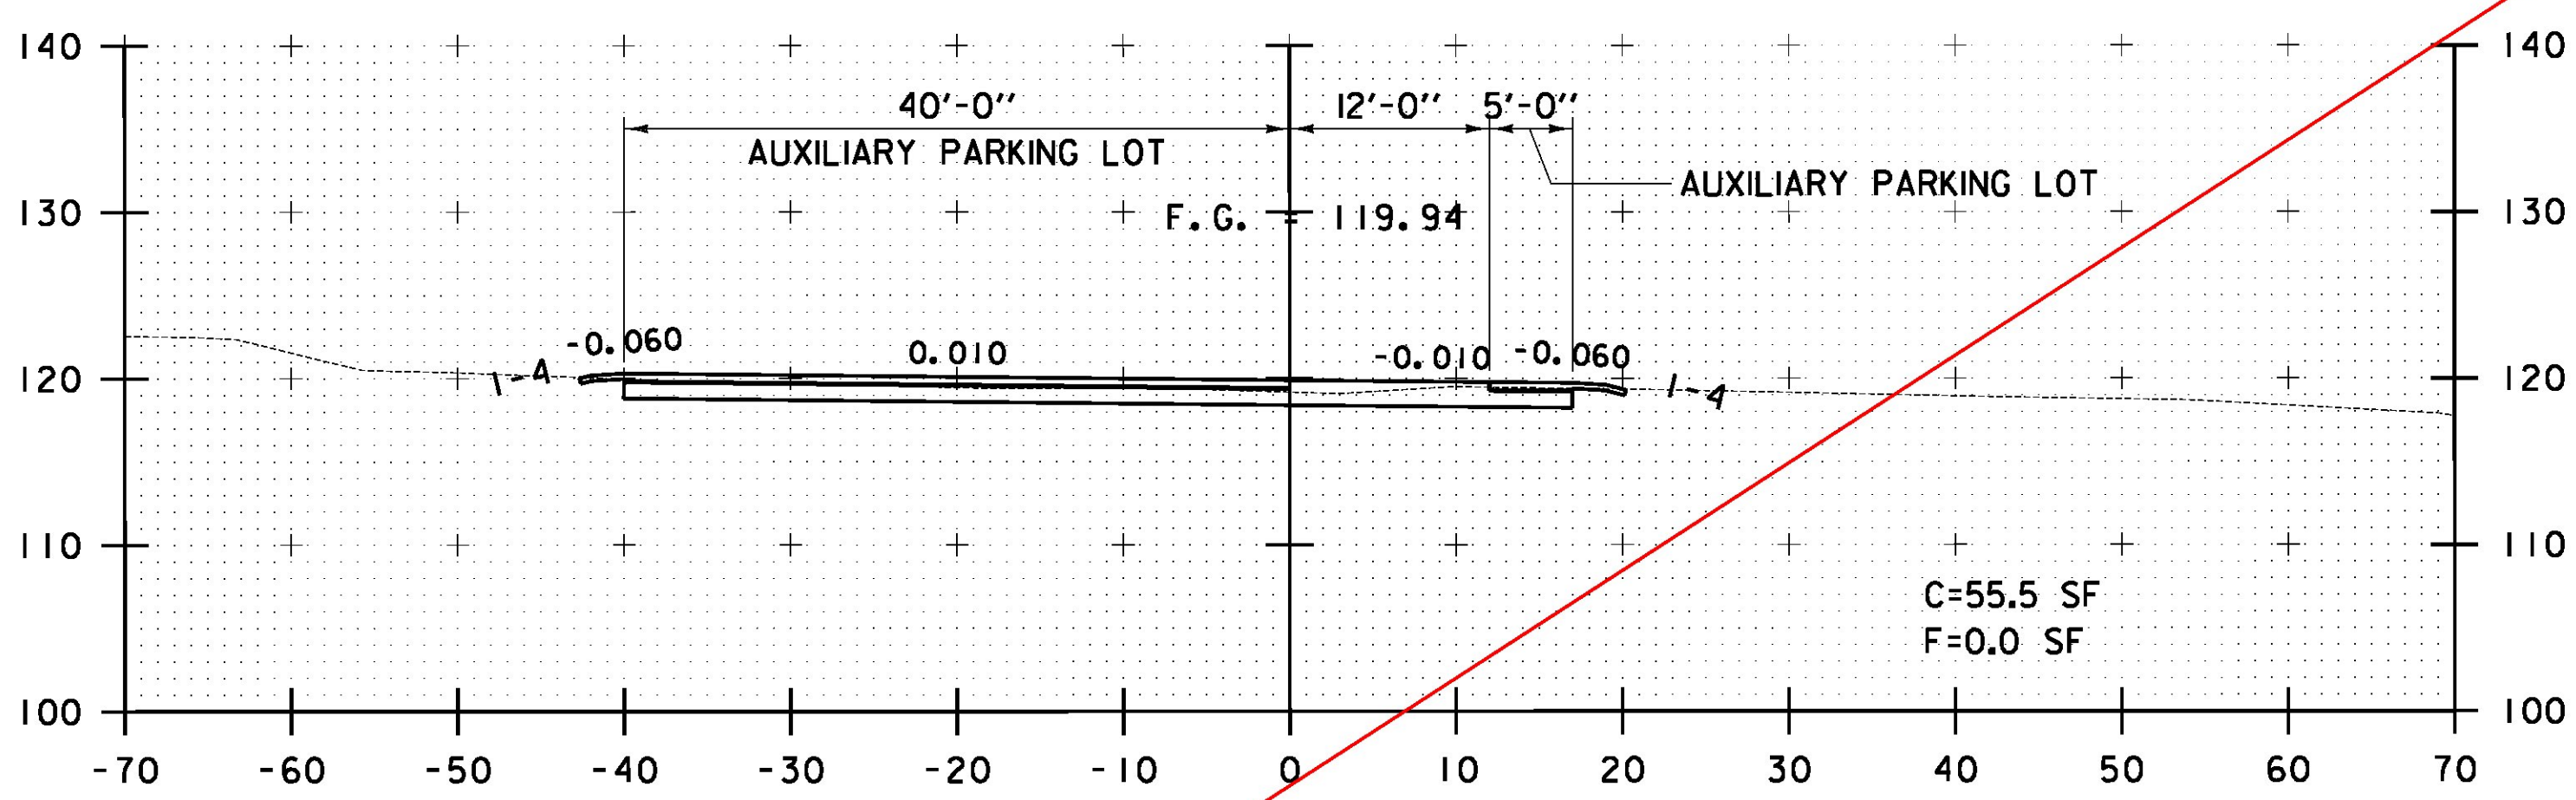


P 12+50

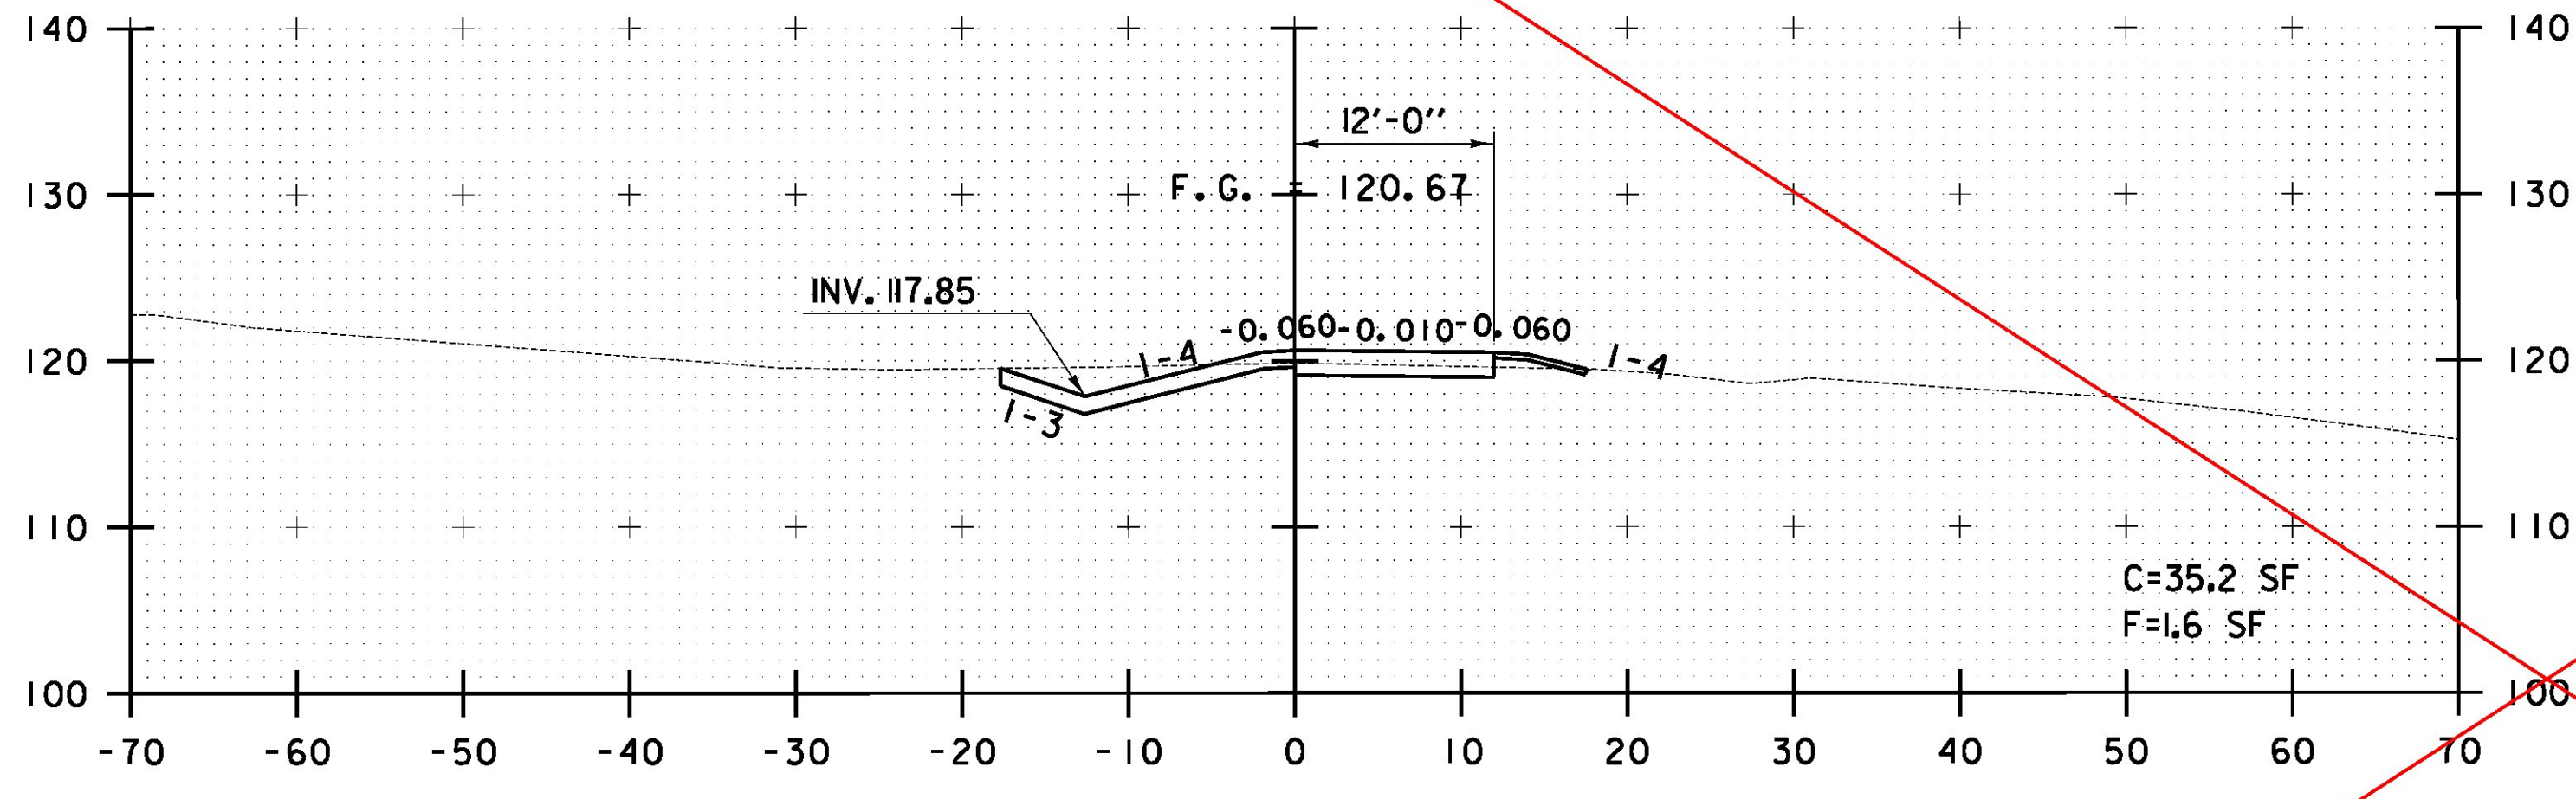


P 10+50

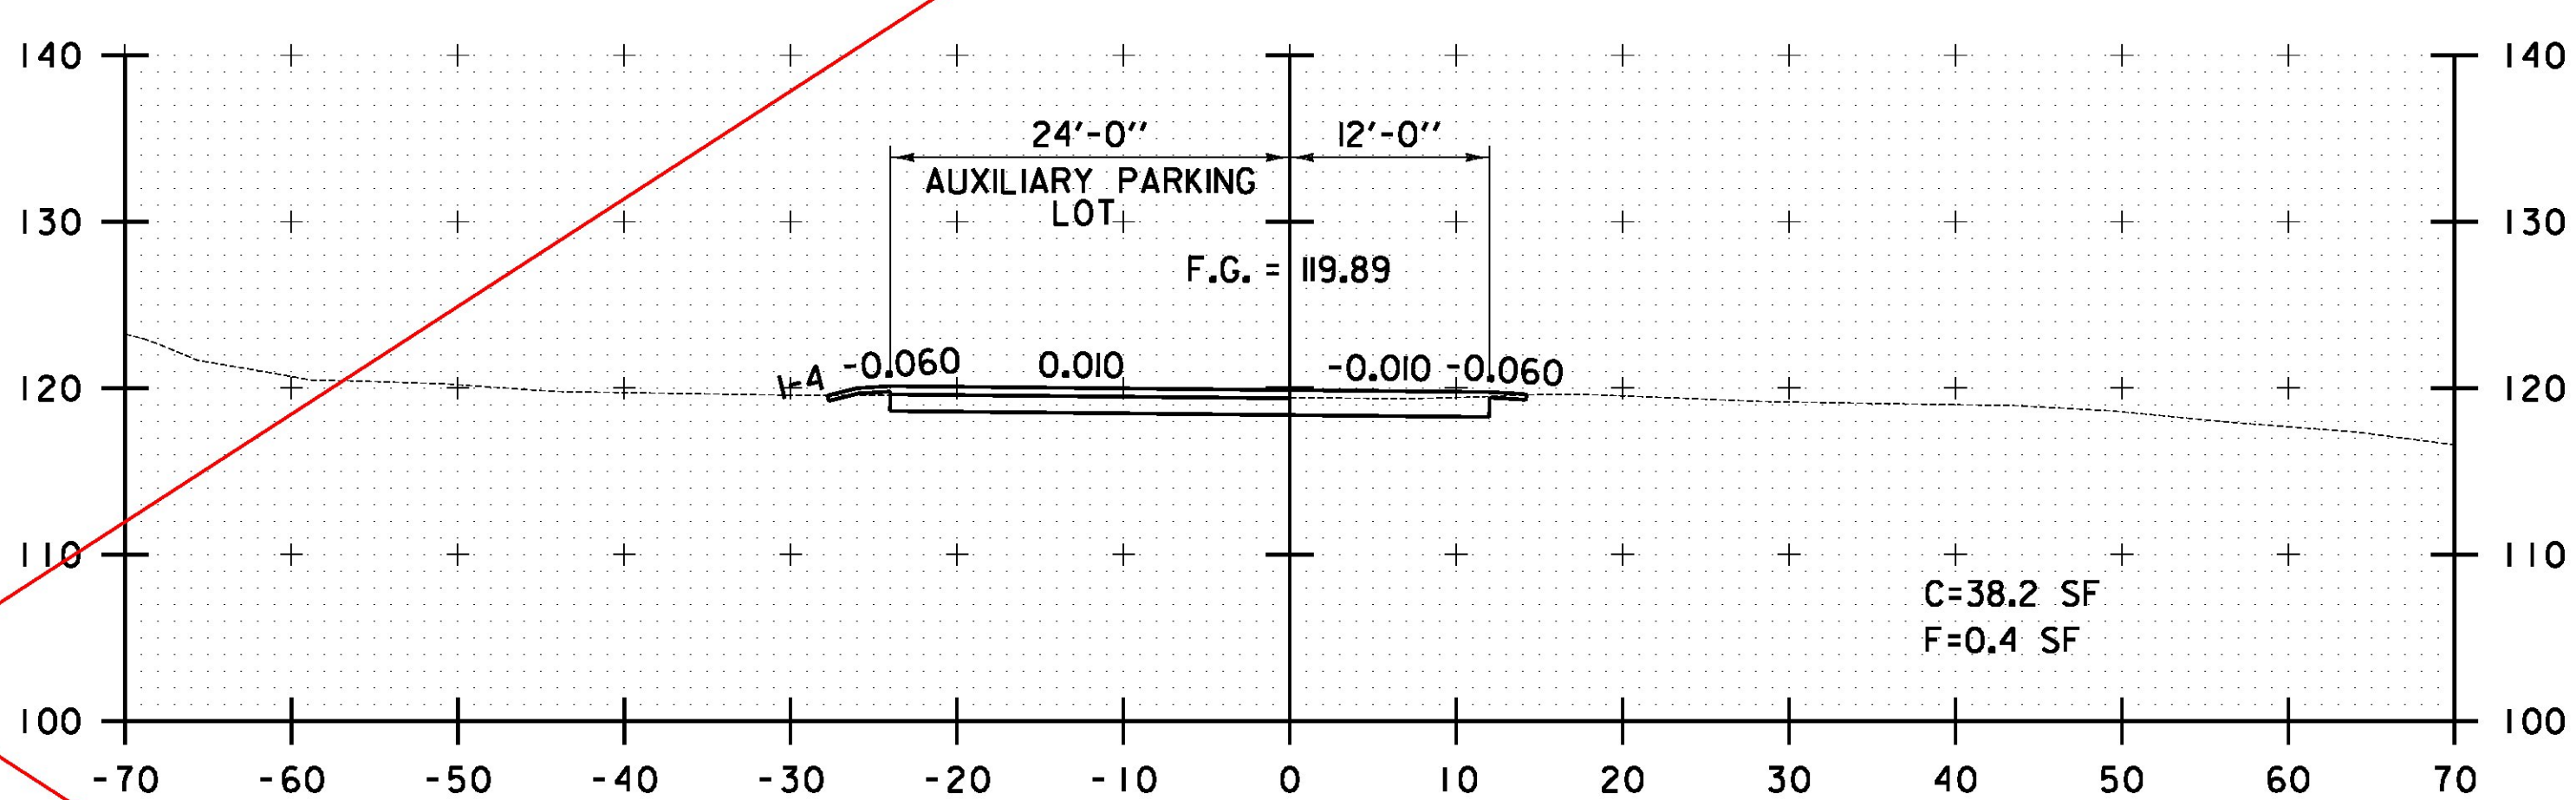

P 12+00

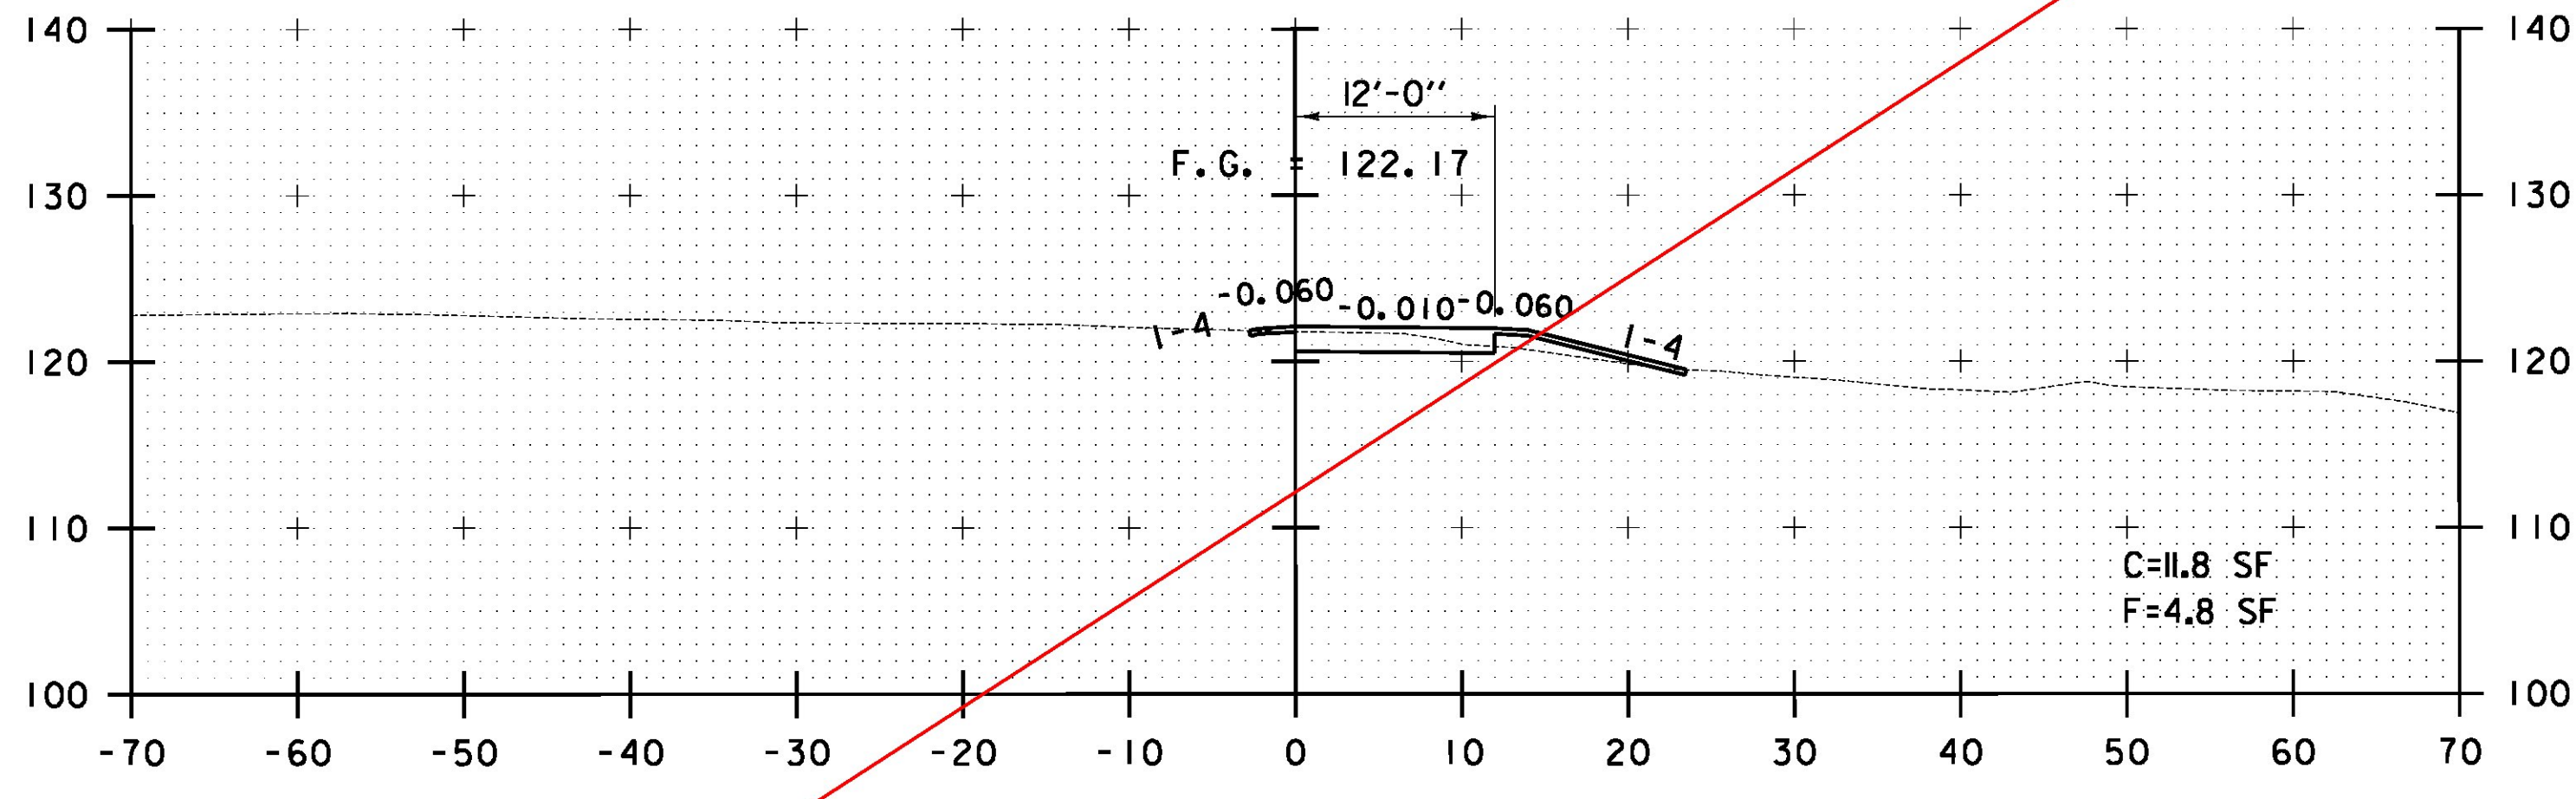


P 10+00

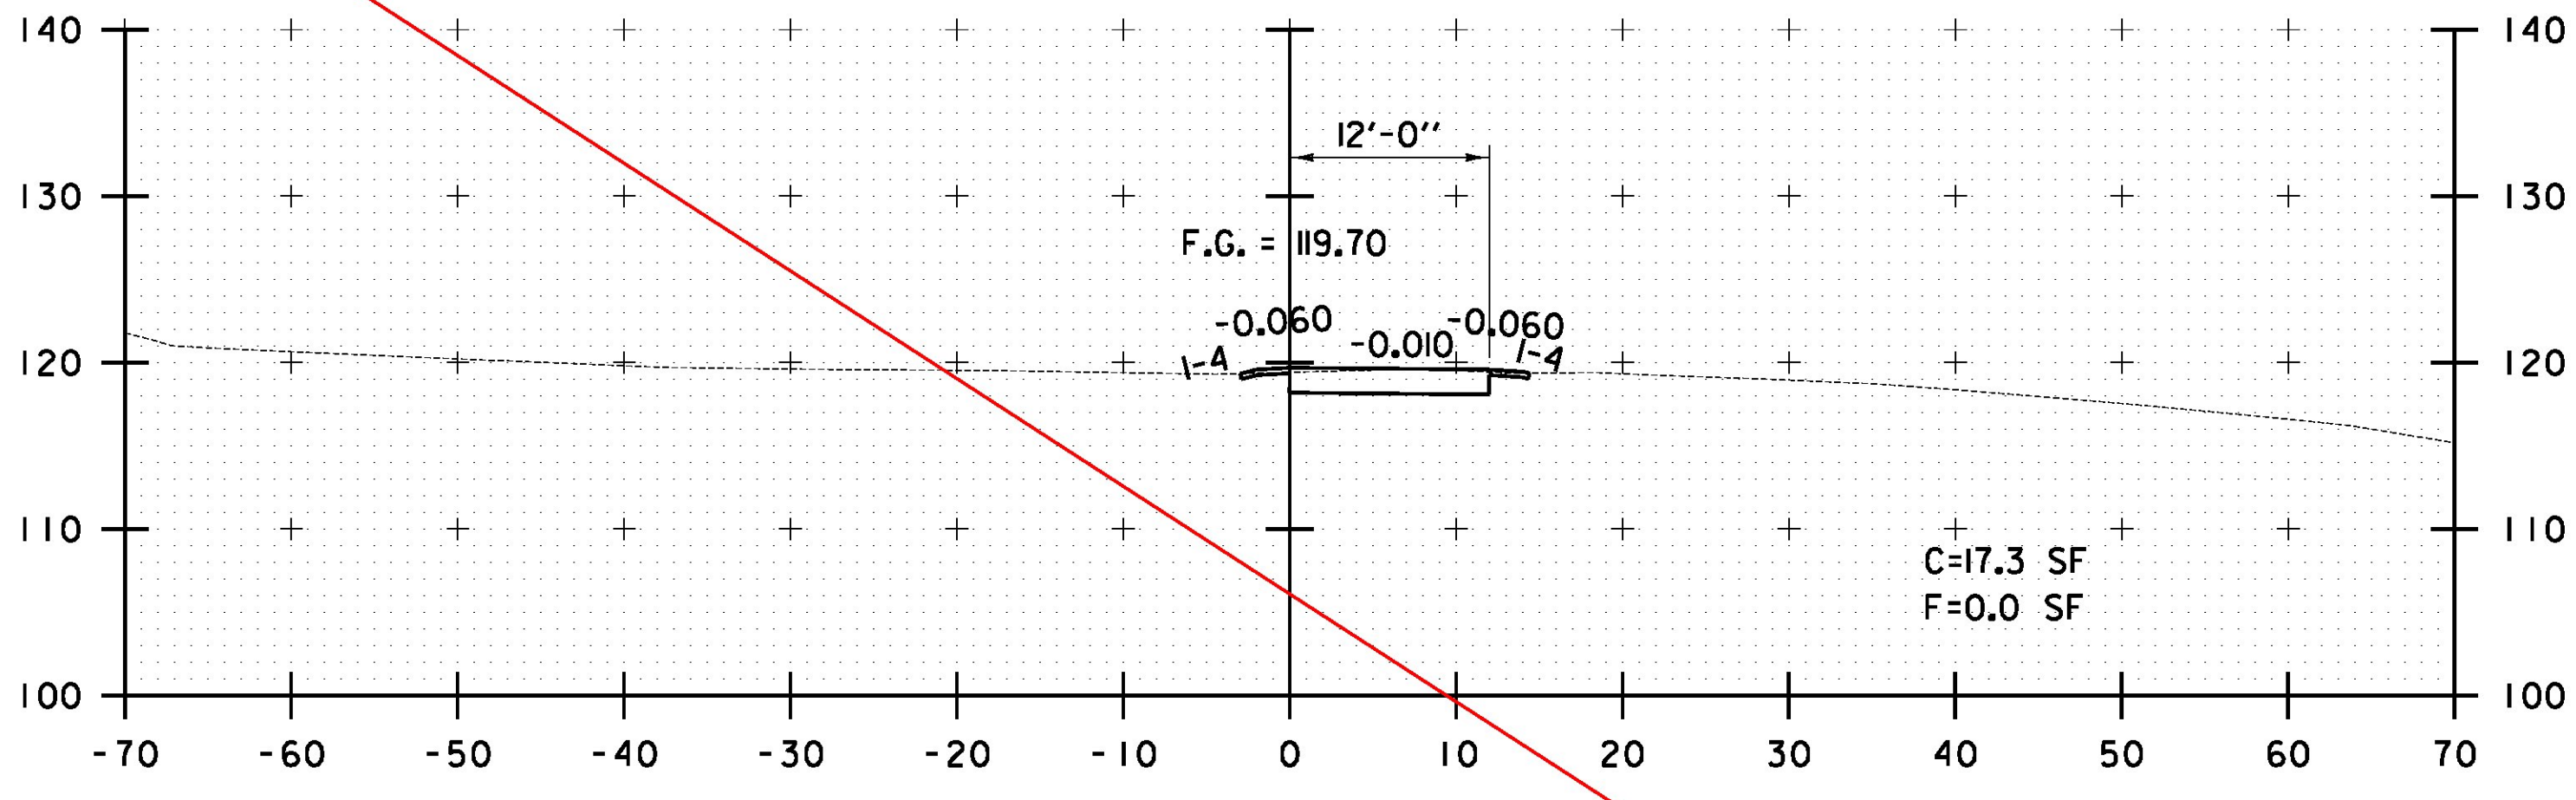

P 11+50

SEE REVISED SHEET 82A

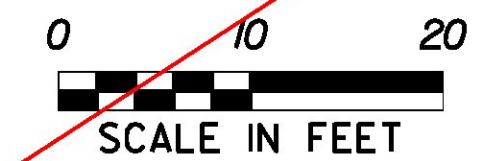

STA. P 10+00 TO STA. P 12+50

FILE NAME = I:\2012\30\ACAD\DWG\MSTN\12\2012\2012\2012\2012.dgn
 DATE/TIME = 7/12/2012
 USER = 4666

CROSS SECTION SHEET #8	PROJECT NAME: LAKE CHAMPLAIN SITE RESTORATION
	PROJECT NUMBER: STP 032-1(I8)
	FILE NAME: z12E008_xsec.03.dgn
	PLOT DATE: 7/12/2012
	DRAWN BY: W.G.P.
	CHECKED BY: D.E.G.
	DESIGNED BY: B.T.H.
	DWG. NO.: XS-8
	SHEET 82 OF 100