




P 11+00

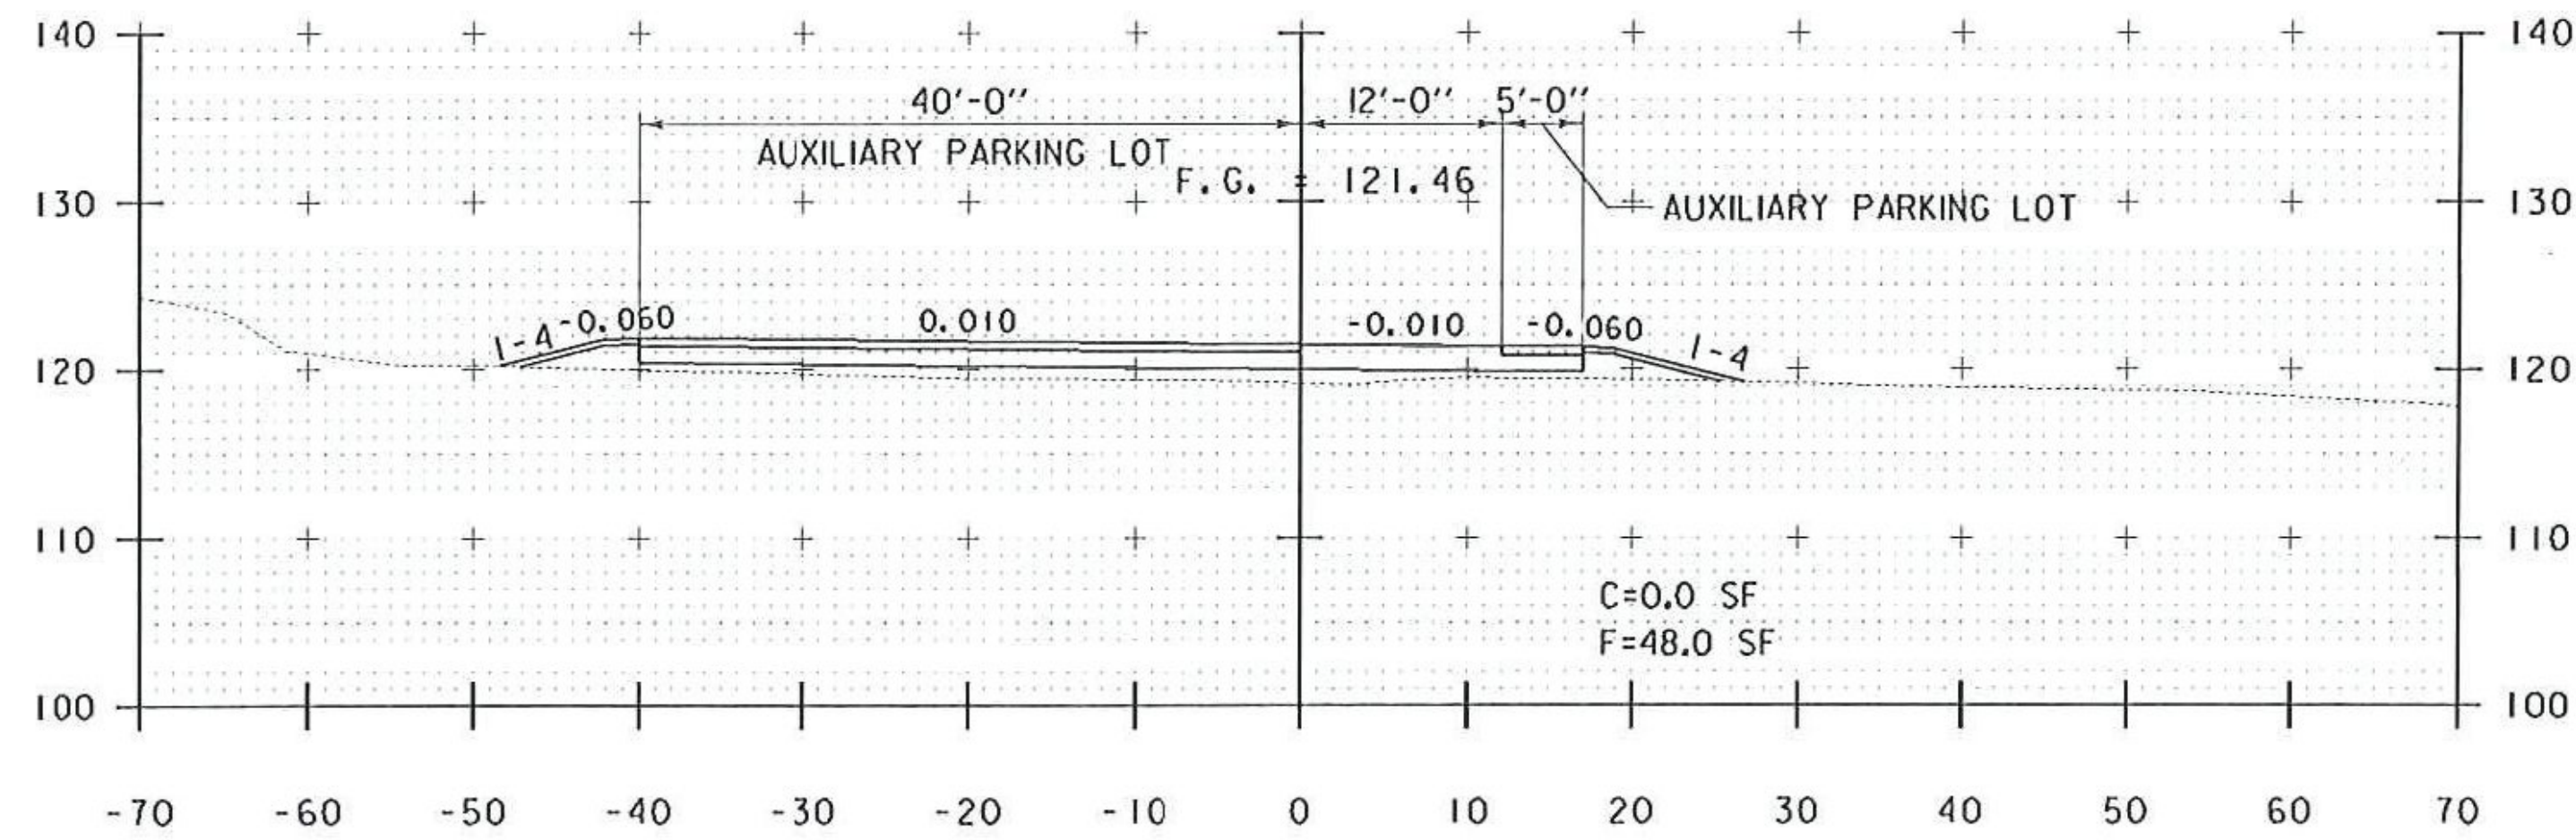


P 12+50

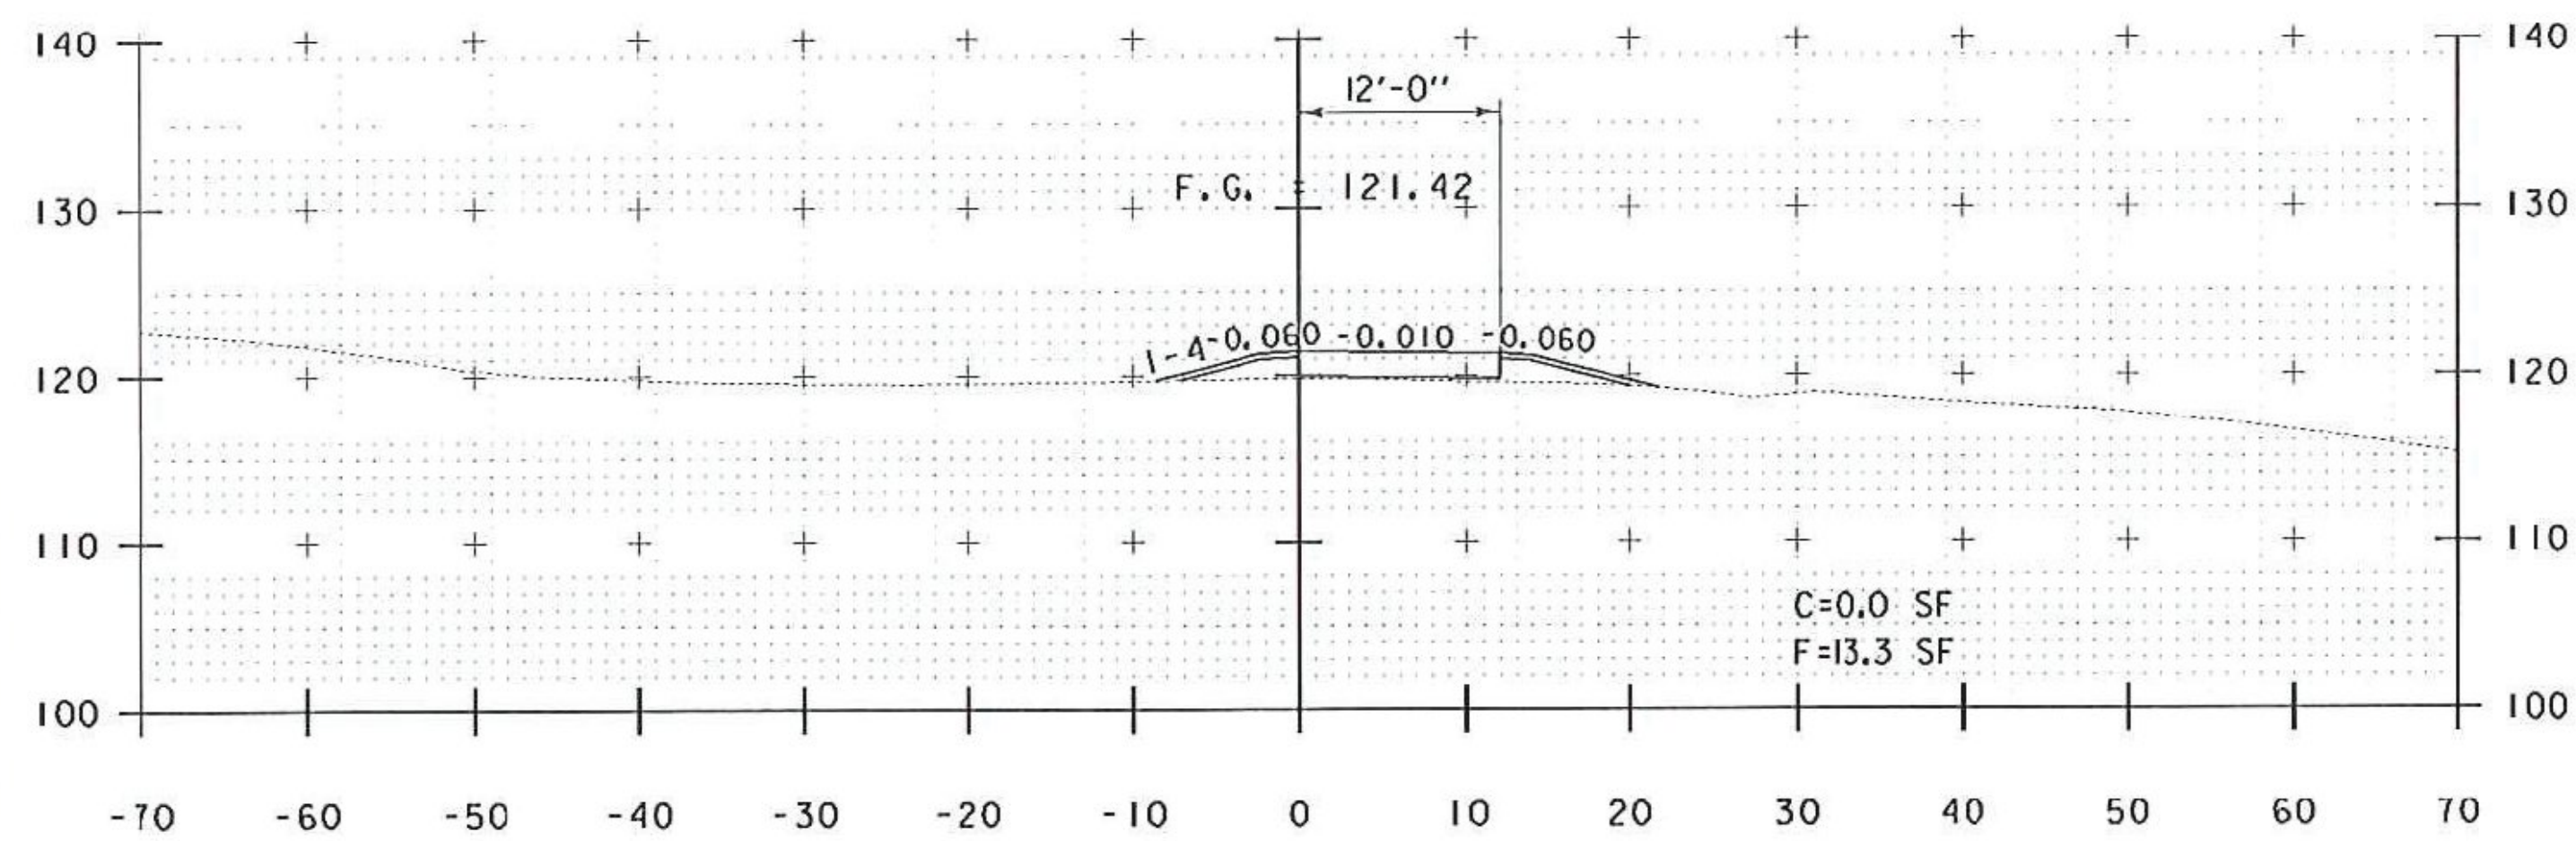


P 10+50

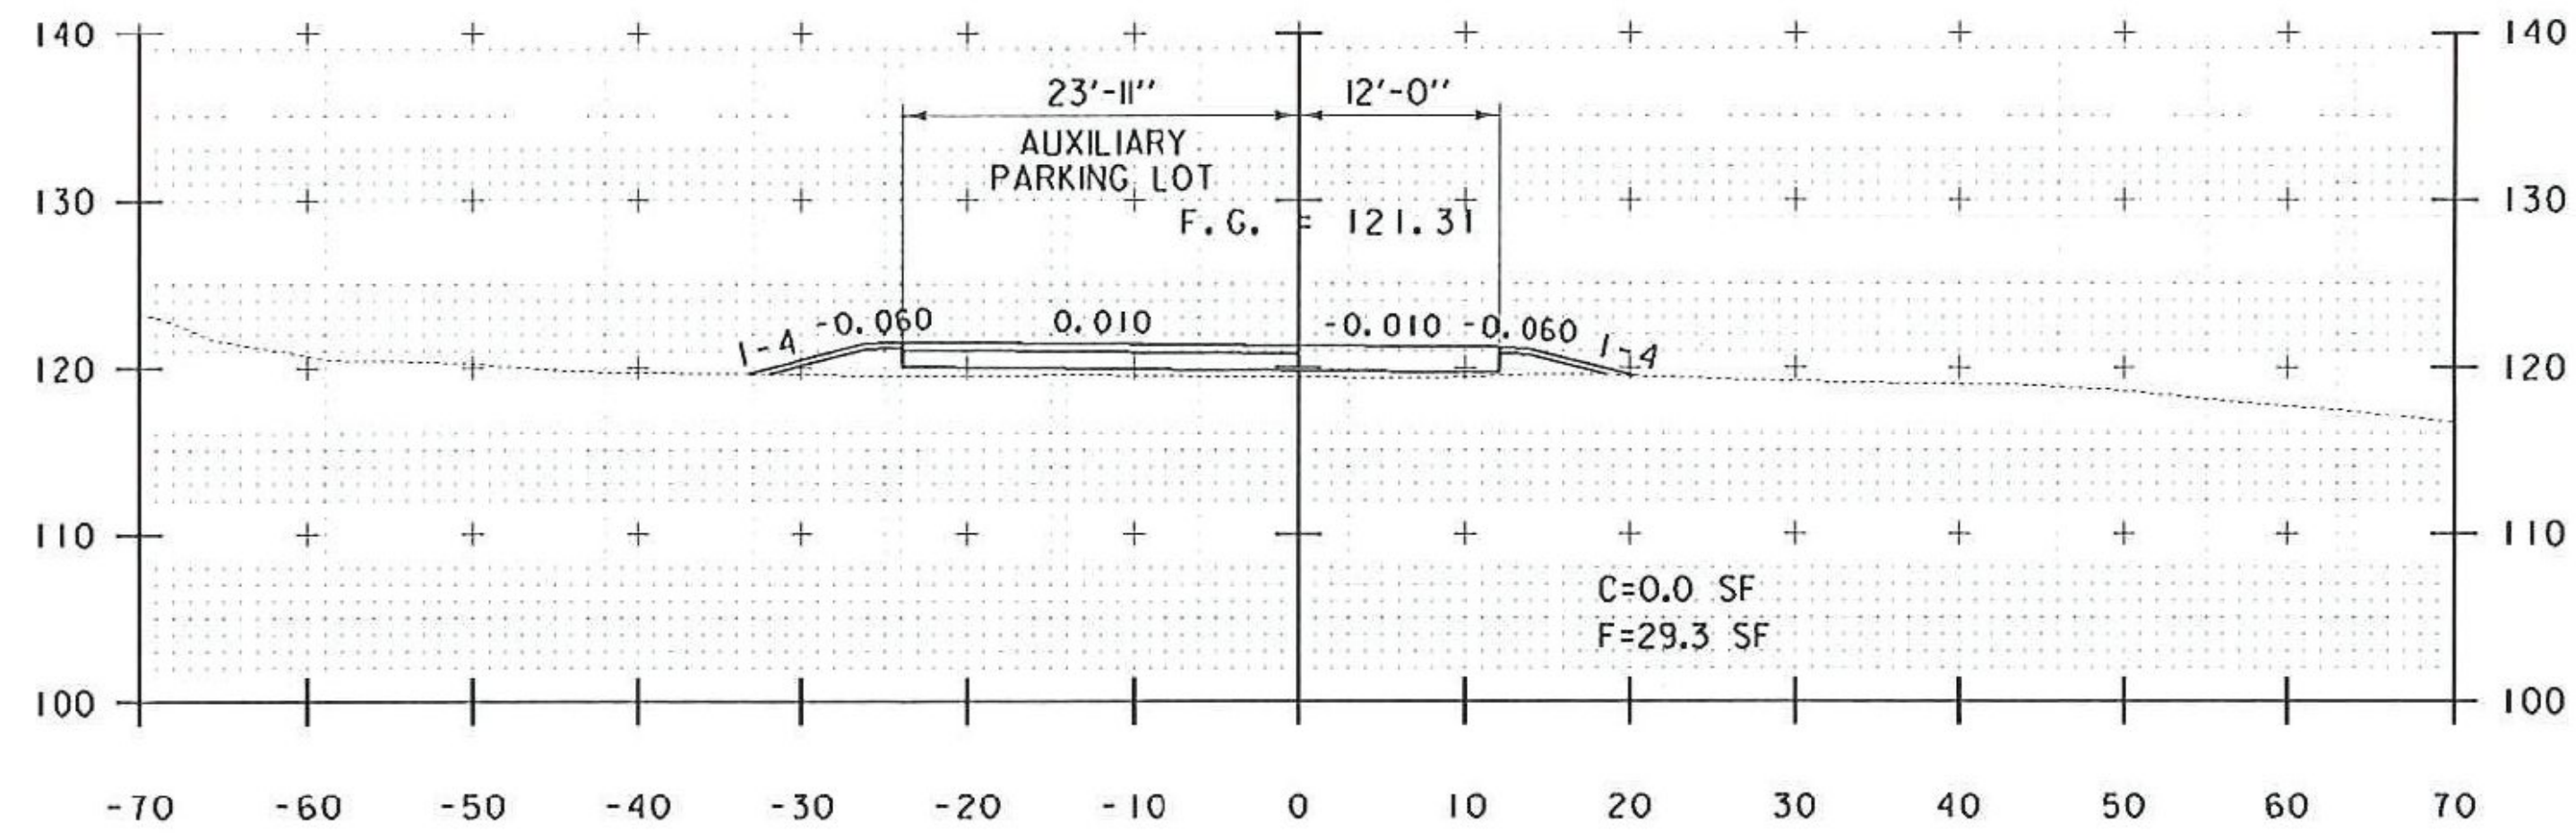

P 12+00

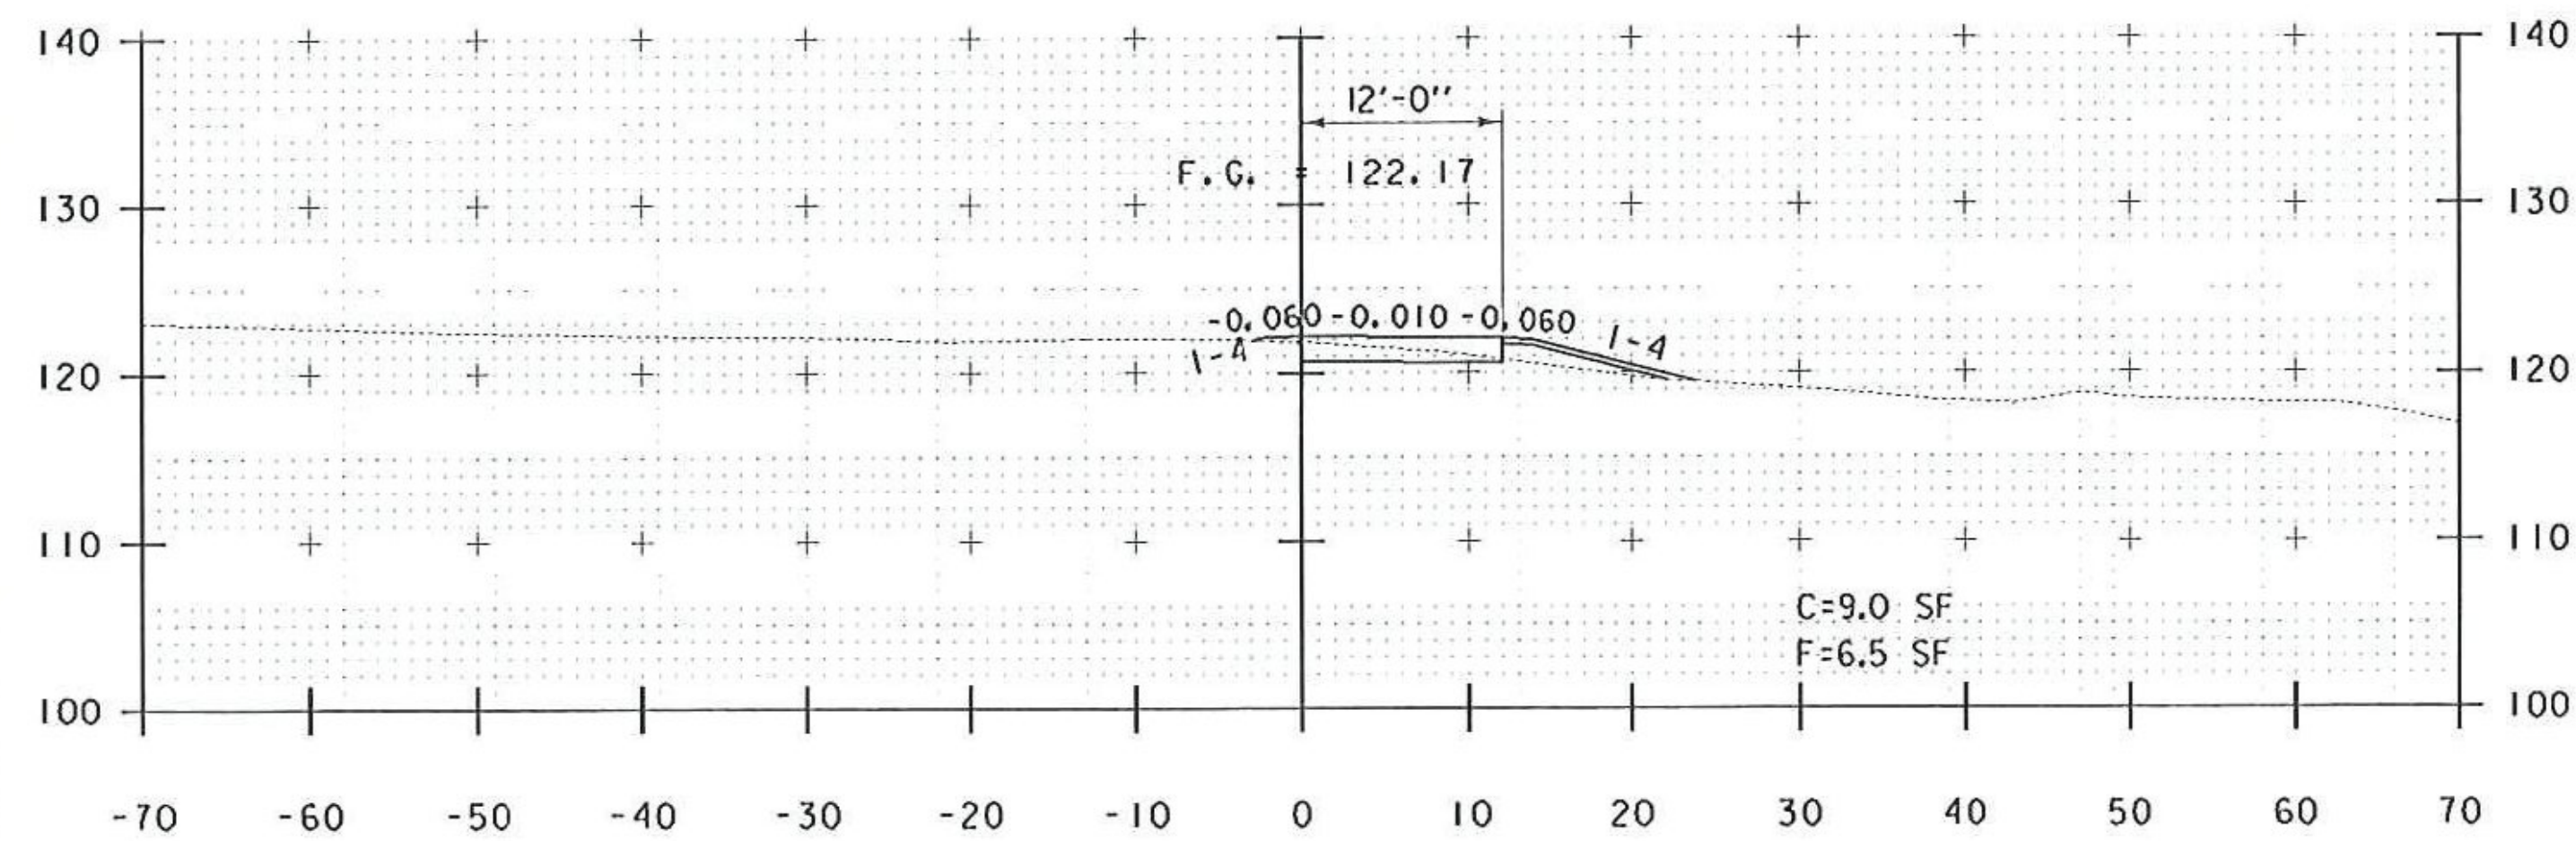

P 10+00

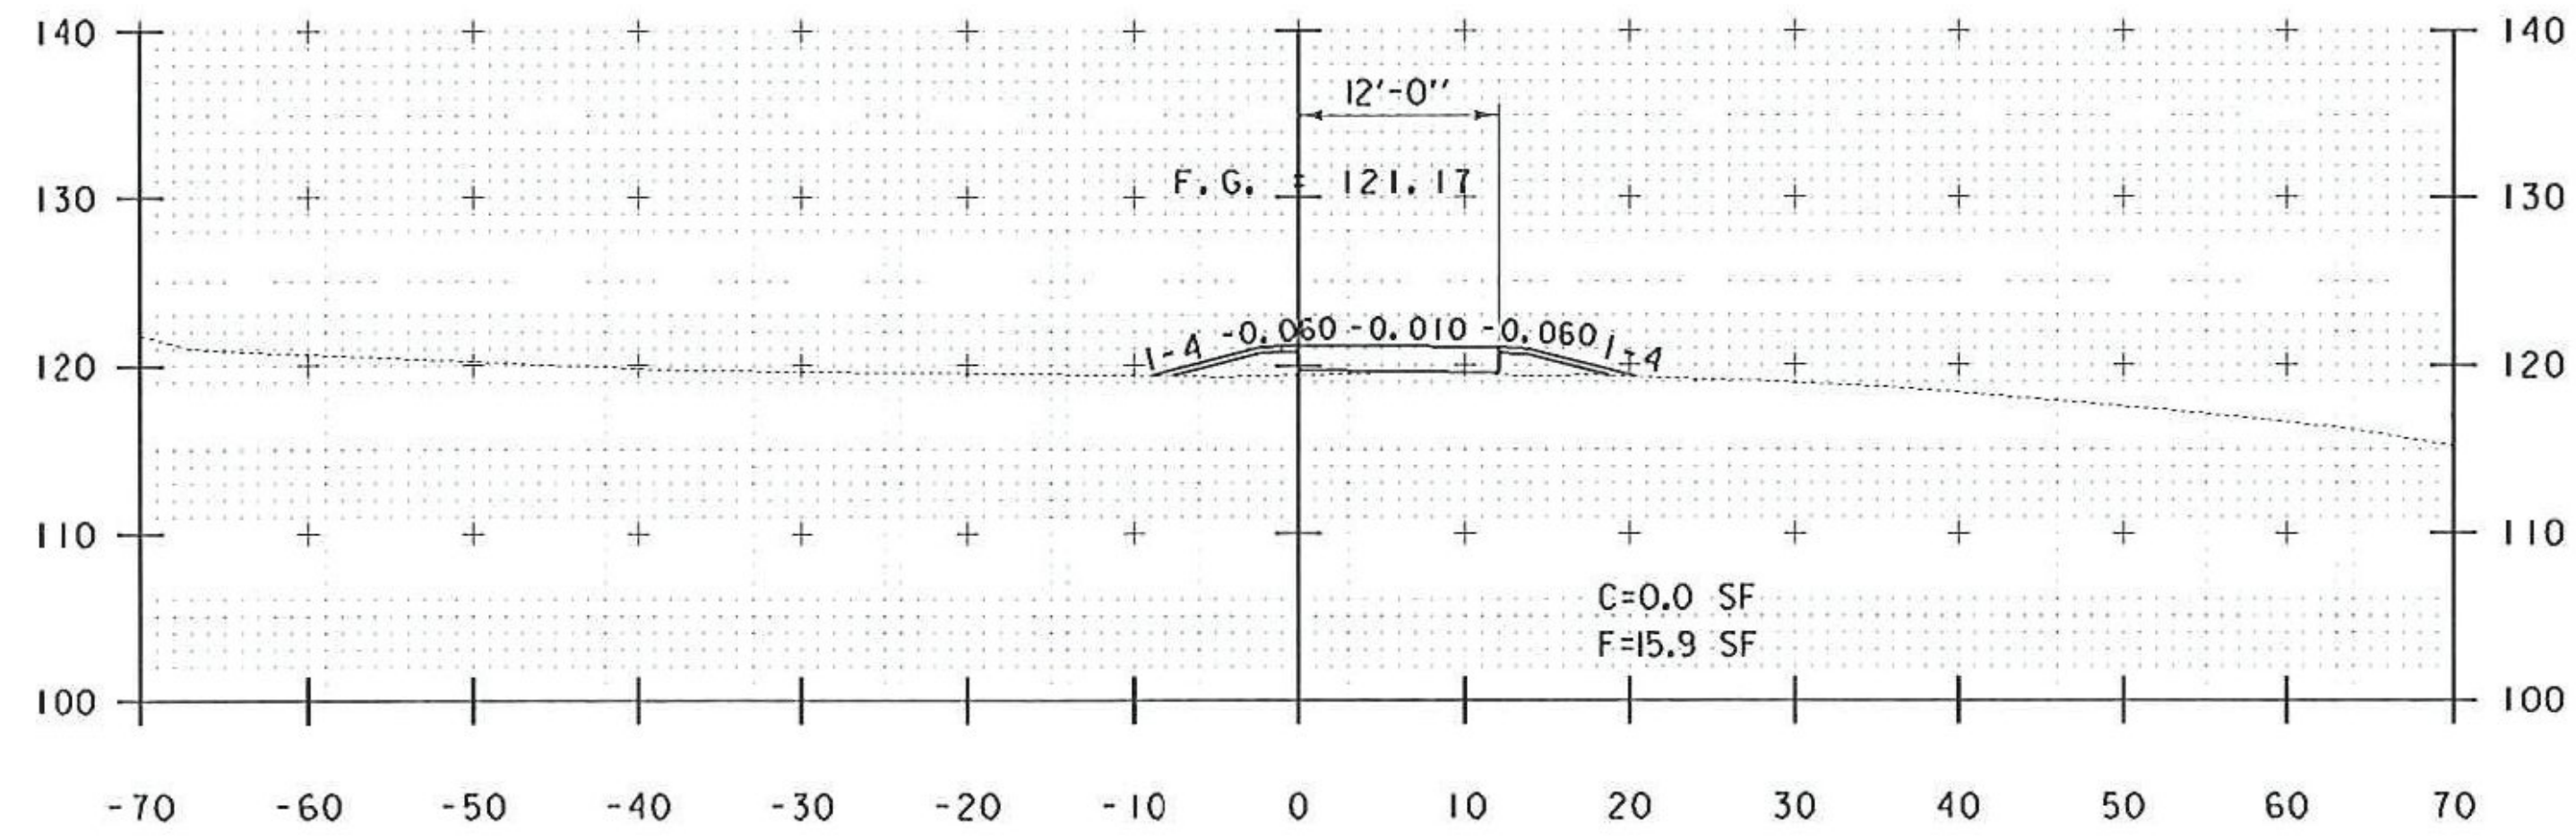

P 11+50

FILE NAME: I:\2013\CHAMPLAIN\STP\12E008_12E008.xsec_03.dgn
 DATE/TIME: 4/3/2013
 USER: 4866



REVISED APRIL 1, 2013

CROSS SECTION SHEET #8

PROJECT NAME: LAKE CHAMPLAIN SITE RESTORATION	PLOT DATE: 4/3/2013
PROJECT NUMBER: STP 032-K(18)	DRAWN BY: W.G.P.
FILE NAME: z12E008_xsec_03.dgn	CHECKED BY: D.E.G.
PROJECT LEADER: D.E.G.	DESIGNED BY: B.T.H.
DWG. NO.: XS-8	SHEET 82A OF 100