




P 14+00

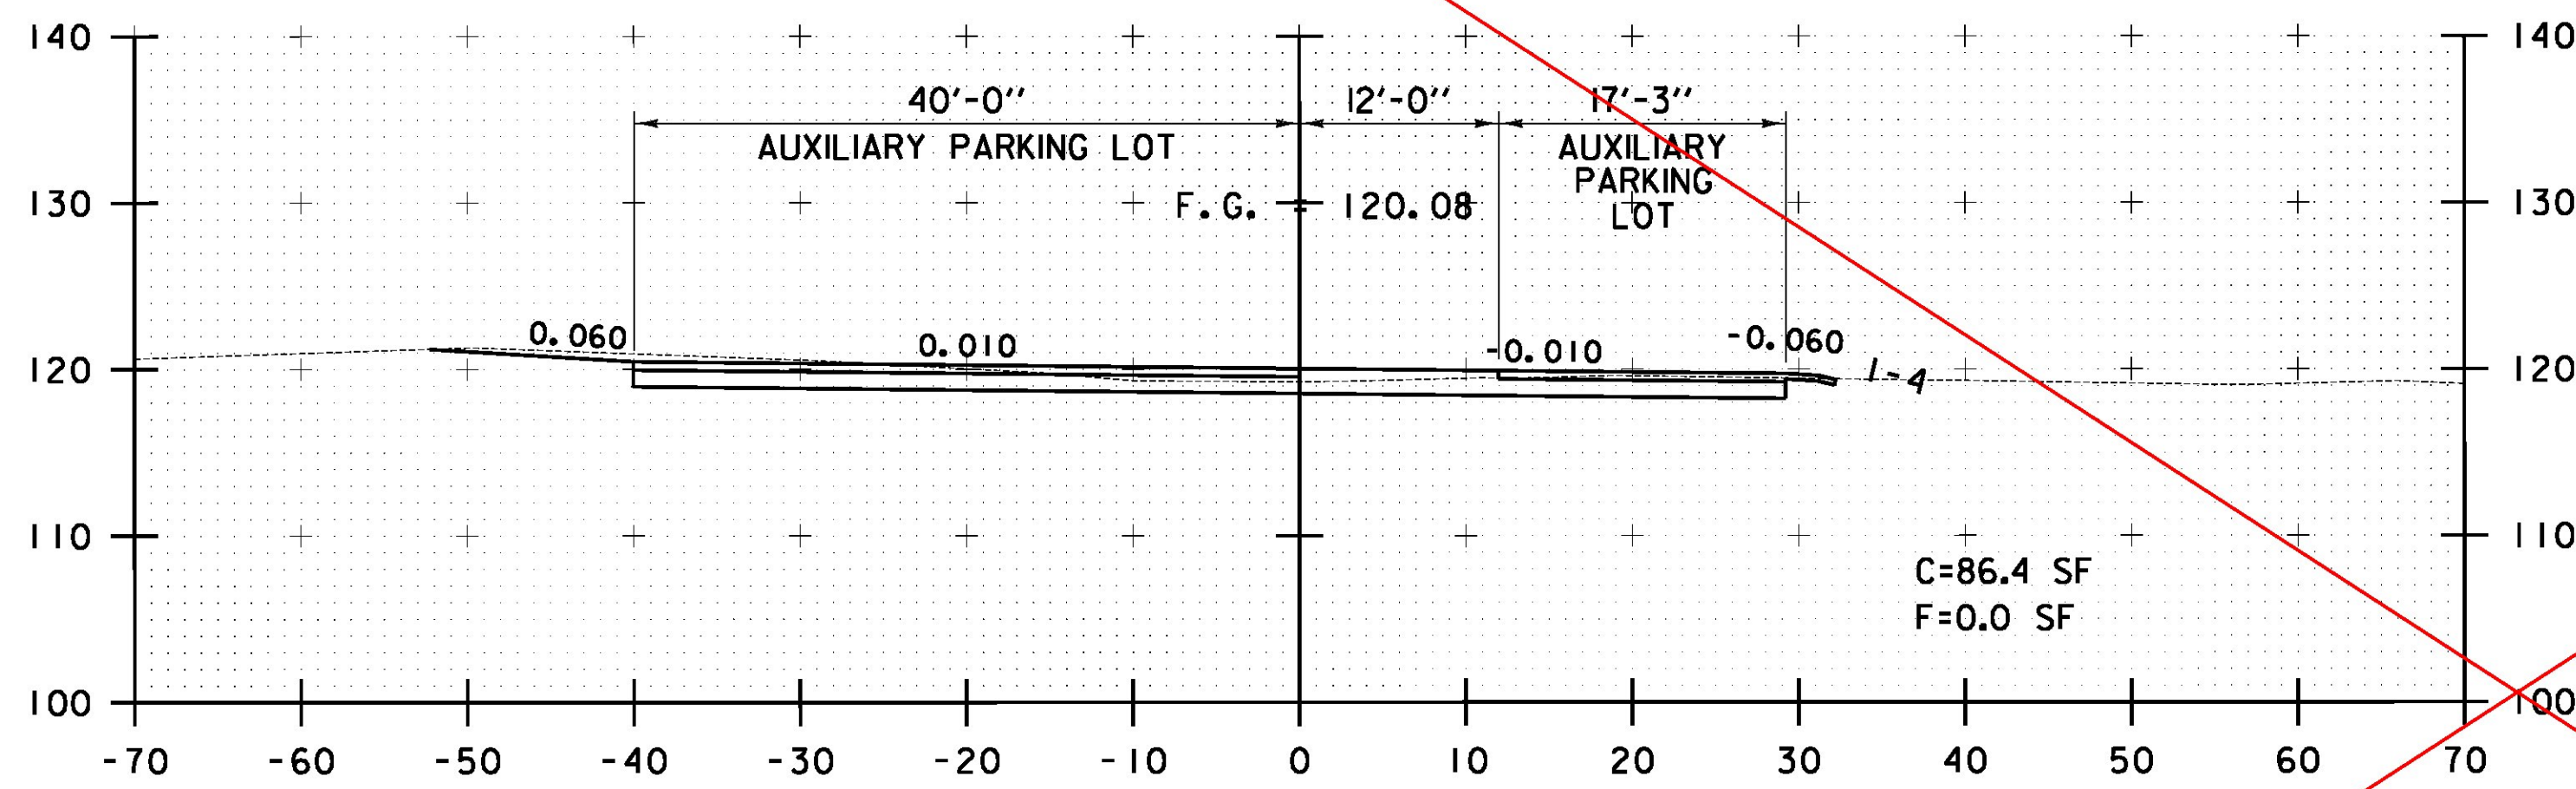


P 13+50

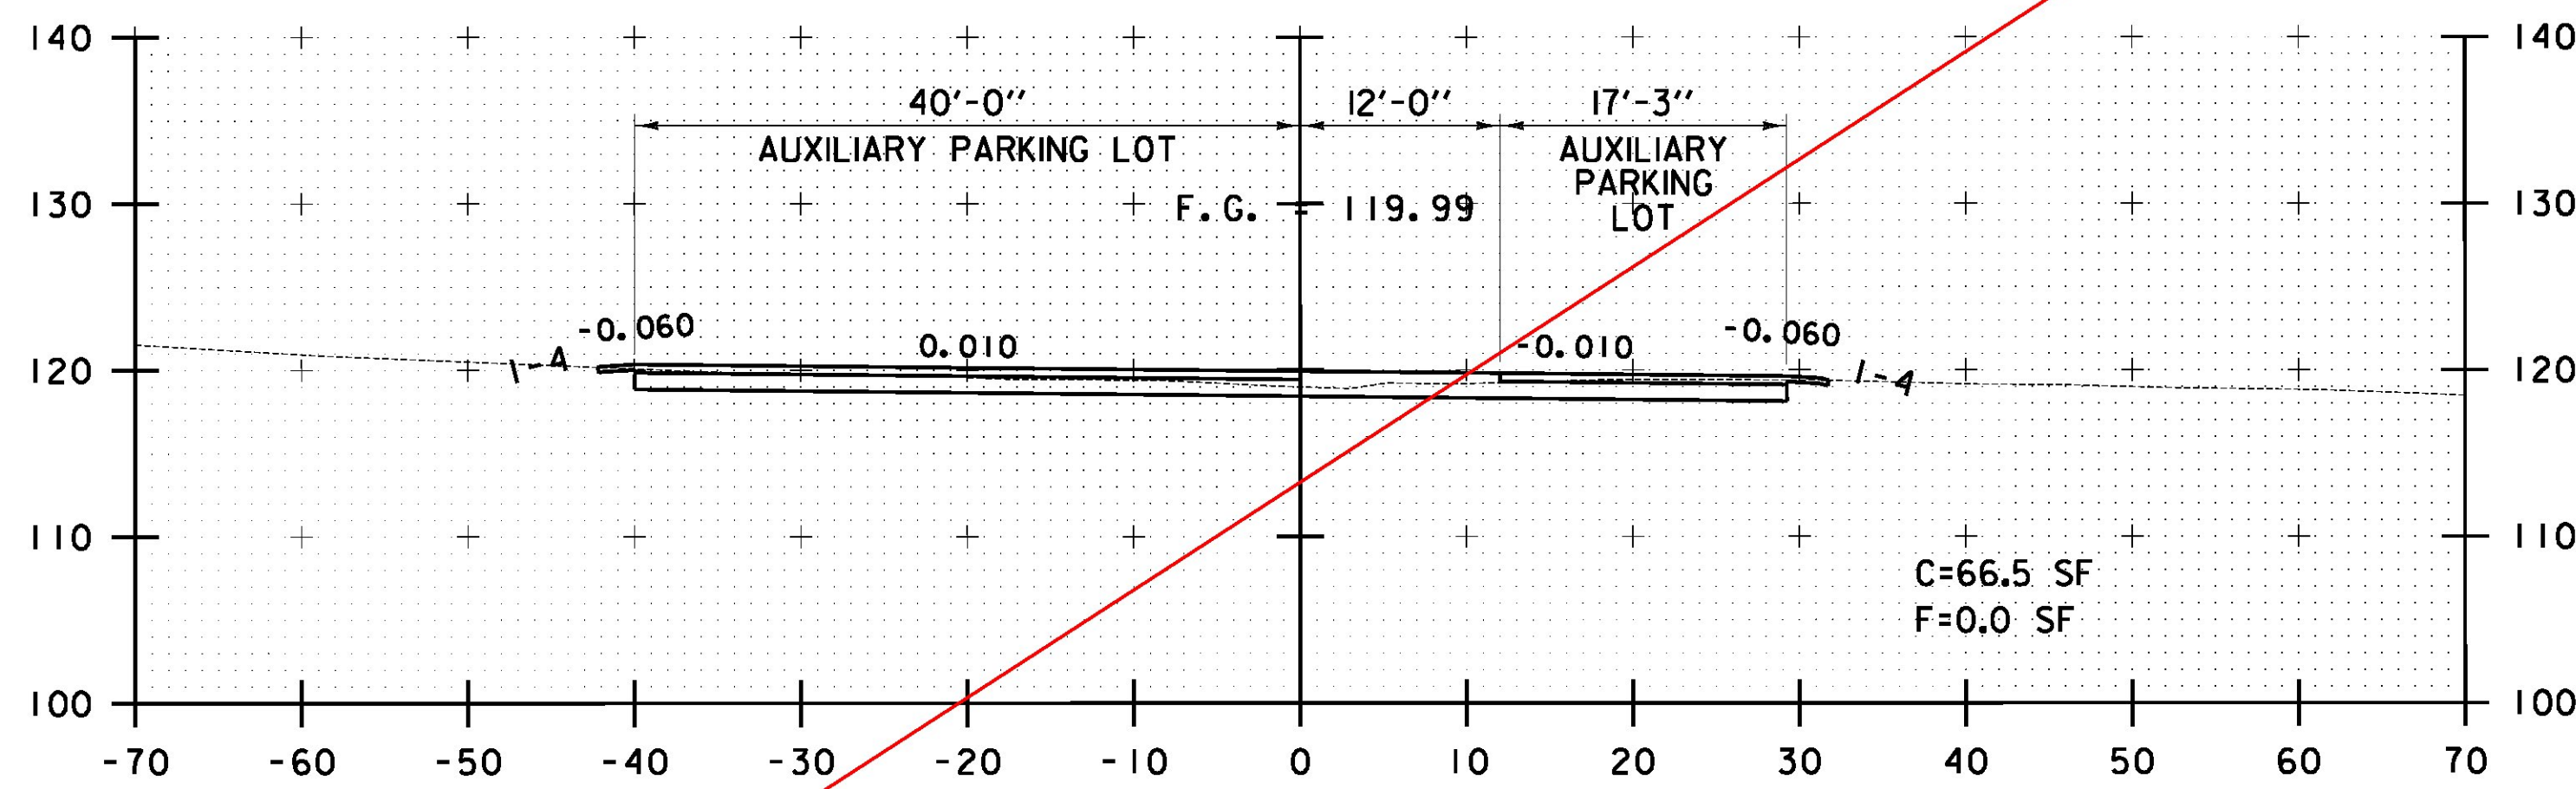

P 13+00

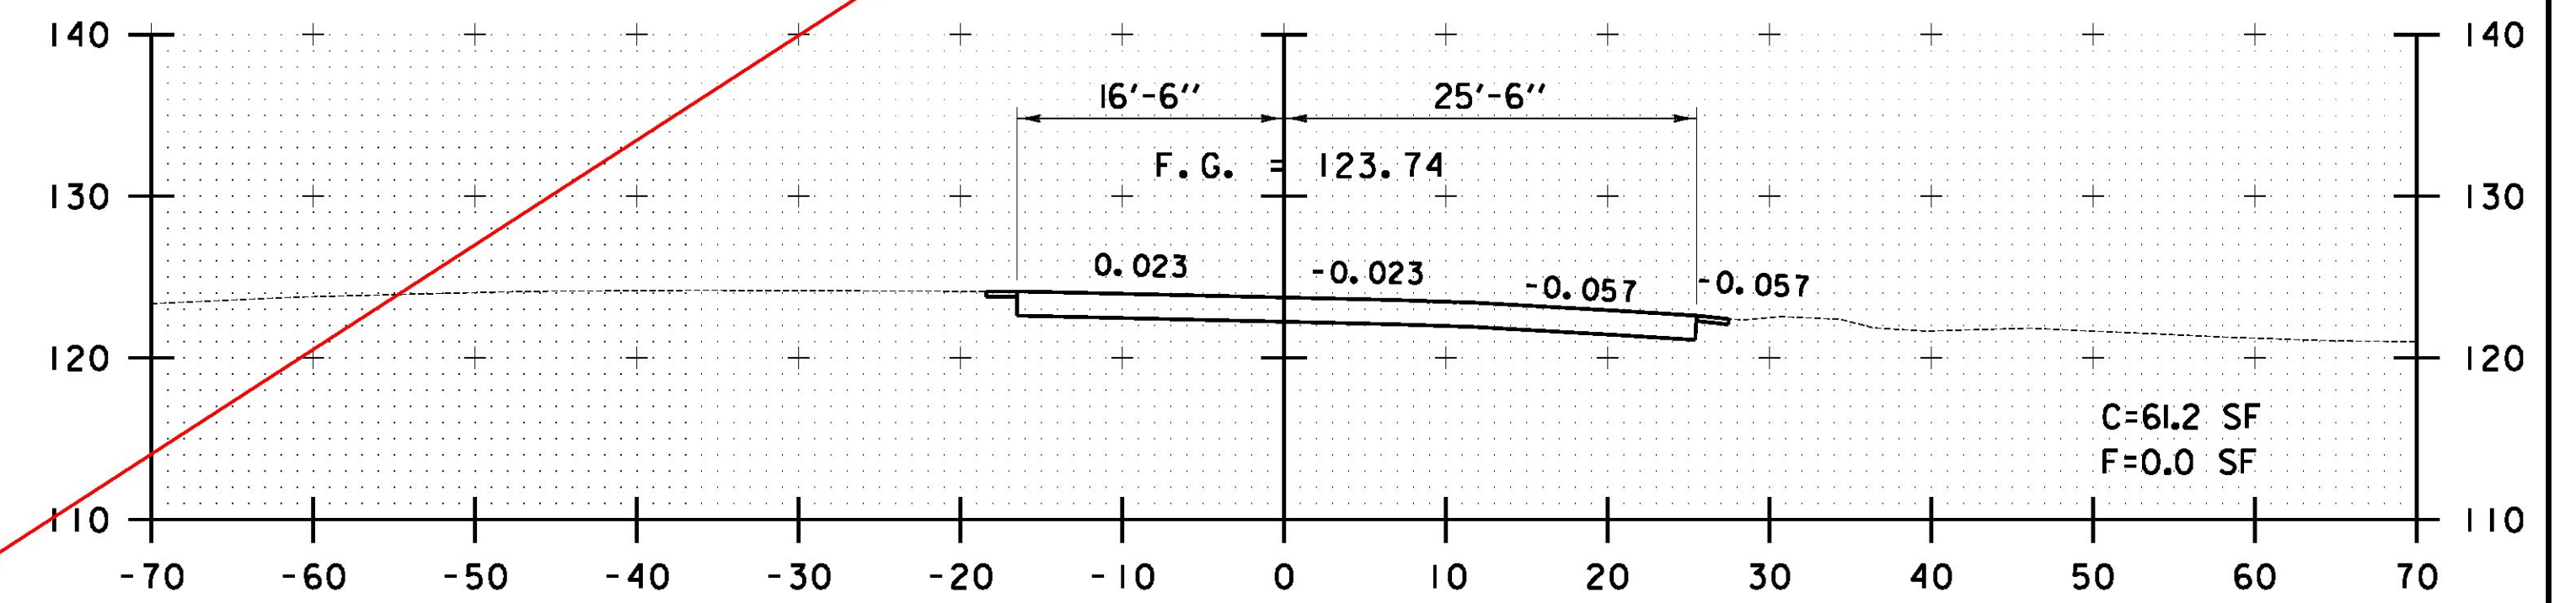


P 14+60

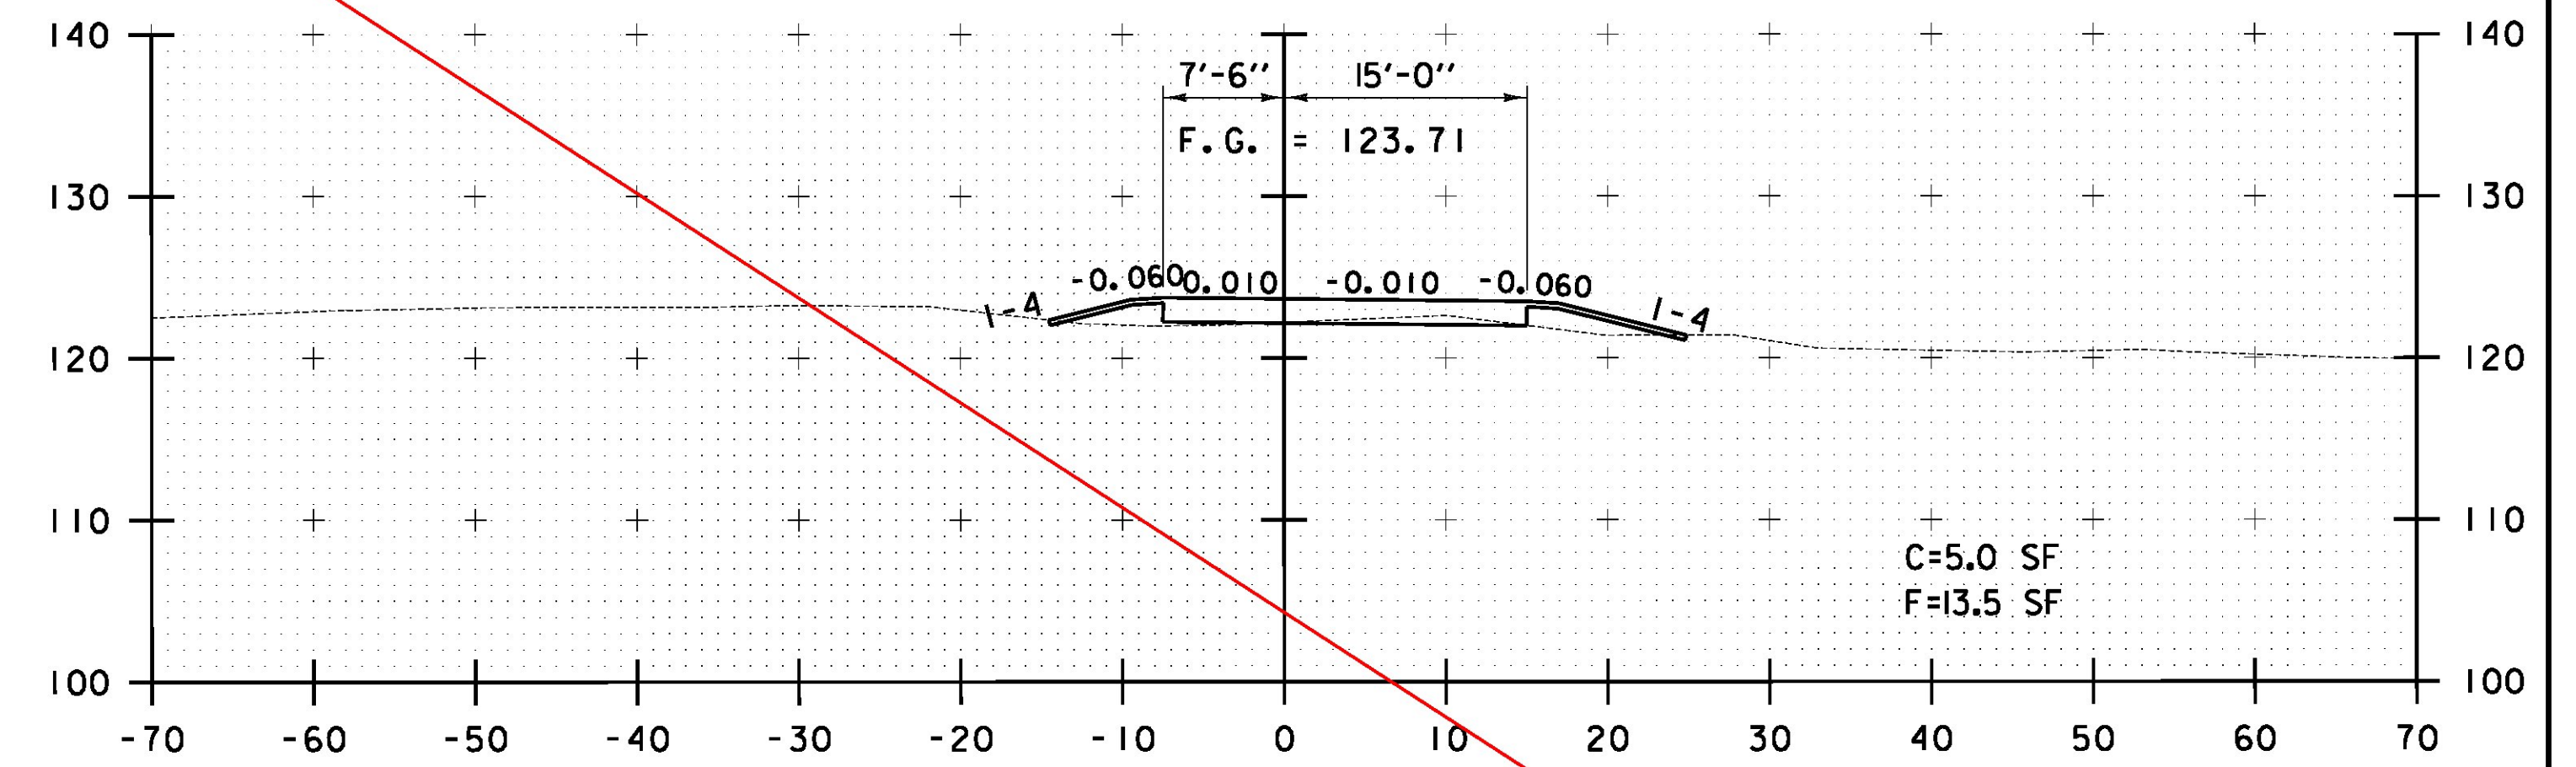

P 14+50

SEE REVISED SHEET 83A

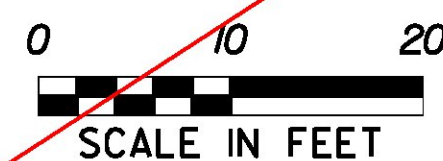

STA. P 13+00 TO STA. P 14+60

FILE NAME = I:\2008\30\CA\DD\MSTN\12\2008_xsec_03.dgn
 DATE/TIME = 7/12/2012
 USER = 4666

CROSS SECTION SHEET #9	PROJECT NAME: LAKE CHAMPLAIN SITE RESTORATION	
	PROJECT NUMBER: STP 032-1(18)	
	FILE NAME: z12E008_xsec_03.dgn	PLOT DATE: 7/12/2012
	PROJECT LEADER: D.E.G.	DRAWN BY: W.G.P.
DESIGNED BY: B.T.H.	CHECKED BY: D.E.G.	
DWG. NO.: XS-9	SHEET 83	OF 100