




P 14+00

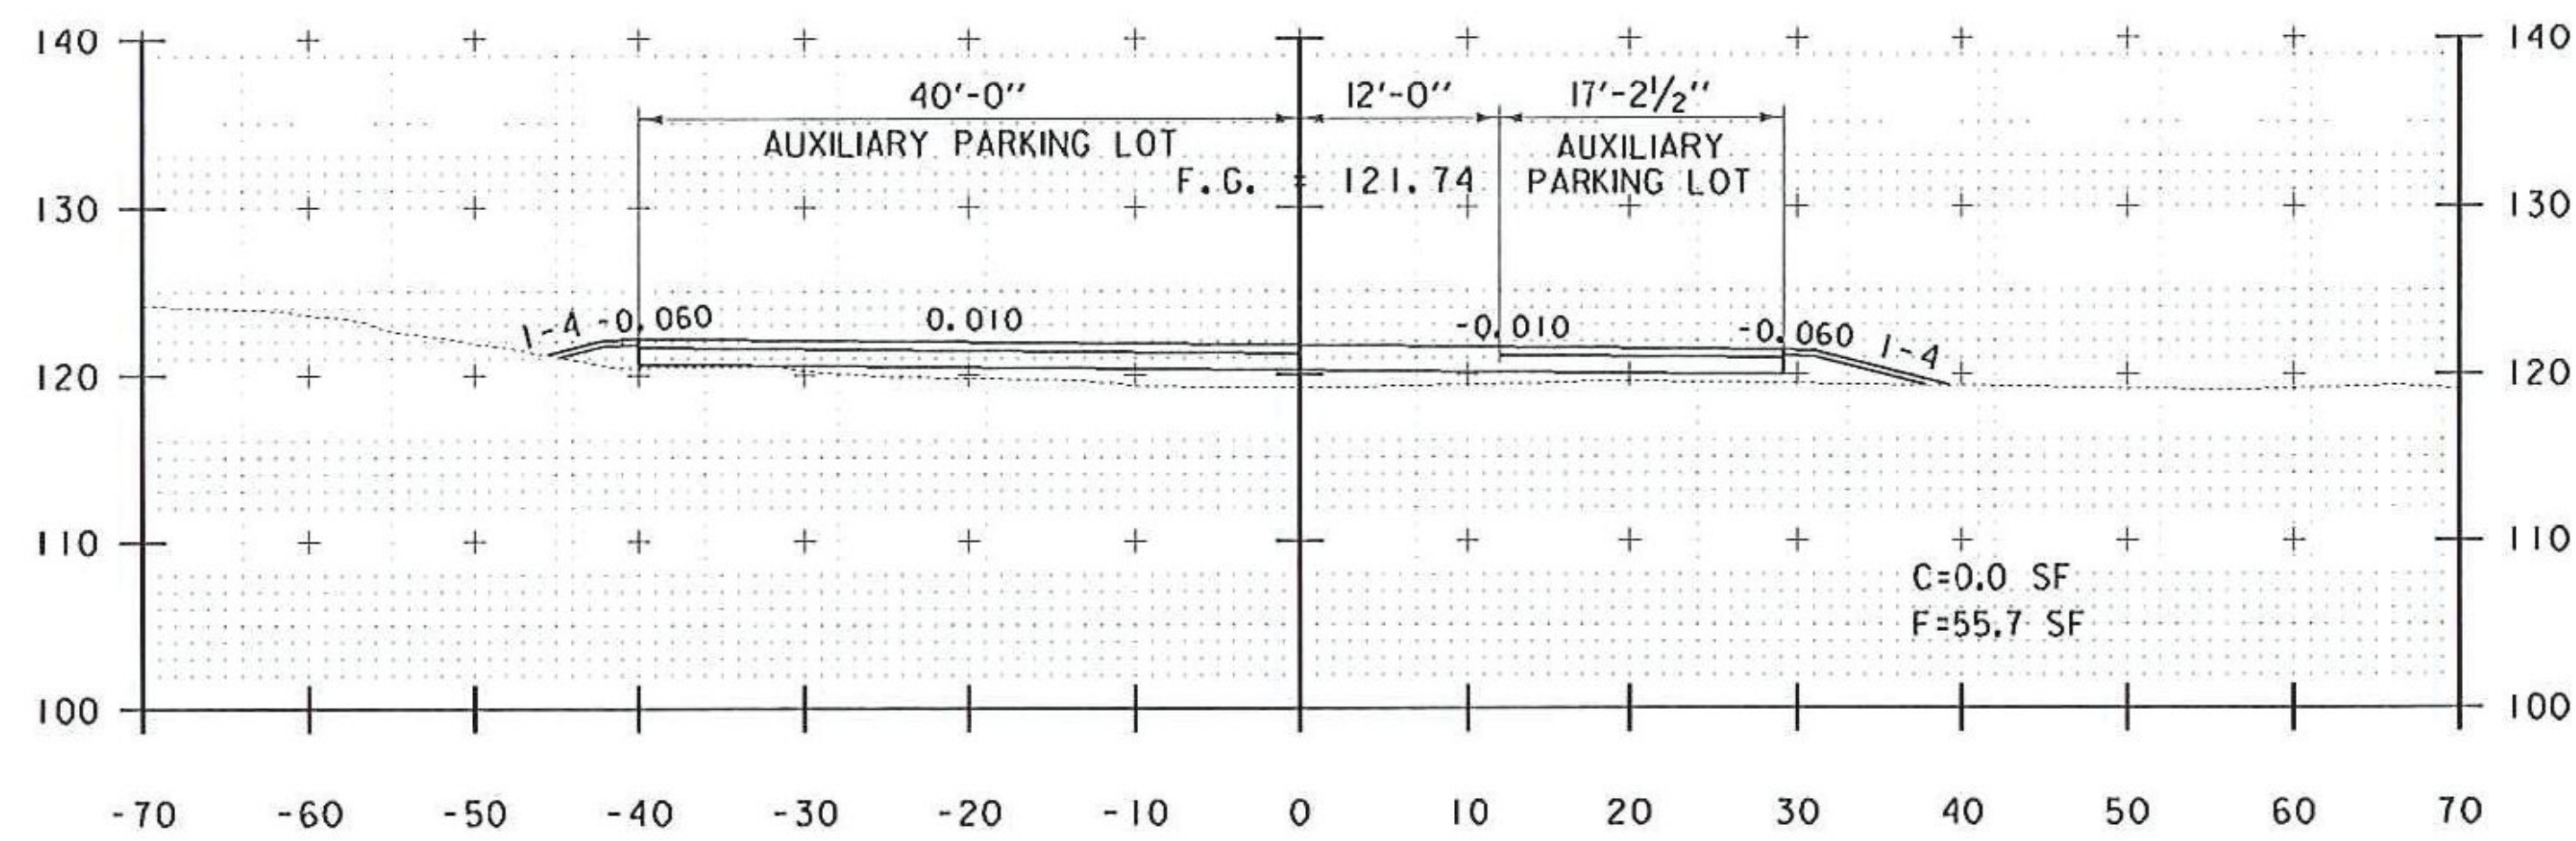


P 13+50

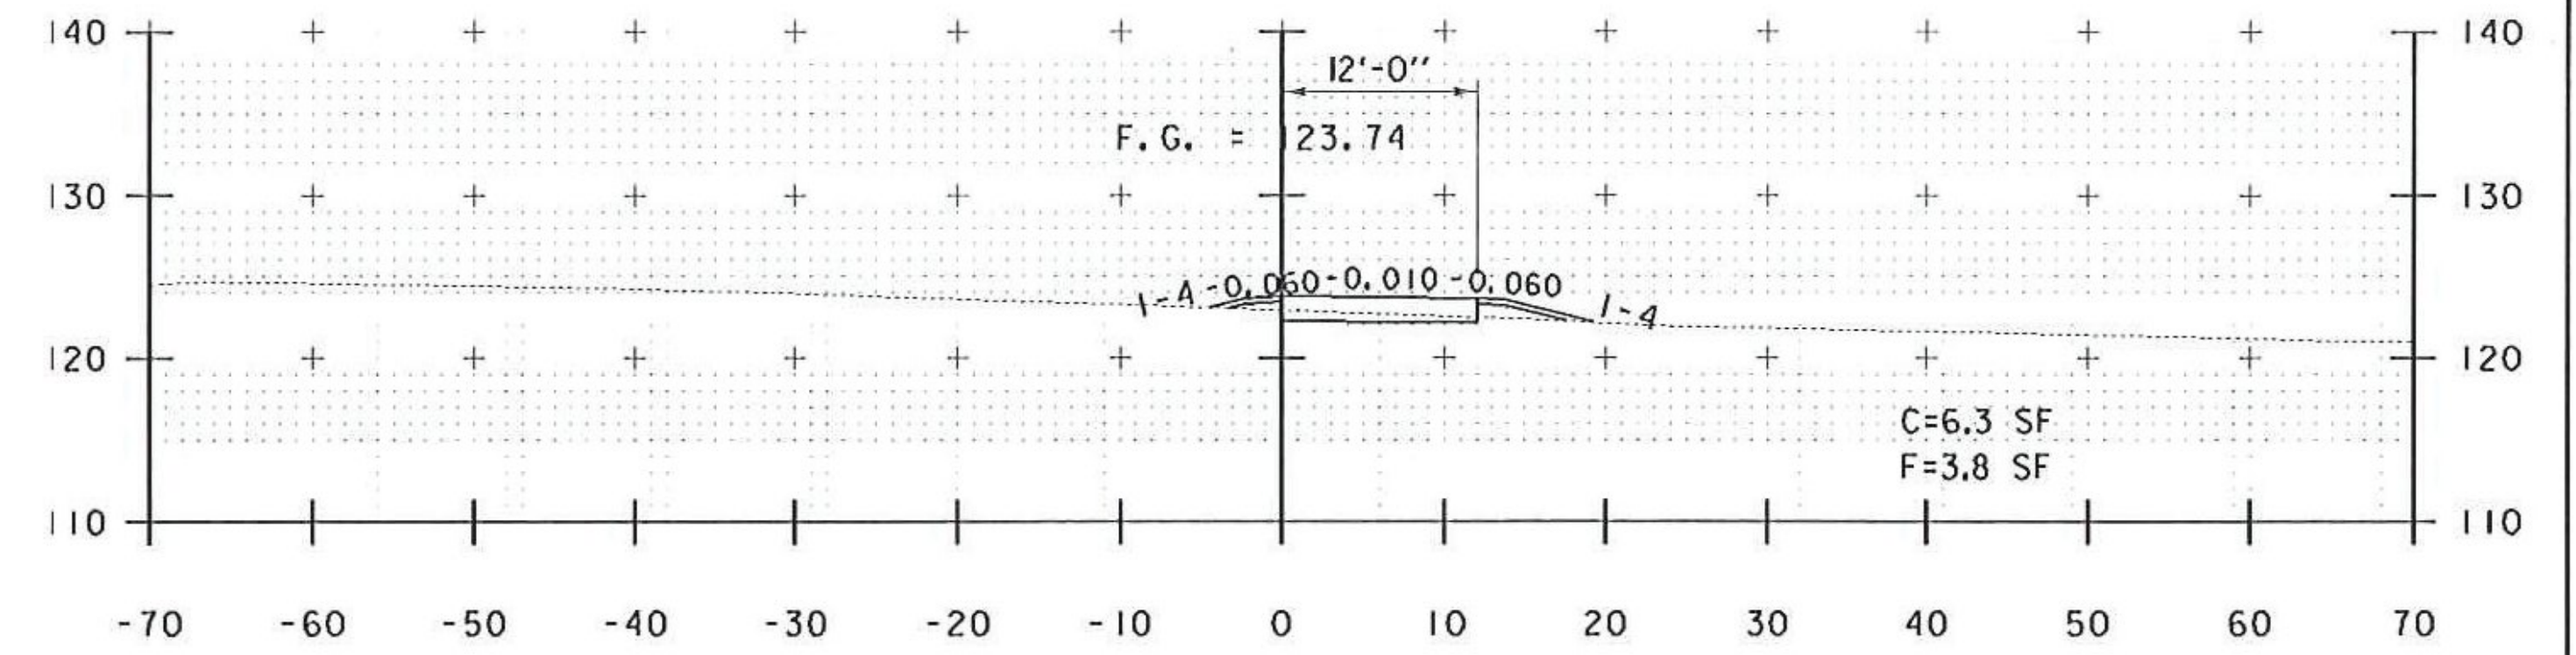

P 14+60

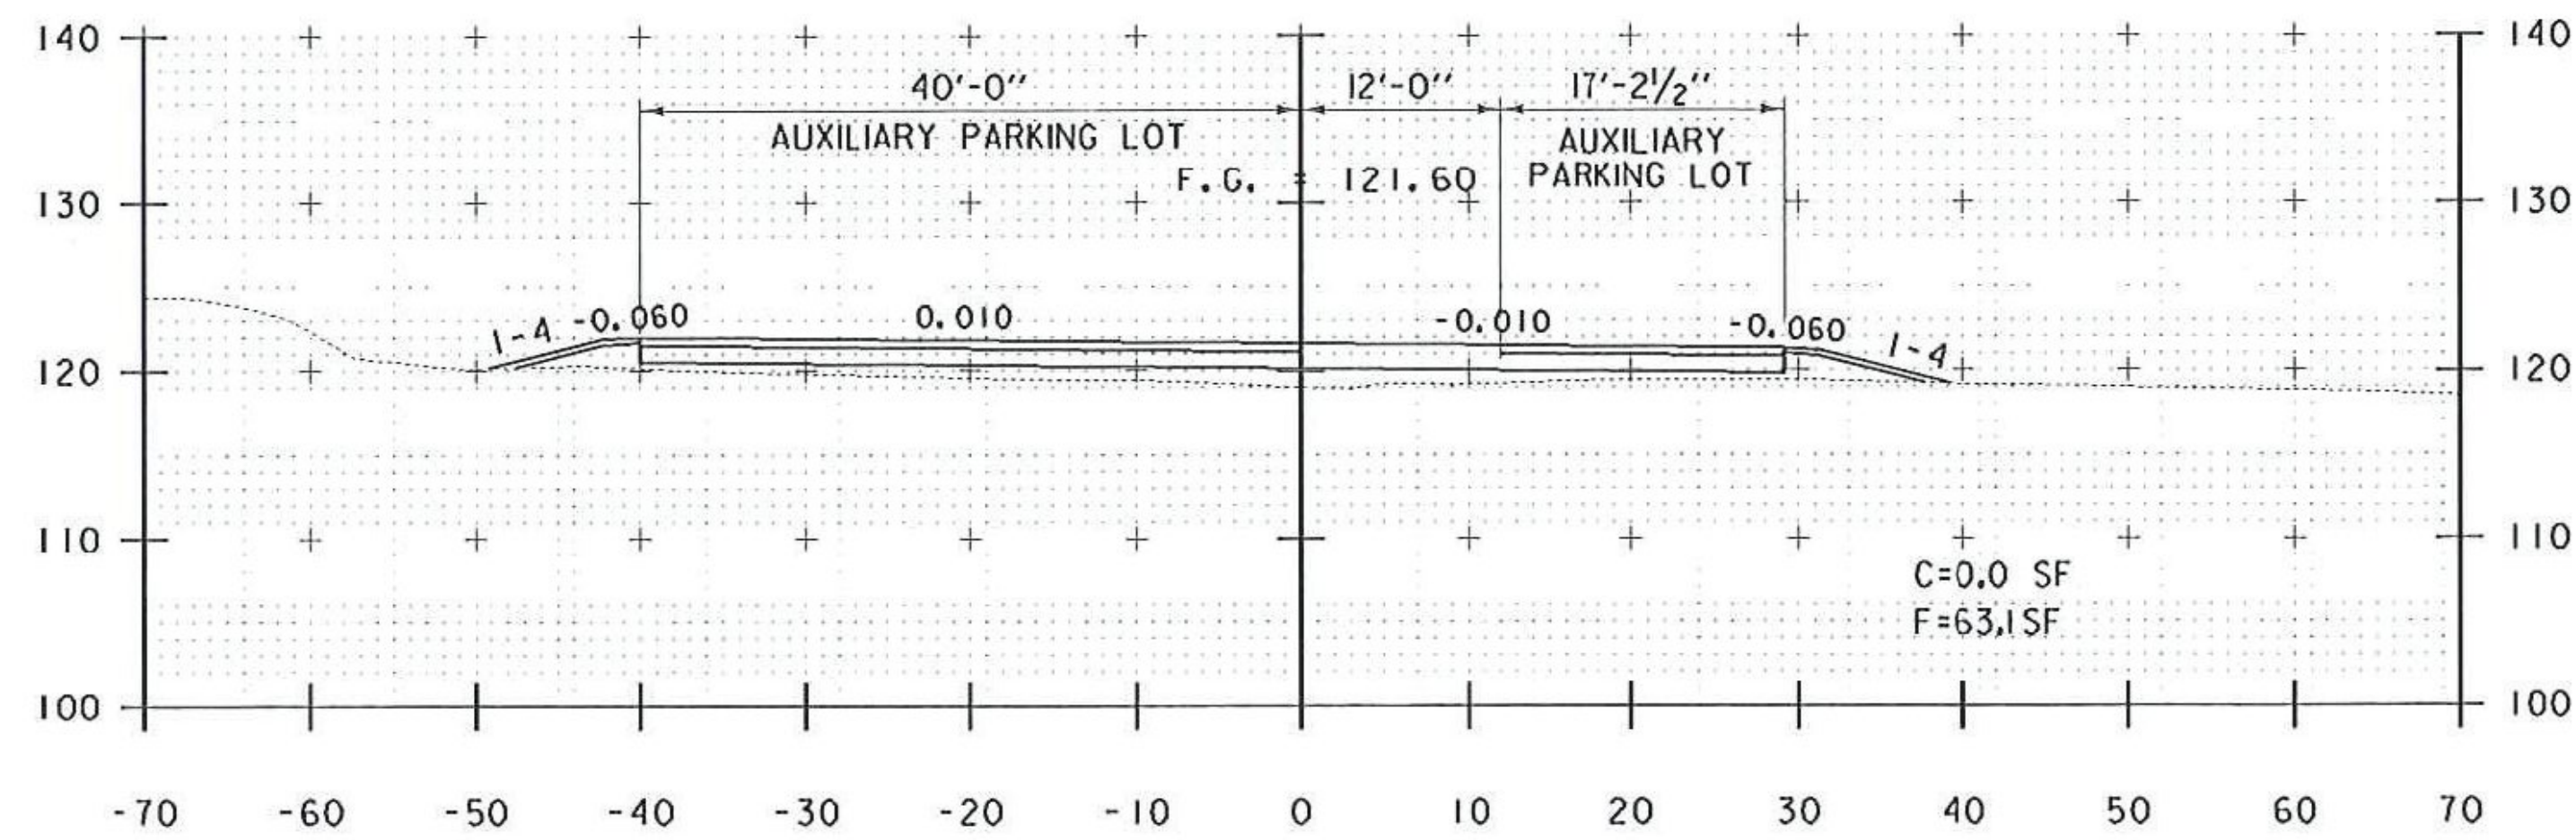


P 13+00

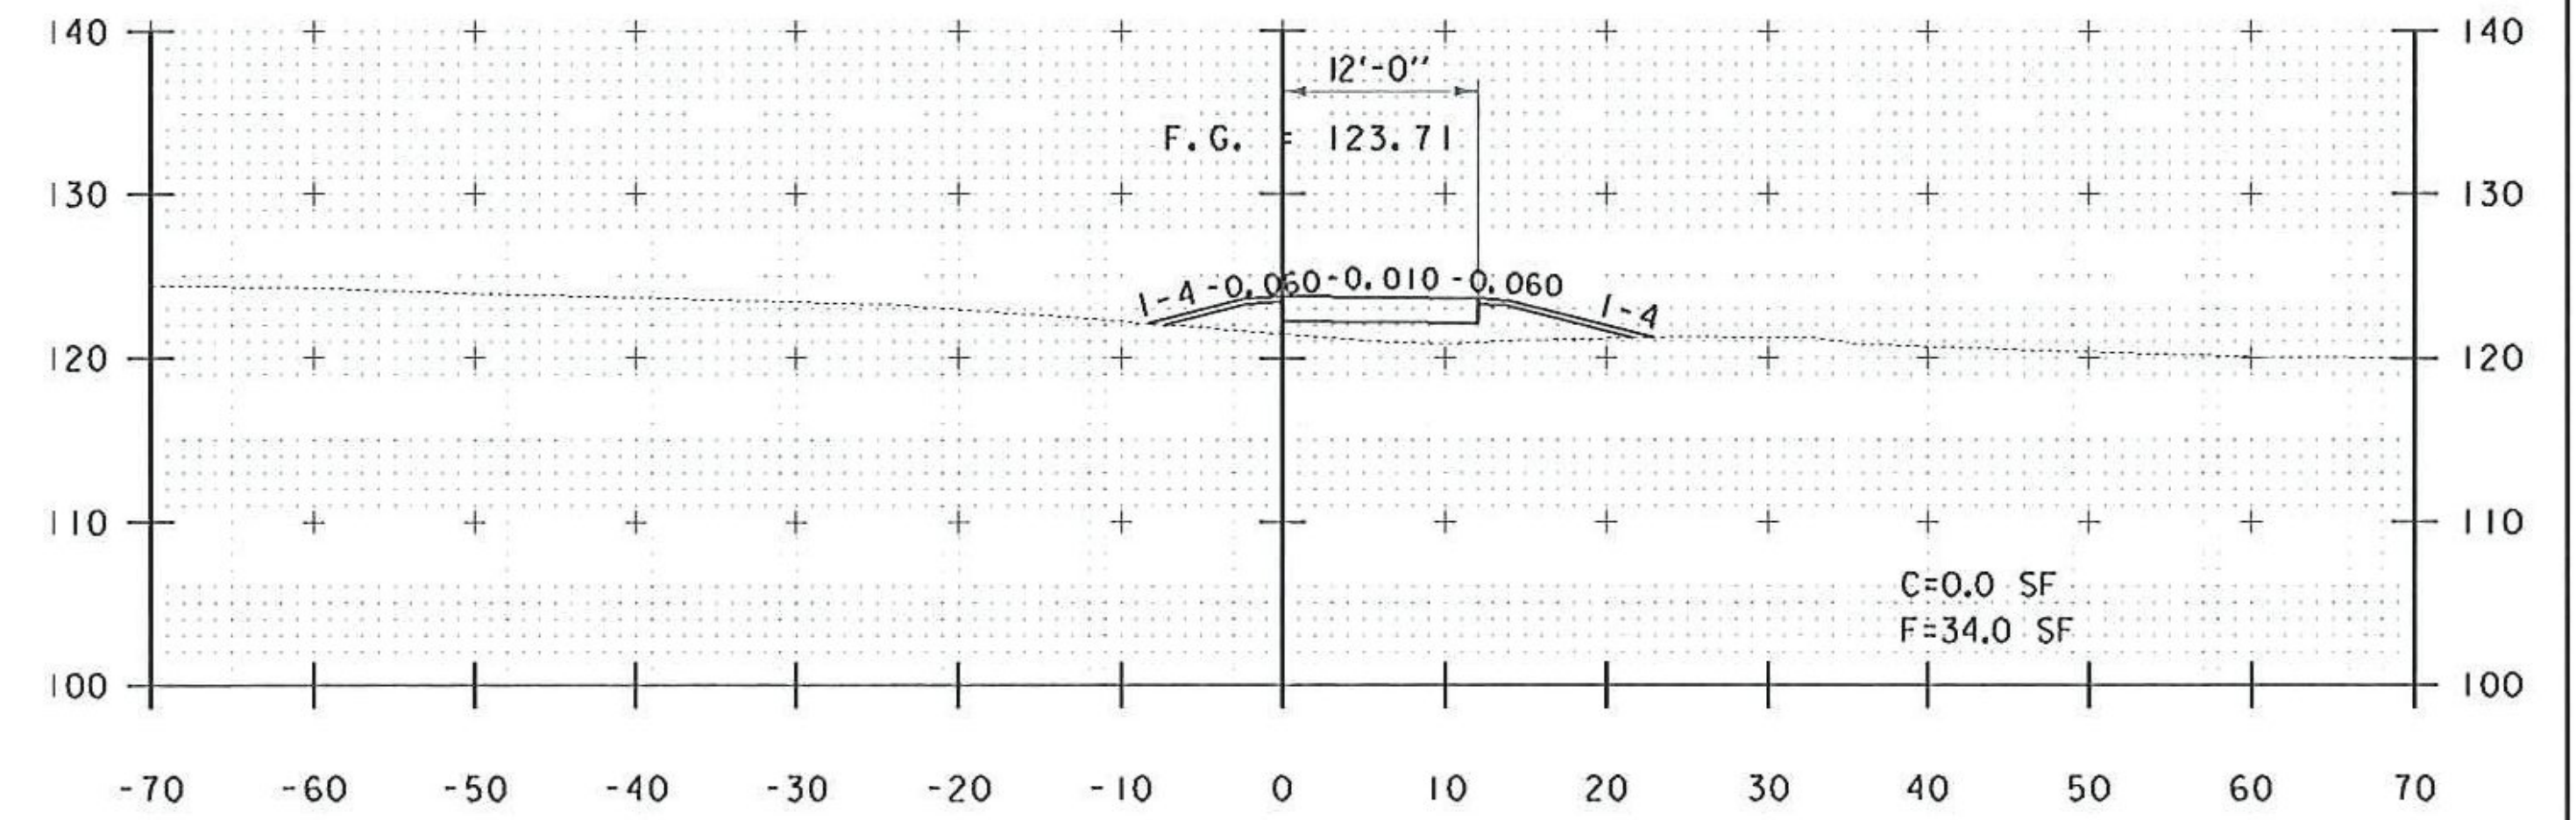

P 14+50

FILE NAME: I:\2013\03\03\CADD\MET\Prj-11 2013 Revisions\z12E008_xsec_03.dgn
 DATE/TIME: 4/3/2013
 USER: 4066

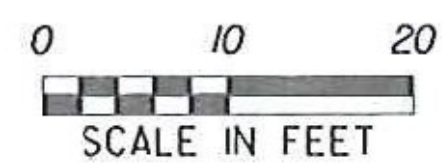

REVISED APRIL 1, 2013

CROSS SECTION SHEET #9	PROJECT NAME: LAKE CHAMPLAIN SITE RESTORATION
	PROJECT NUMBER: STP 032-(118)
FILE NAME: z12E008_xsec_03.dgn	PLOT DATE: 4/3/2013
PROJECT LEADER: D.E.G.	DRAWN BY: W.G.P.
DESIGNED BY: B.T.H.	CHECKED BY: D.E.G.
DWG. NO.: XS-9	SHEET 83A OF 100