




NF 11+00

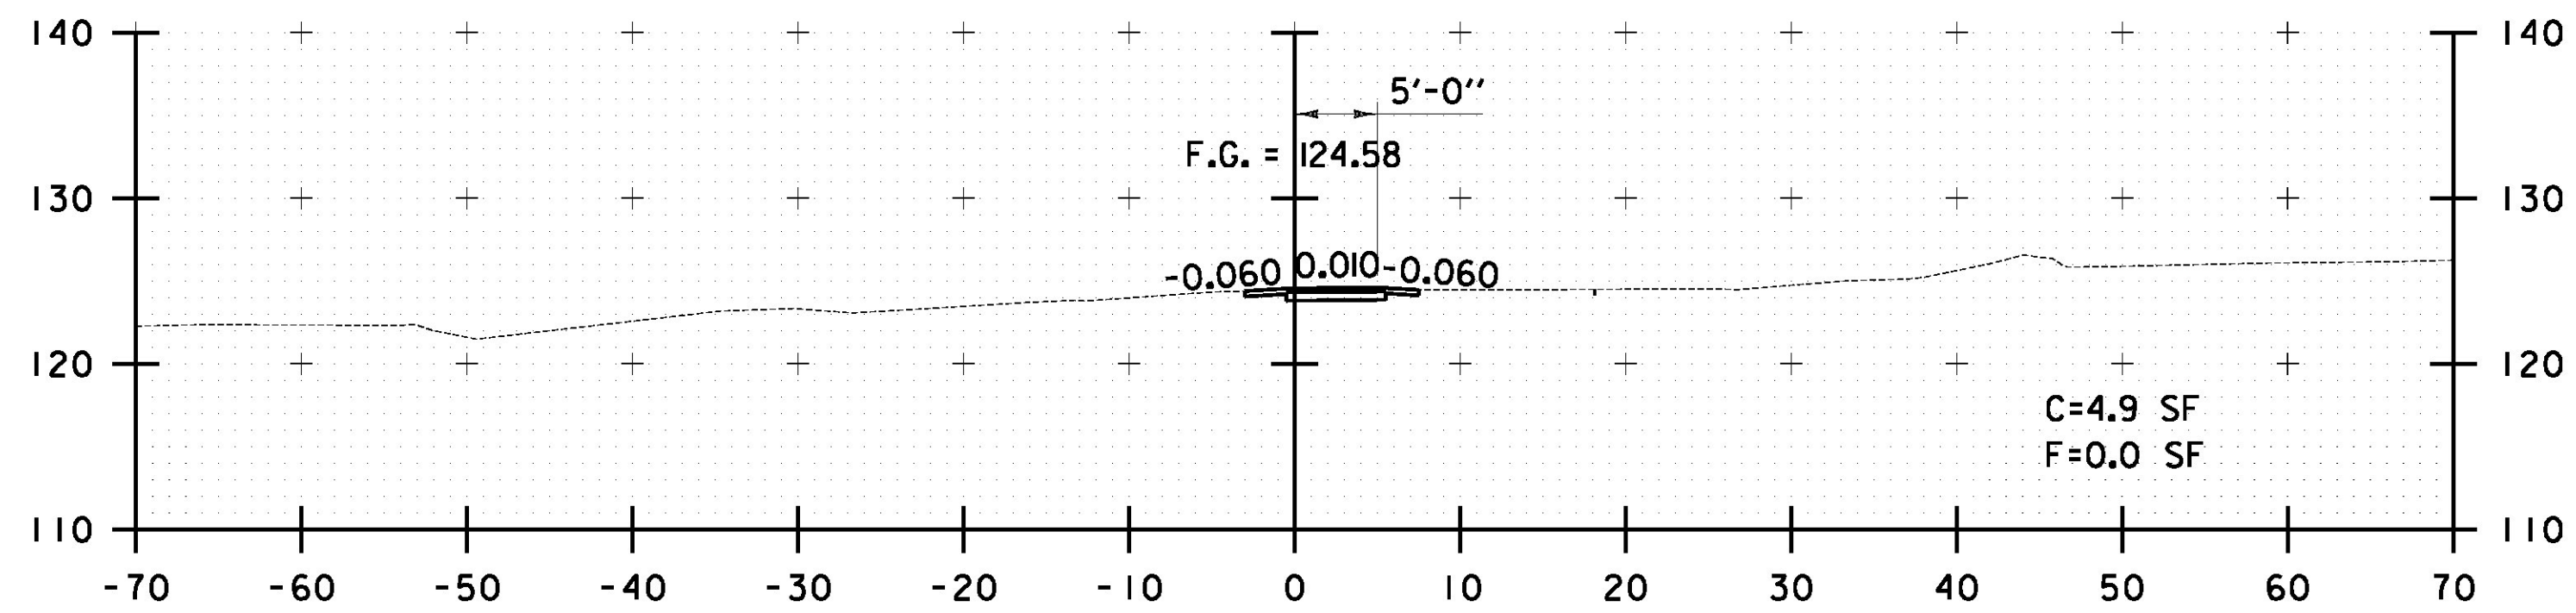


NF 10+50

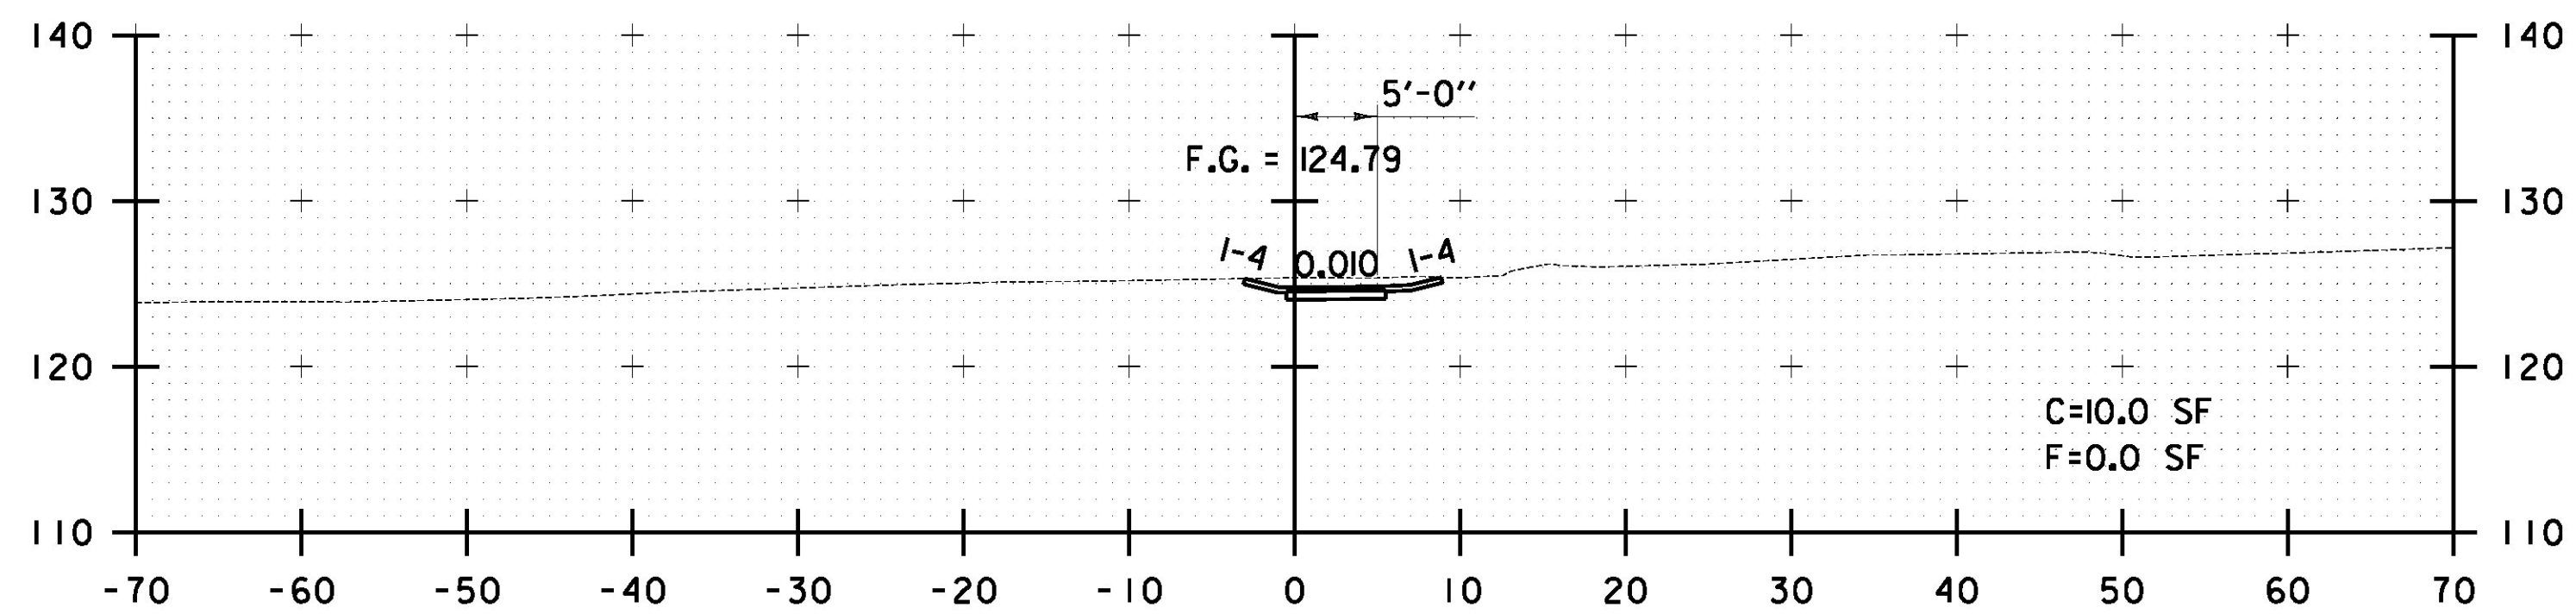


NF 10+00

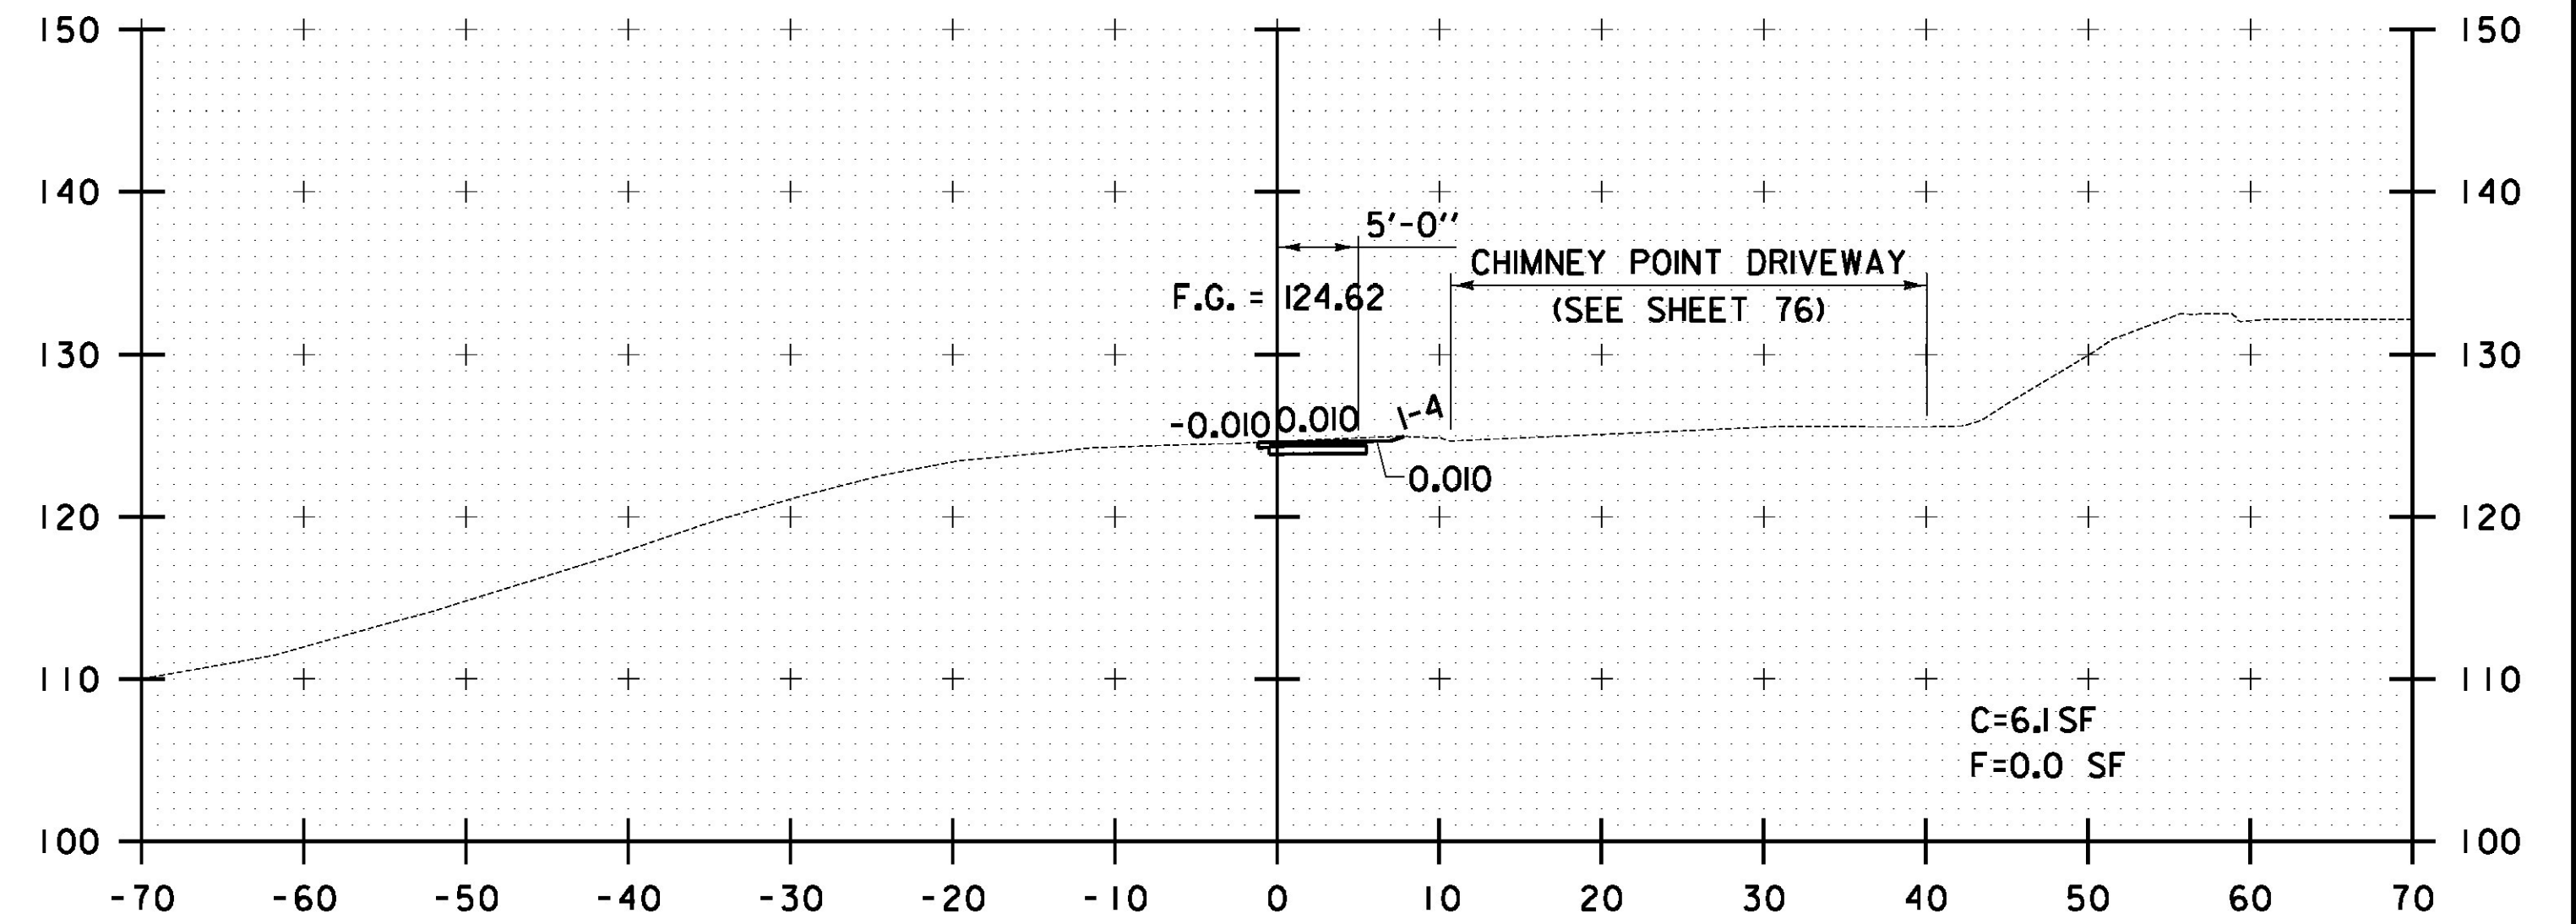

NF 12+00

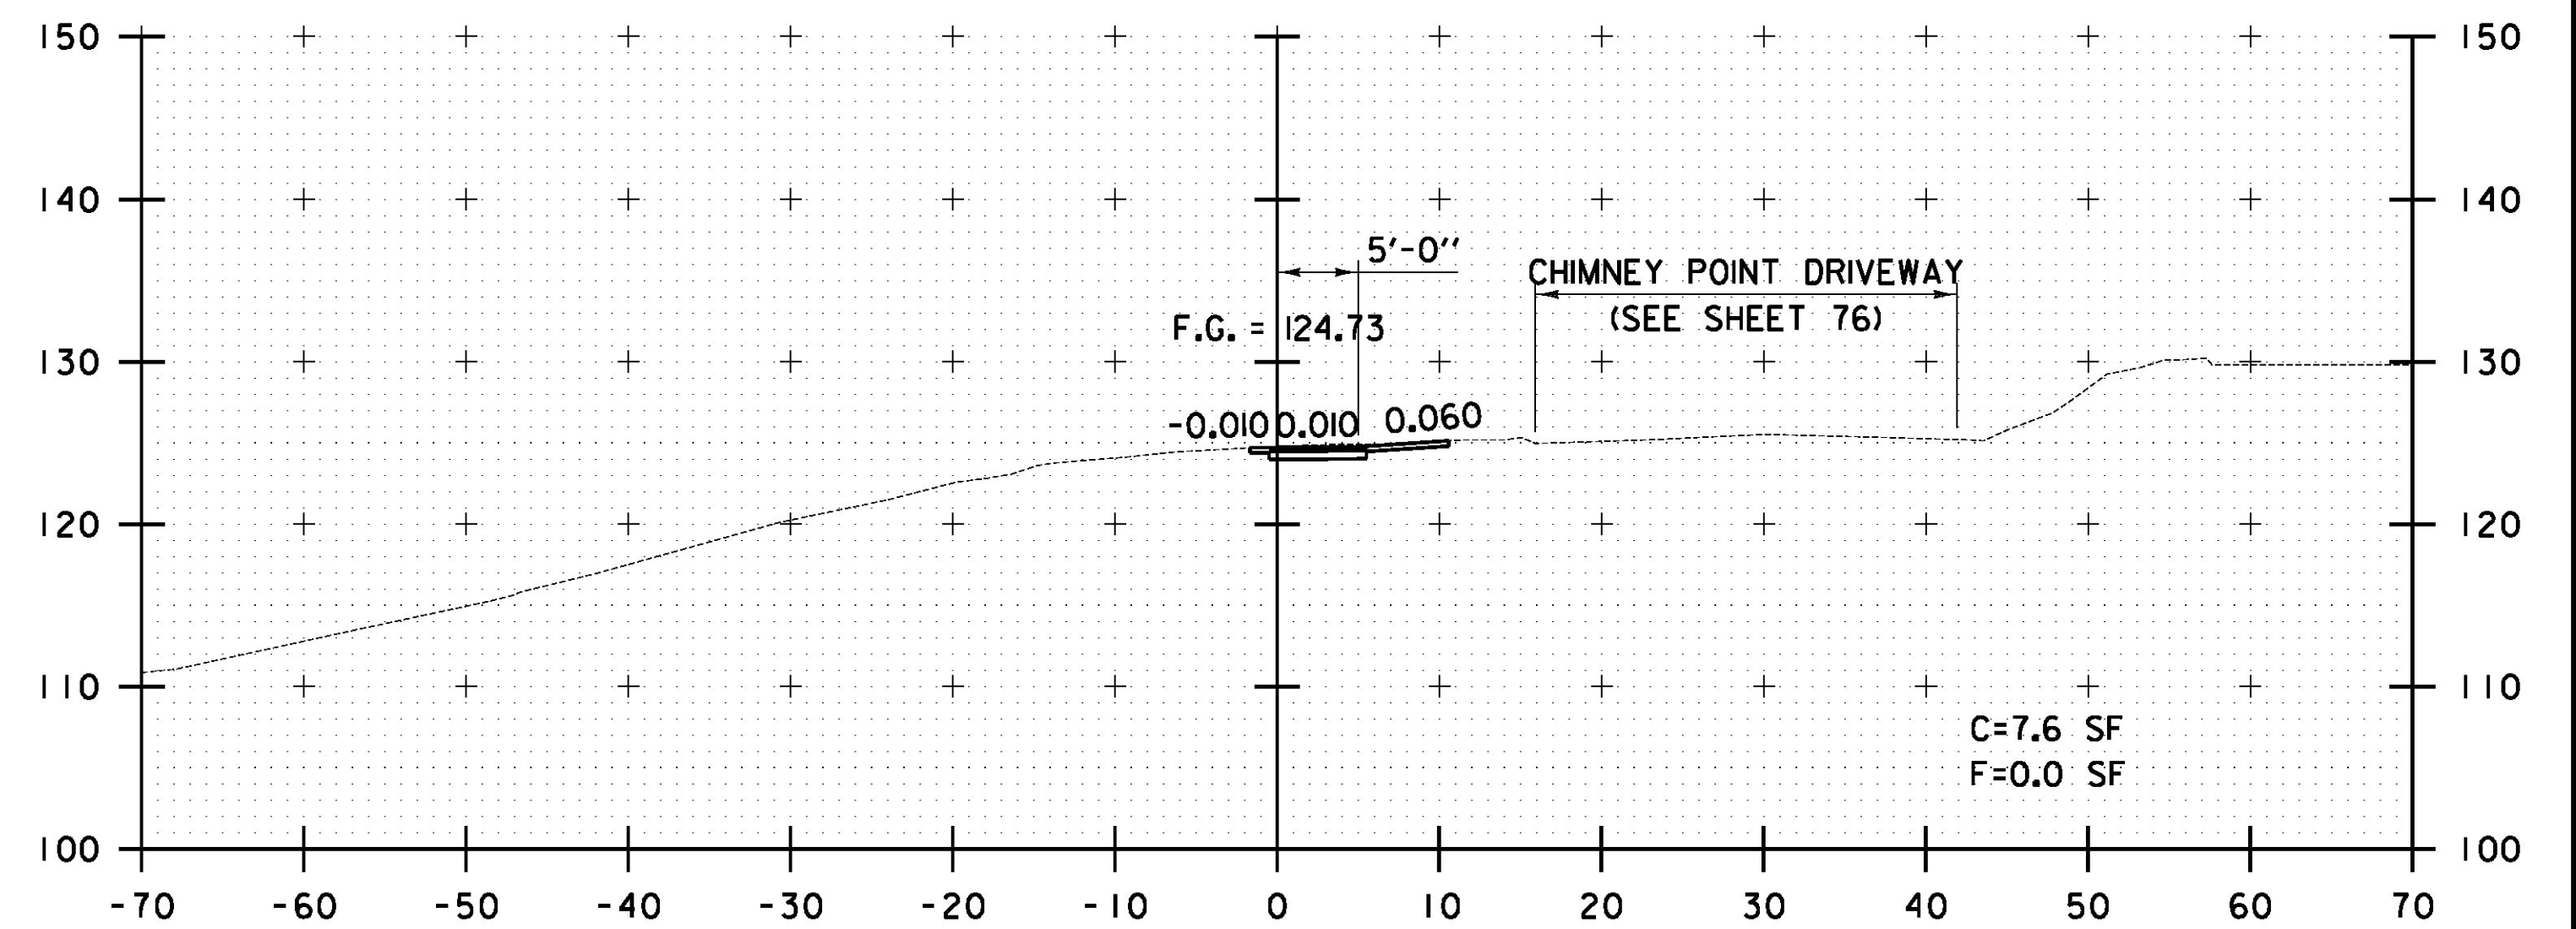

NF 11+50

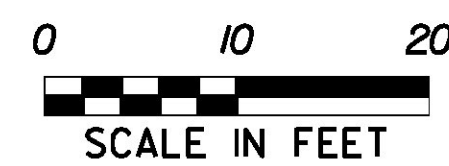

STA. NF 10+00 TO STA. NF 12+00

FILE NAME = I:\2012\08\CADD\MSTN\12E008.xsec.dgn
 DATE/TIME = 7/12/2012
 USER = 4666

CROSS SECTION SHEET #11	PROJECT NAME: LAKE CHAMPLAIN SITE RESTORATION
	PROJECT NUMBER: STP 032-1(18)
	FILE NAME: z12E008.xsec.05.dgn
	PLOT DATE: 7/12/2012
	PROJECT LEADER: D.E.G.
	DRAWN BY: W.G.P.
	DESIGNED BY: B.T.H.
	CHECKED BY: D.E.G.
	DWG. NO.: XS-11
	SHEET 85 OF 100