



M 2+23

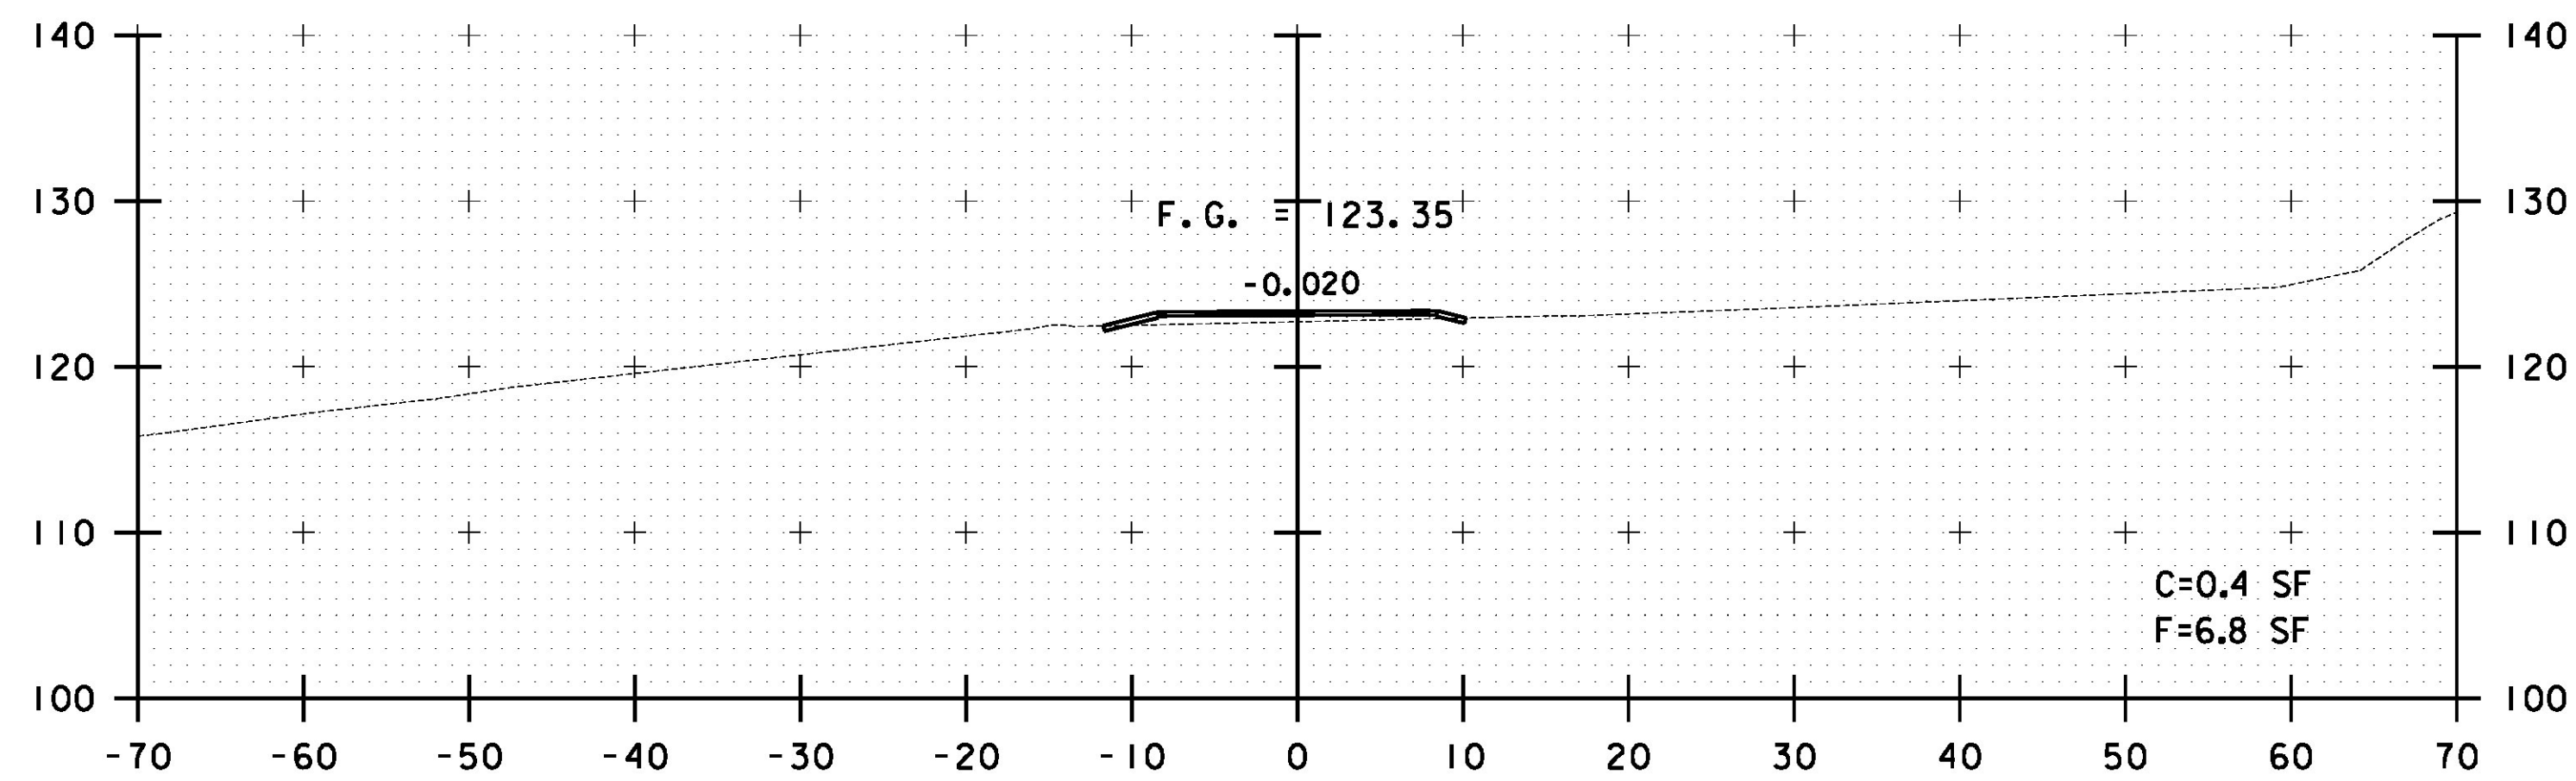

M 2+17

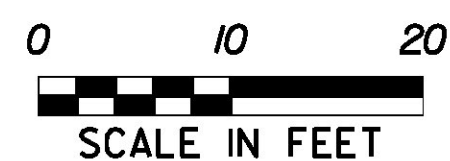

STA. M 2+17 TO STA. M 2+23

FILE NAME = I:\2012\03\03\03\CADD\MSTN\212E008.xsec.dgn
DATE/TIME = 7/12/2012
USER = 4666

CROSS SECTION SHEET #14	PROJECT NAME: LAKE CHAMPLAIN SITE RESTORATION
	PROJECT NUMBER: STP 032-I(18)
FILE NAME: z12E008.xsec.06.dgn	PLOT DATE: 7/12/2012
PROJECT LEADER: D.E.G.	DRAWN BY: W.G.P.
DESIGNED BY: B.T.H.	CHECKED BY: D.E.G.
DWG. NO.: XS-14	SHEET 88 OF 100