




L 2+00

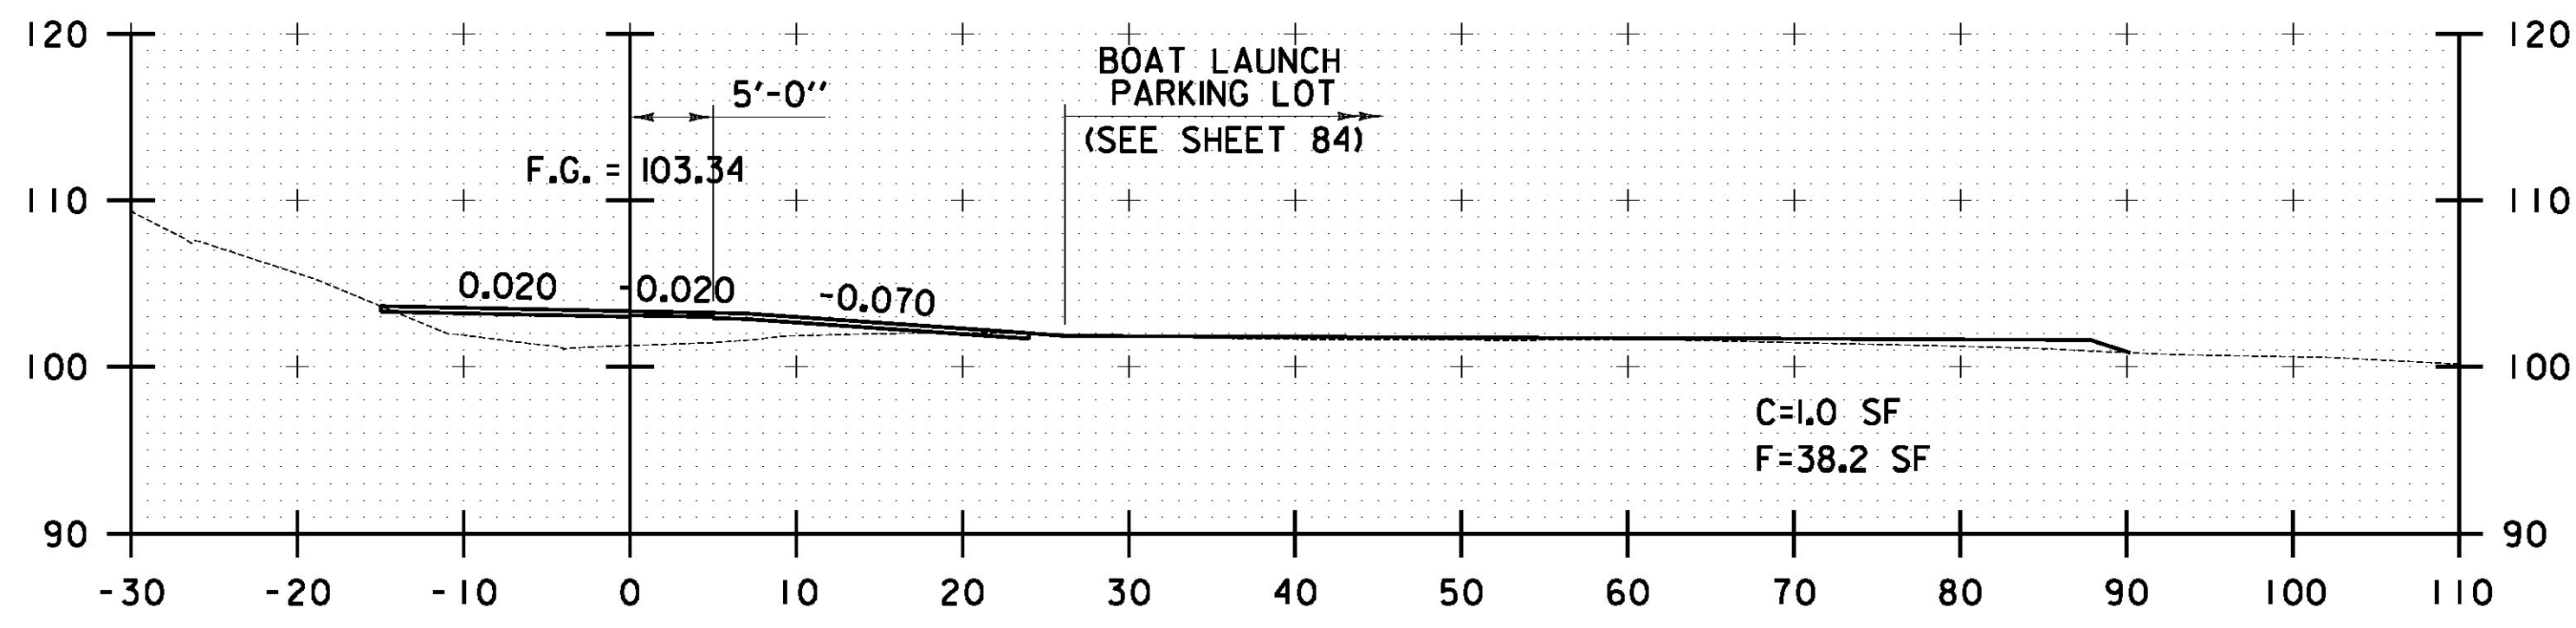


L 1+50

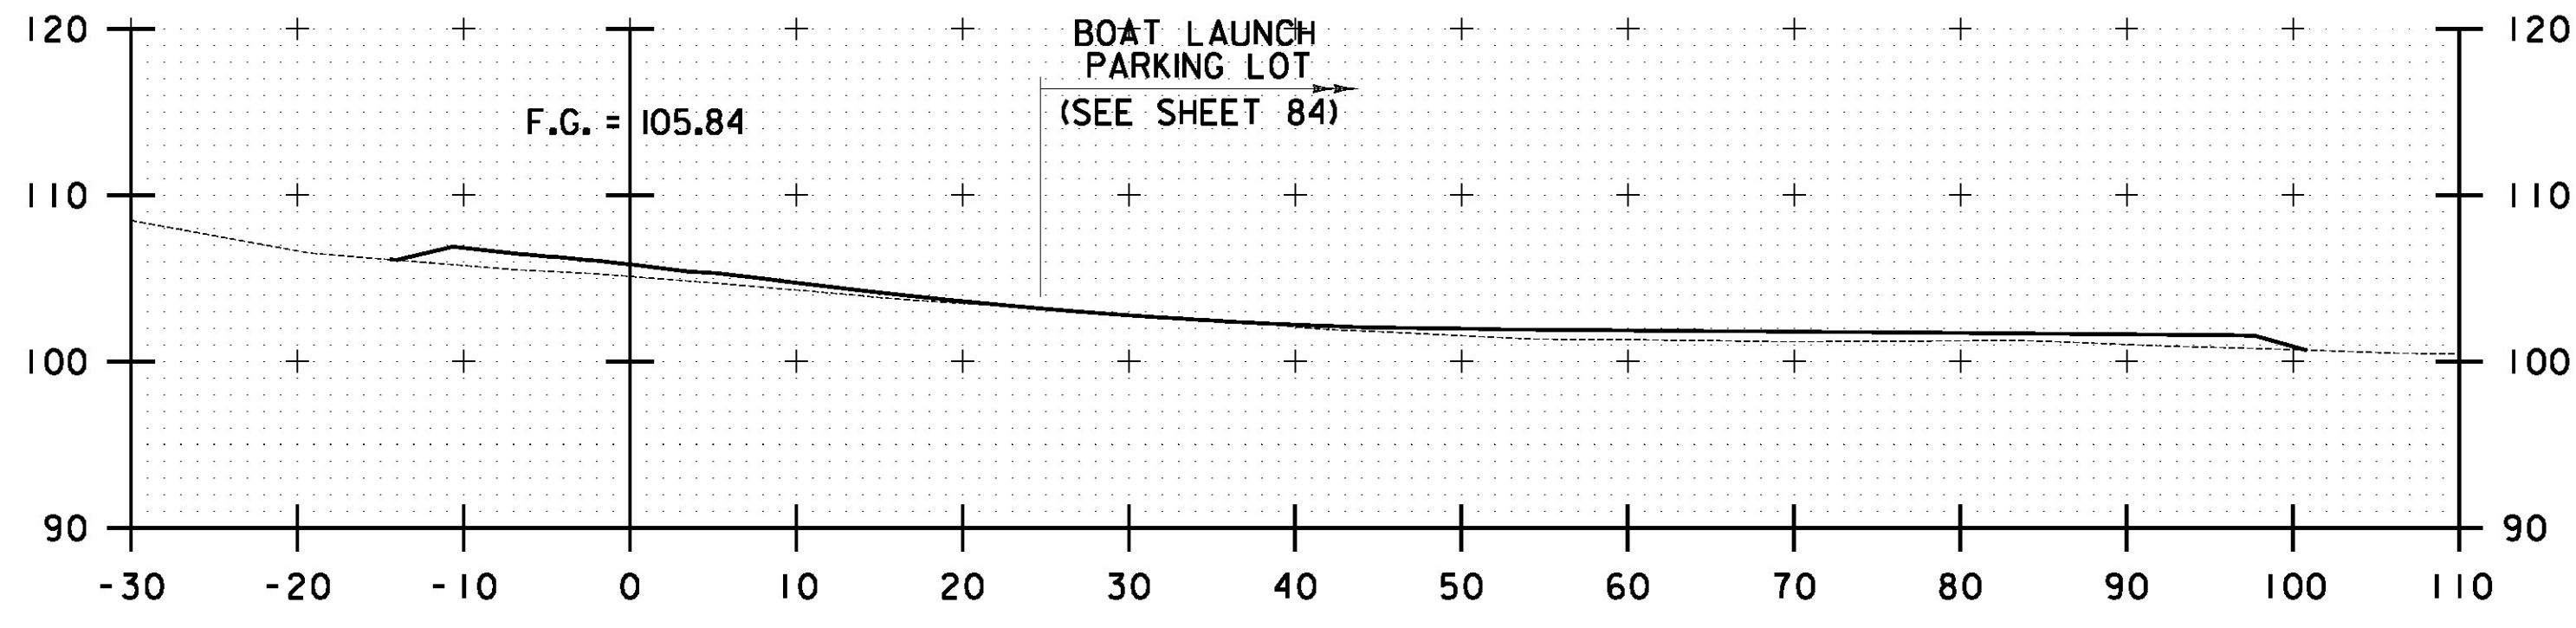


L 1+00

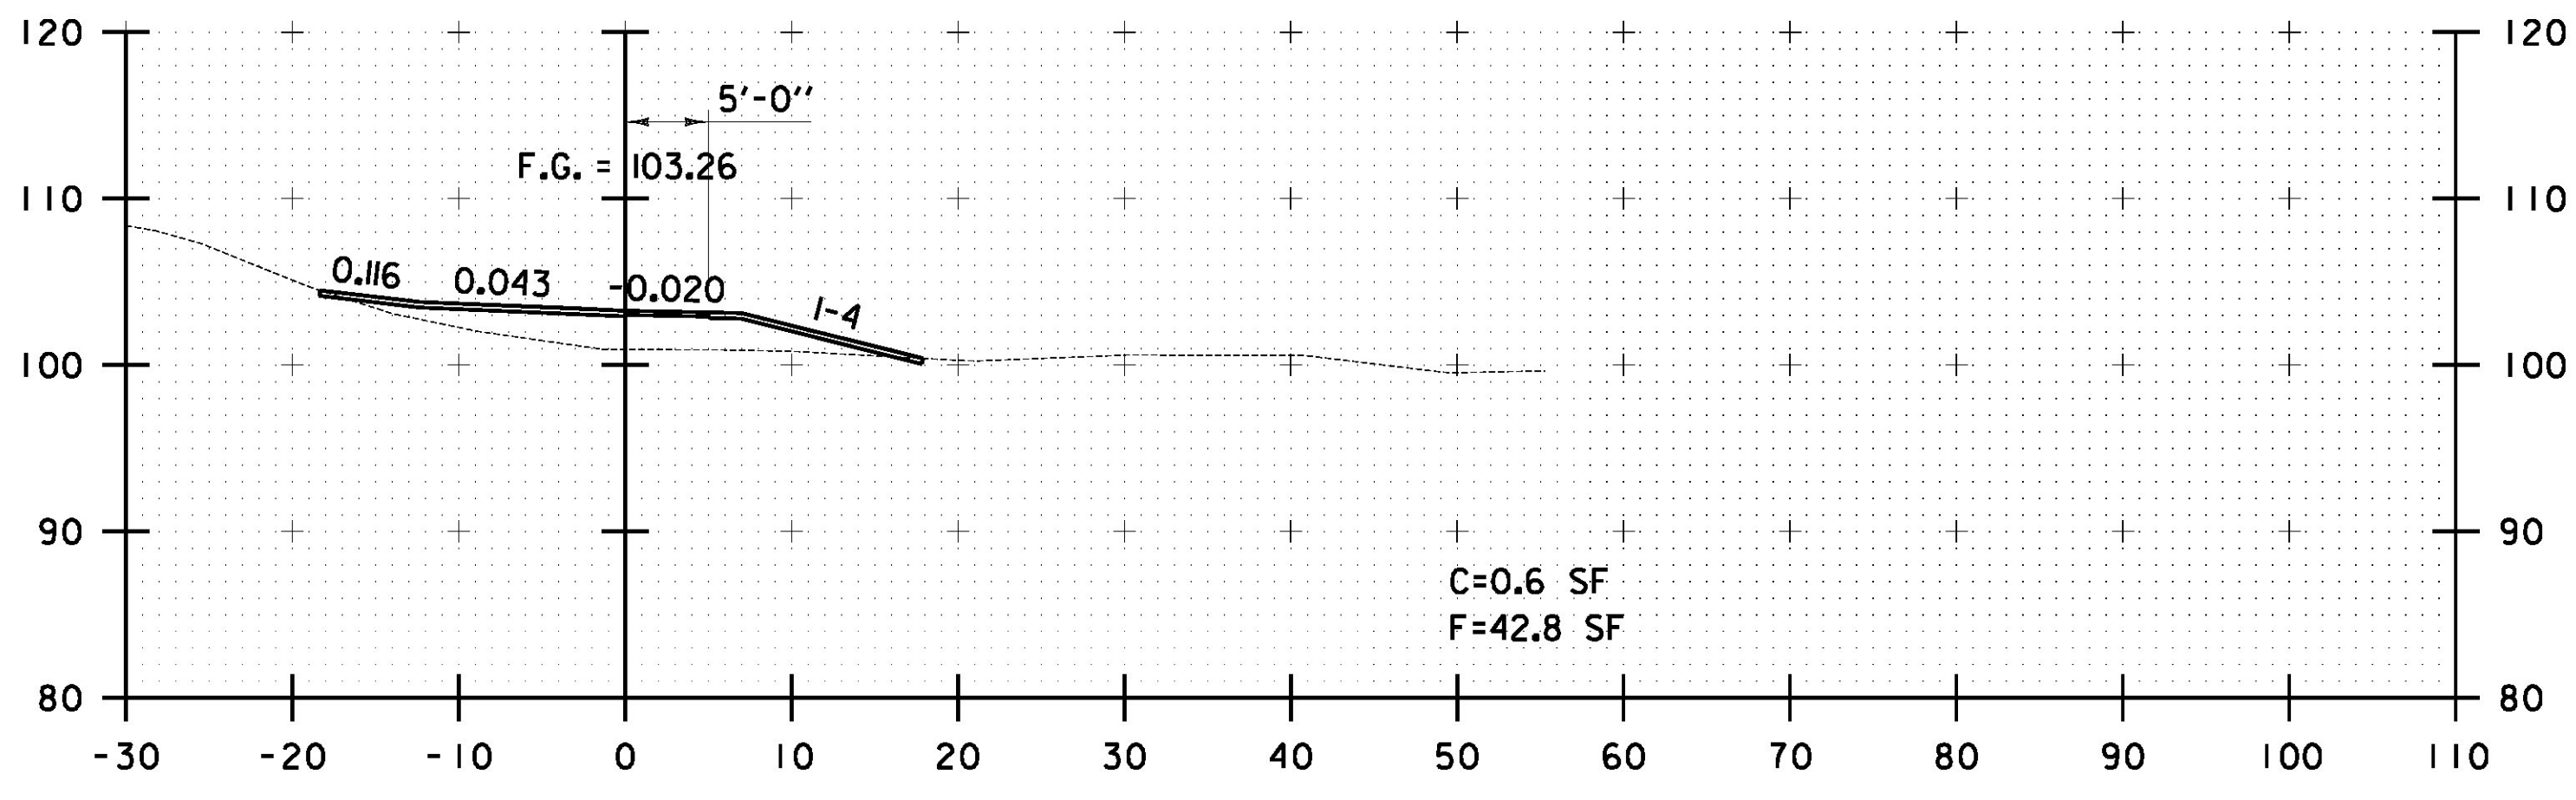


L 3+50

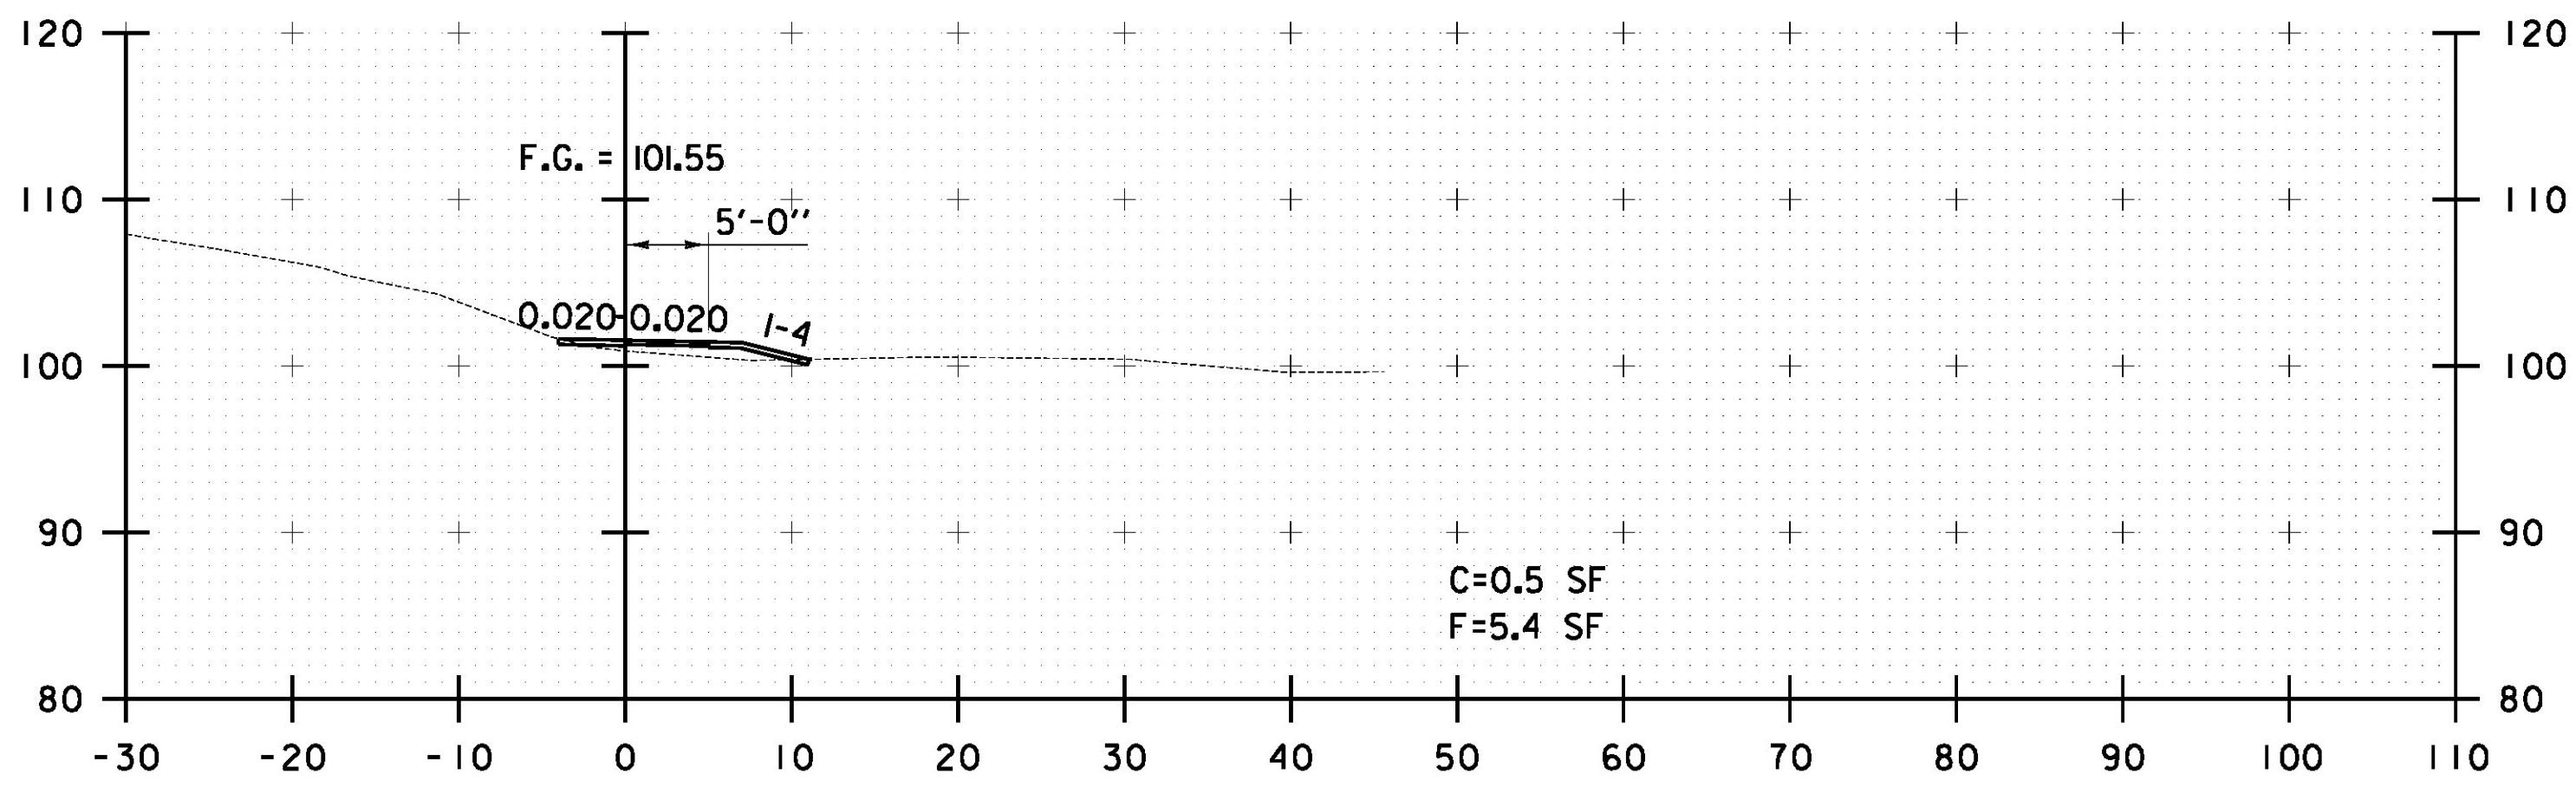

L 3+00

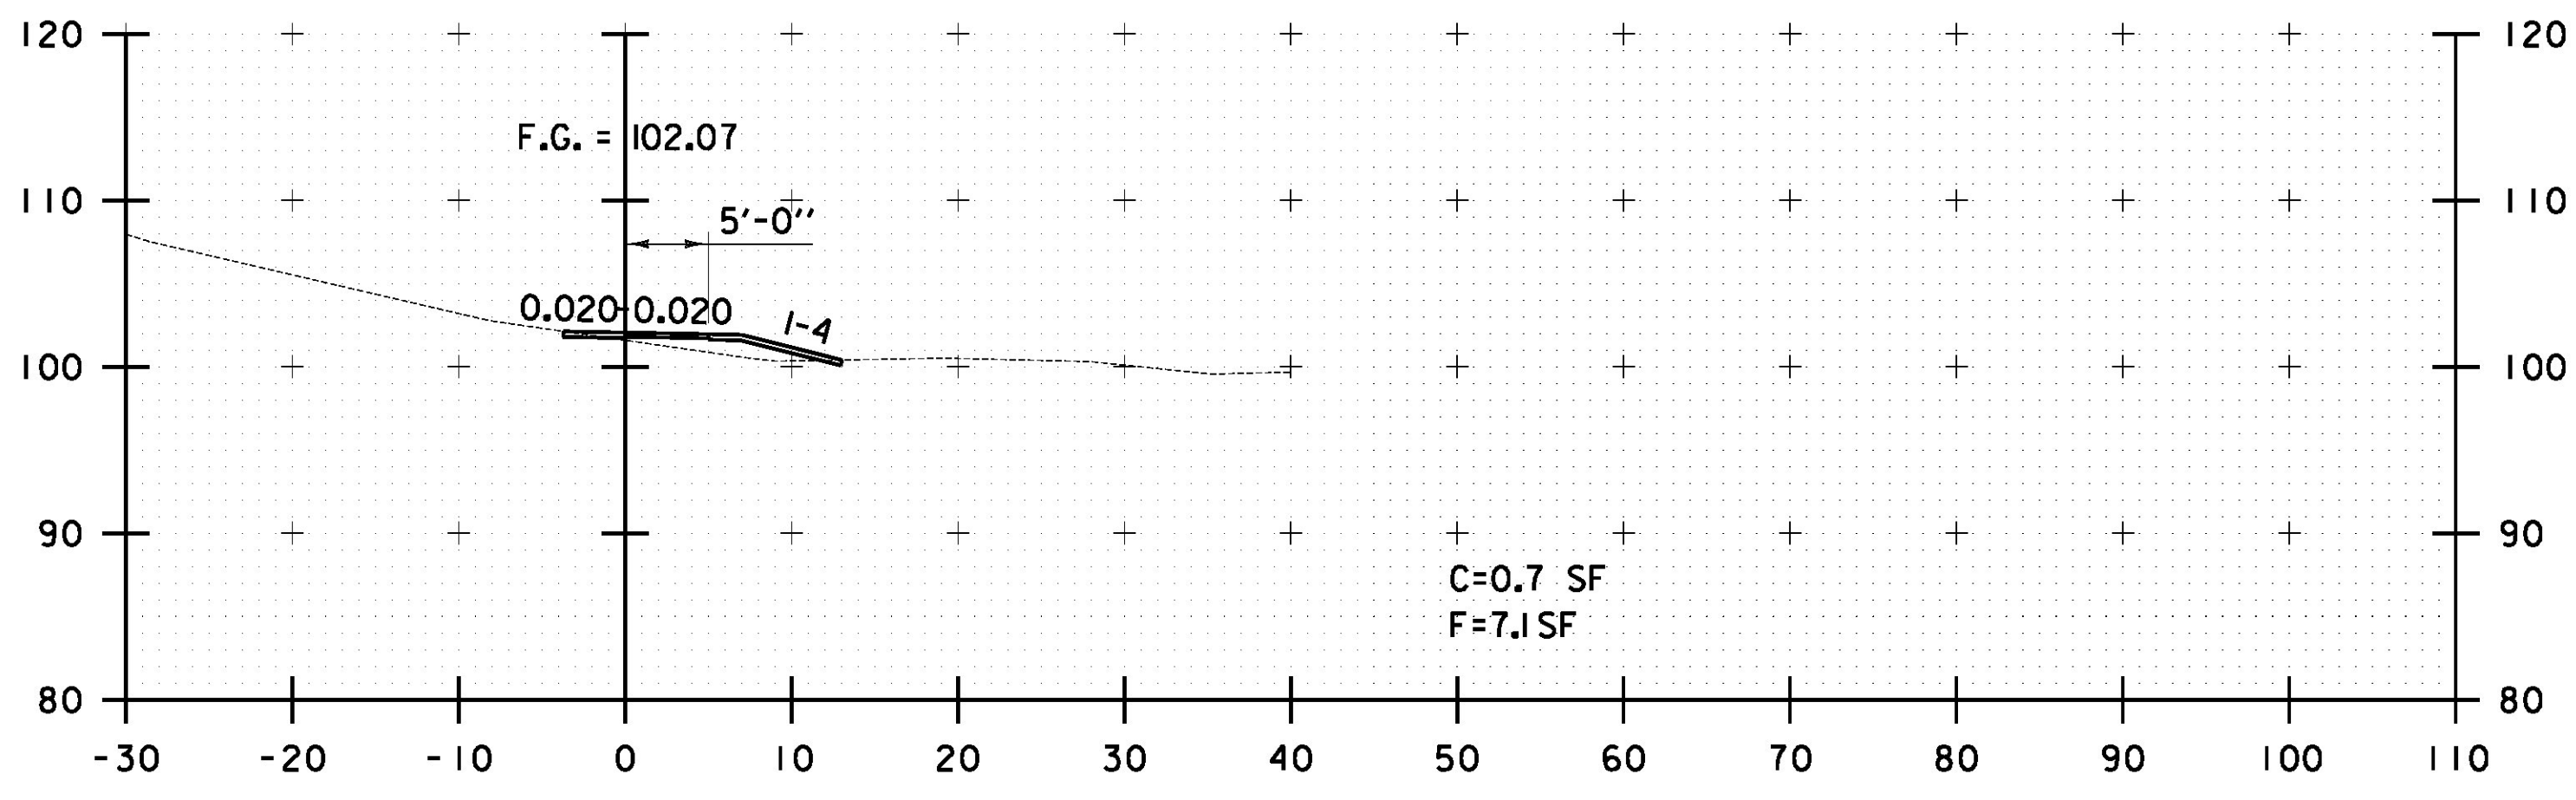

L 2+50

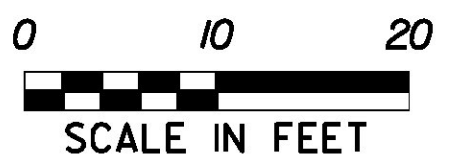

STA. L 1+00 TO STA. L 3+50

FILE NAME = I:\2012\08\CADD\MSTN\2\2E008\_xsec.07.dgn  
 DATE/TIME = 7/12/2012  
 USER = 4666

<b>CROSS SECTION SHEET #15</b>	PROJECT NAME: LAKE CHAMPLAIN SITE RESTORATION	
	PROJECT NUMBER: STP 032-1(18)	
	FILE NAME: z12E008_xsec.07.dgn	PLOT DATE: 7/12/2012
	PROJECT LEADER: D.E.G.	DRAWN BY: W.G.P.
DESIGNED BY: B.T.H.	CHECKED BY: D.E.G.	
DWG. NO.: XS-15	SHEET 89	OF 100