


L 4+00

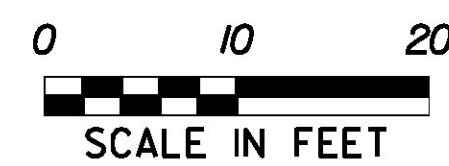

STA. L 4+00 TO STA. L 4+00

FILE NAME = I:\2012\03\03\CADD\MSTN\z12E008.xsec.07.dgn
DATE/TIME = 7/12/2012
USER = 4666

CROSS SECTION SHEET #16	PROJECT NAME: LAKE CHAMPLAIN SITE RESTORATION	
	PROJECT NUMBER: STP 032-I(18)	
FILE NAME: z12E008.xsec.07.dgn	PLOT DATE: 7/12/2012	
PROJECT LEADER: D.E.G.	DRAWN BY: W.G.P.	
DESIGNED BY: B.T.H.	CHECKED BY: D.E.G.	
DWG. NO.: XS-16	SHEET 90	OF 100