



STATE OF VERMONT AGENCY OF TRANSPORTATION



PROPOSED IMPROVEMENT BRIDGE PROJECT TOWN OF BROOKFIELD COUNTY OF ORANGE VT. ROUTE 65 (MINOR COLLECTOR) BRIDGE NO. 2

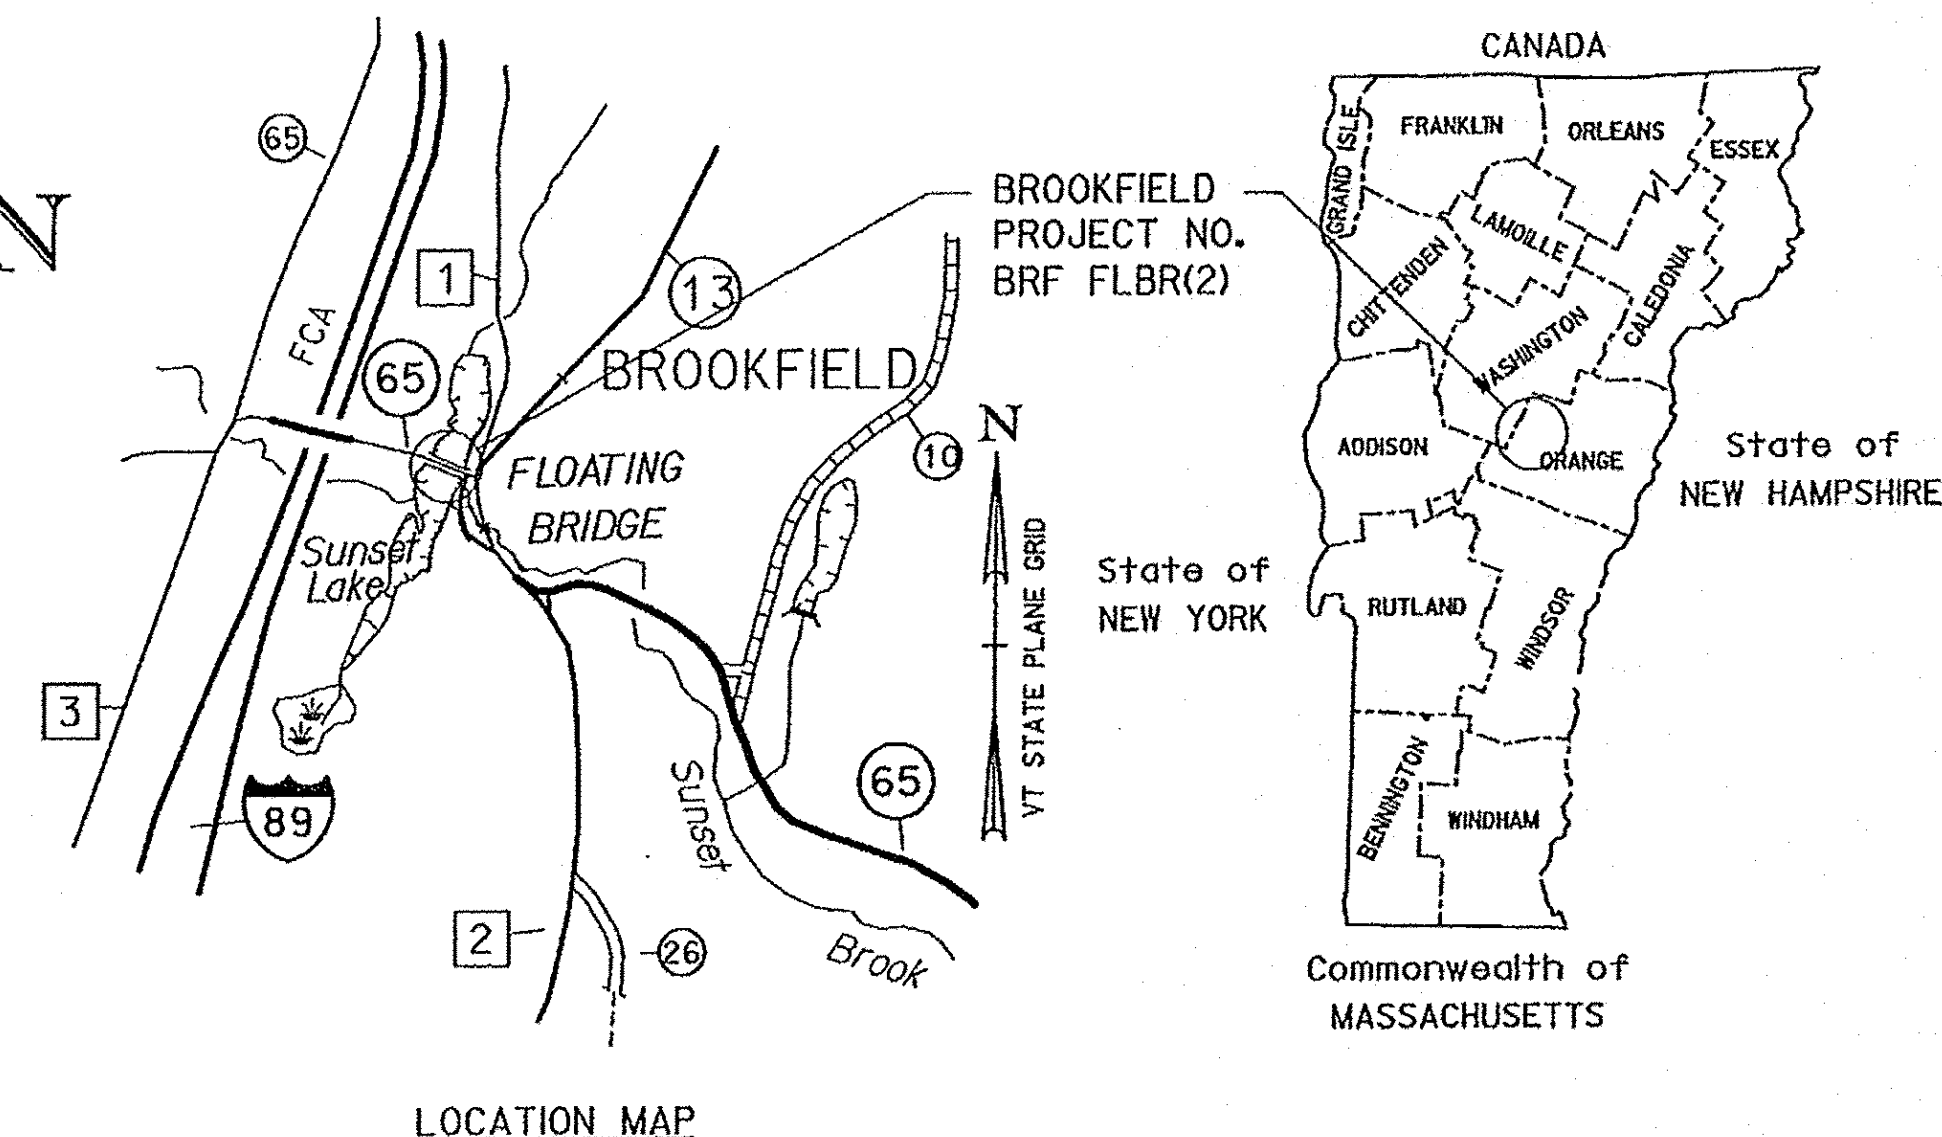


RECORD PLANS	
CONTRACTOR:	MILLER CONSTRUCTION, INC - WINDSOR, VT
RESIDENT ENGINEER:	SANDRA SCHMITT
CONSTRUCTION BEGAN:	APRIL 30, 2014
CONSTRUCTION COMPLETE:	MAY 22, 2015
RECORD PLANS BY:	SANDRA SCHMITT & AARON JAMES
I HEREBY CERTIFY THAT ALL THE CONSTRUCTION REQUIRED BY THIS SET OF DRAWINGS HAS BEEN ACCOMPLISHED AS INDICATED HEREIN.	
BY <u>Sandra Schmitt</u>	RESIDENT ENGINEER
DATE <u>07/26/16</u>	
NOTE: Any further information concerning final quantities, amounts or other details relative to this project may be found at Central Files in the electronic archives.	

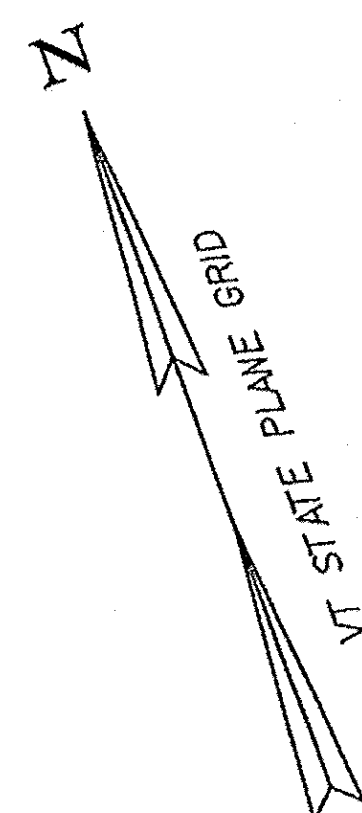

PROJECT LOCATION: THE BRIDGE IS LOCATED ON VT ROUTE 65 APPROXIMATELY 0.05 MILES SOUTHWEST OF THE INTERSECTION OF VT ROUTE 65 AND TH 1 IN BROOKFIELD'S SUNSET VILLAGE.

PROJECT DESCRIPTION: REPLACEMENT OF THE EXISTING TIMBER FLOATING BRIDGE WITH A NEW FIBER REINFORCED POLYMER (FRP) FLOATING BRIDGE WITH TIMBER DECK AND RAILS, NEW ABUTMENTS, AND RELATED APPROACH WORK.


STRUCTURE LENGTH: 321.00 FEET
ROADWAY LENGTH: 115.56 FEET
PROJECT LENGTH: 436.56 FEET

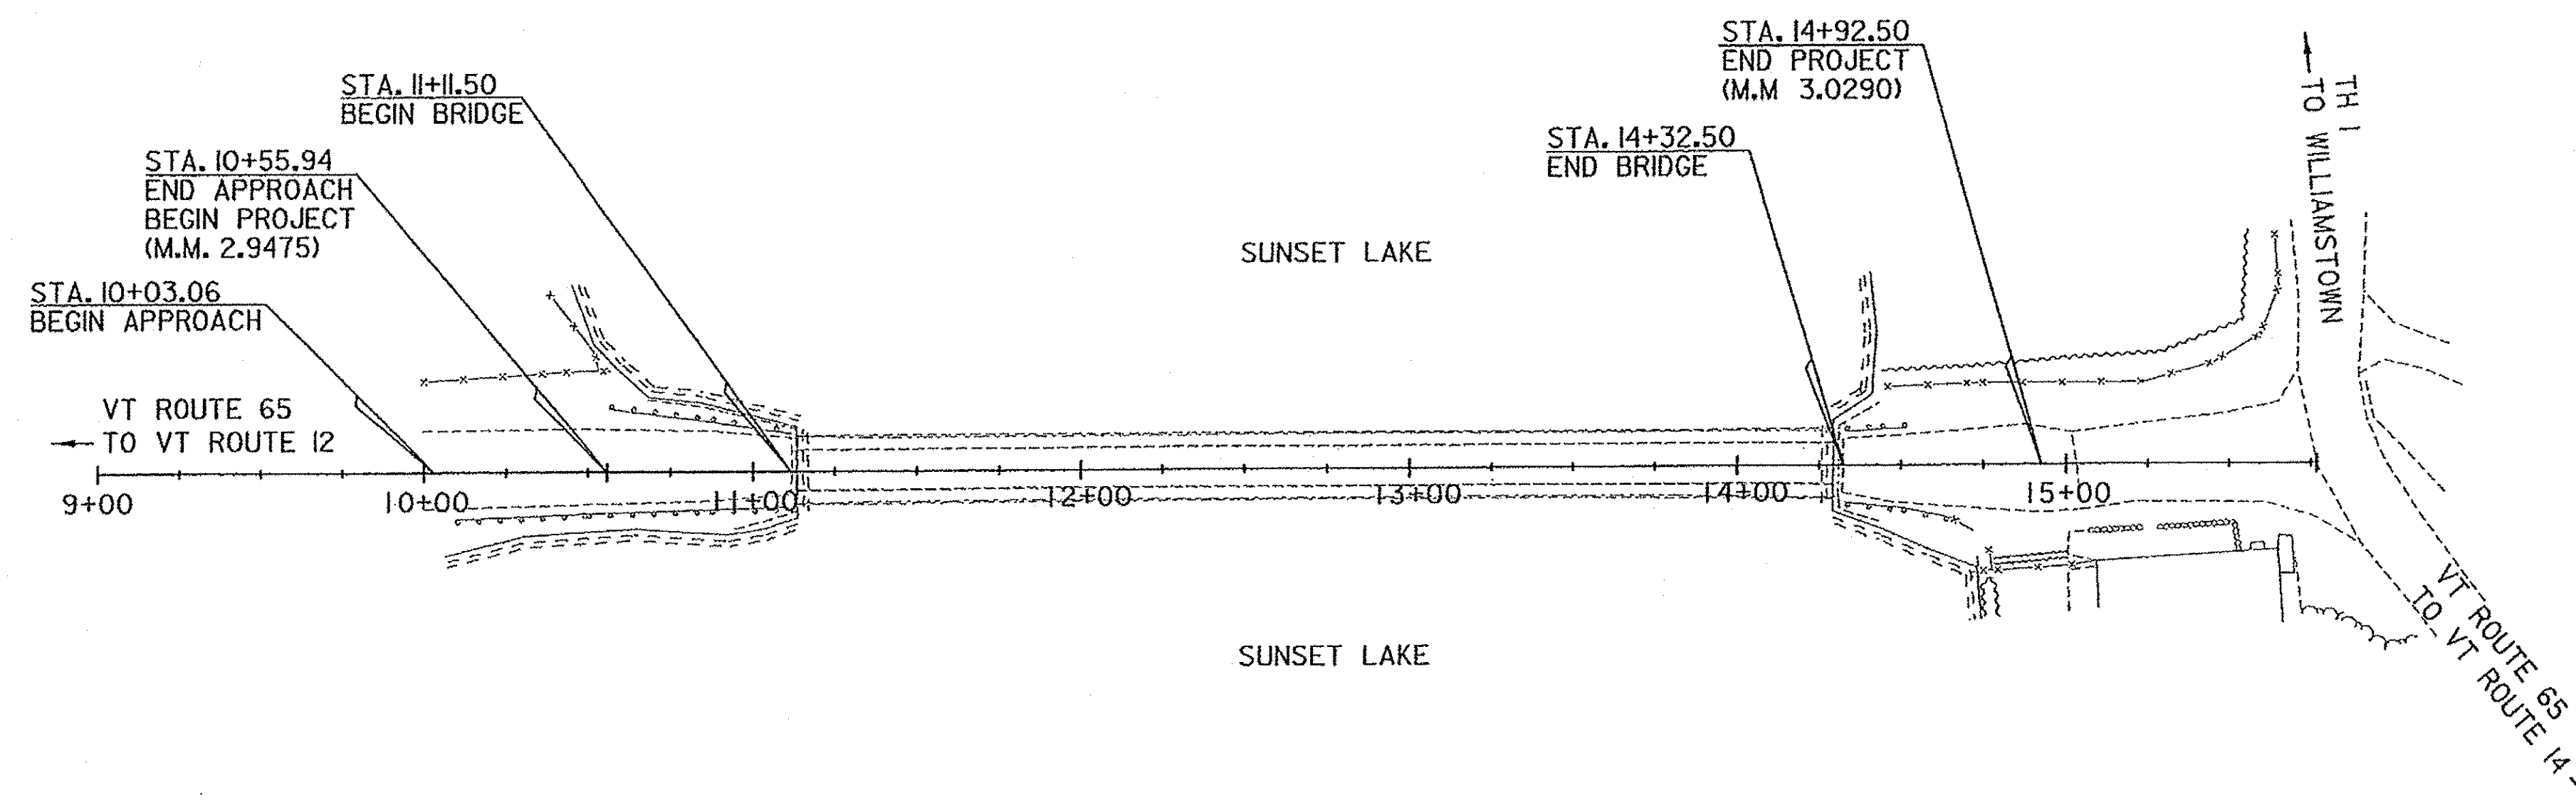

THESE PLANS ARE SUBJECT TO SUCH ENGINEERING CHANGES AS MAY BE REQUIRED BY THE FEDERAL HIGHWAY ADMINISTRATION OR THE DIRECTOR OF PROGRAM DEVELOPMENT.

CONSTRUCTION IS TO BE CARRIED ON IN ACCORDANCE WITH THESE PLANS AND THE STANDARD SPECIFICATIONS FOR CONSTRUCTION DATED 2011, AS APPROVED BY THE FEDERAL HIGHWAY ADMINISTRATION ON JULY 20, 2011 FOR USE ON THIS PROJECT, INCLUDING ALL SUBSEQUENT REVISIONS AND SUCH REVISED SPECIFICATIONS AND SPECIAL PROVISIONS AS ARE INCORPORATED IN THESE PLANS.

QUALITY ASSURANCE PROGRAM : LEVEL 2	
SURVEYED BY :	R. GILMAN
SURVEYED DATE :	1/2011
DATUM	
VERTICAL	NAVD 88
HORIZONTAL	NAD 83 (07)

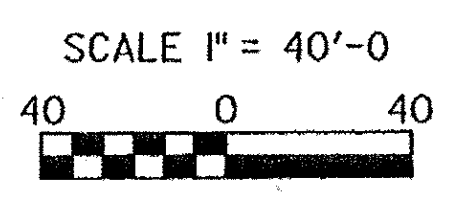

TY-LIN INTERNATIONAL

DEPARTMENT OF TRANSPORTATION FEDERAL HIGHWAY ADMINISTRATOR	
APPROVED <u>Toad K. Ball</u>	DATE <u>1-6-14</u>
DIRECTOR OF PROGRAM DEVELOPMENT	
APPROVED <u>Richard Fitch</u>	DATE <u>12-30-13</u>
PROJECT MANAGER : JENNIFER FITCH, P.E.	
PROJECT NAME : BROOKFIELD	
PROJECT NUMBER : BRF FLBR (2)	
SHEET 1 OF 70 SHEETS	