


ARTICULATING RAMP TYPICAL SECTION

SCALE: 3/4" = 1'-0"

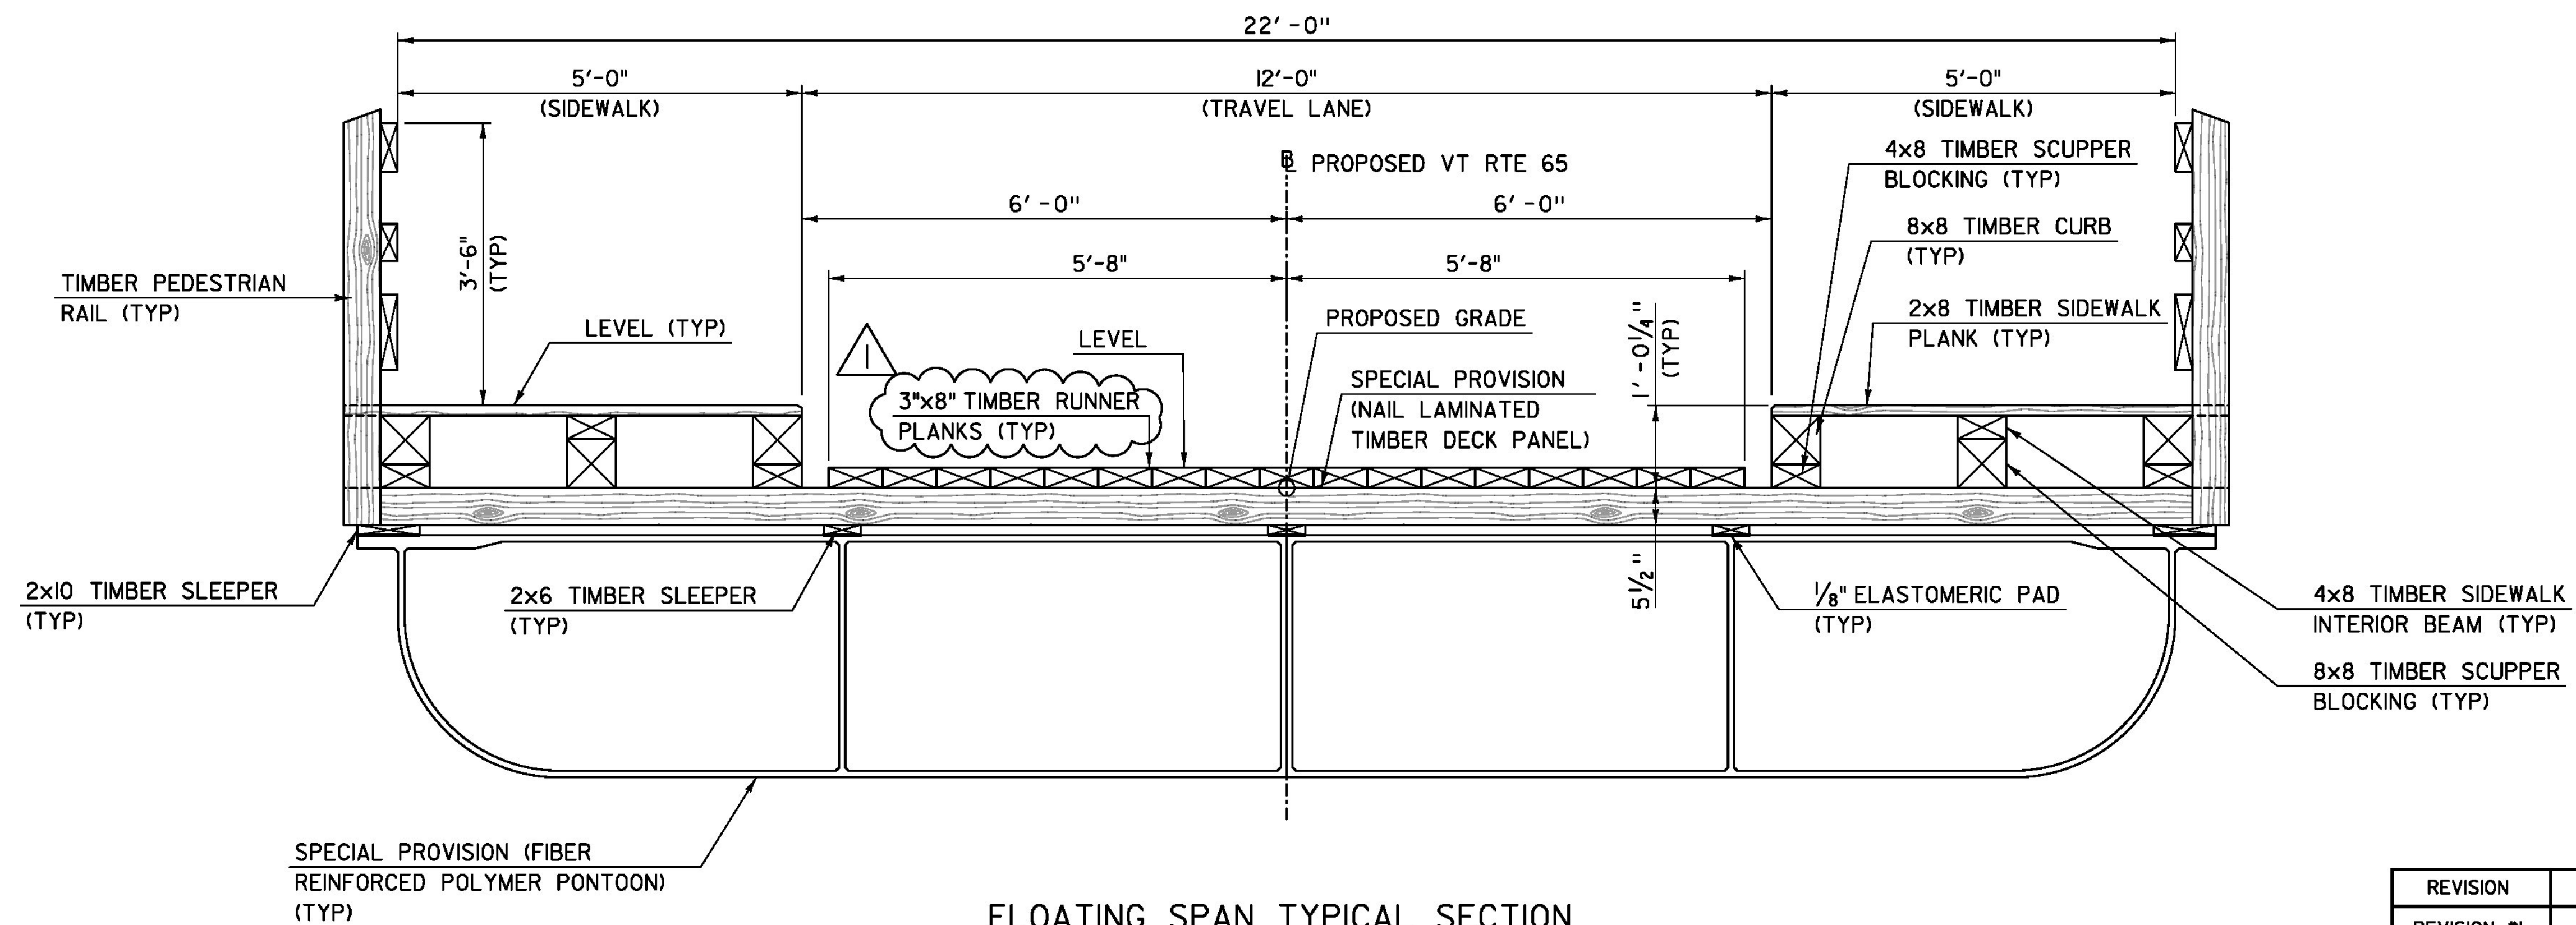

FLOATING SPAN TYPICAL SECTION

SCALE: 3/4" = 1'-0"

REVISION	DESCRIPTION	DATE
REVISION #1	RUNNER PLANK THICKNESS CHANGE	2/4/2014

PROJECT NAME: BROOKFIELD
PROJECT NUMBER: BRF FLBR(2)

TYLIN INTERNATIONAL

FILE NAME: z12e134bdr_bridge_typ.dgn
PROJECT LEADER: J. OLUND
DESIGNED BY: T. POULIN
BRIDGE TYPICAL SECTIONS

PLOT DATE: 2/5/2014
DRAWN BY: S. MORGAN
CHECKED BY: J. OLUND
SHEET 4 OF 70