


DETECTABLE WARNING SURFACE
 STA. 10+98.70, 7.08' LT (CAST IRON)
 STA. 10+98.70, 7.80' RT (CAST IRON)
 STA. 14+43.22, 8.22' LT (CAST IRON)
 STA. 14+43.30, 7.08' RT (CAST IRON)

SPECIAL PROVISION (GRANITE BOLLARD)
 STA. 10+96.61, 6.69' LT
 STA. 10+96.61, 7.39' RT
 STA. 14+45.66, 7.95' LT
 STA. 14+45.66, 6.86' RT

LEGEND:
 SPECIAL PROVISION (AGGREGATE SURFACE COURSE, SIDEWALK/TRAIL)


PORTLAND CEMENT CONCRETE SIDEWALK, 5 INCH
 STA. 10+97.50, LT TO STA. 11+11.50, LT
 STA. 10+97.50, RT TO STA. 11+11.50, RT
 STA. 14+32.50, LT TO STA. 14+44.40, LT
 STA. 14+32.50, RT TO STA. 14+44.50, RT

SPECIAL PROVISION (AGGREGATE SURFACE COURSE, SIDEWALK/TRAIL)
 STA. 10+37.75, RT TO STA. 10+97.88, RT
 STA. 10+48.69, LT TO STA. 10+97.50, LT
 STA. 14+43.64, LT TO STA. 14+92.50, LT
 STA. 14+44.50, RT TO STA. 14+92.50, RT

VERTICAL GRANITE CURB*
 STA. 10+95, LT TO STA. 11+10, LT
 STA. 10+95, RT TO STA. 11+10, RT
 STA. 14+30, LT TO STA. 14+55, LT
 STA. 14+30, RT TO STA. 14+55, RT

* VERTICAL GRANITE CURB IS TALLER THAN STANDARD. SEE DETAILS ON ROADWAY TYPICAL SECTIONS.

LAYOUT

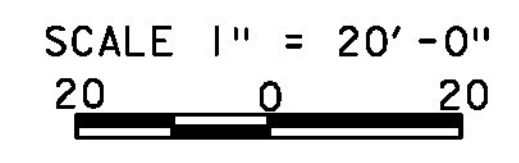

STEEL BACKED TIMBER GUARDRAIL
 STA. 10+07.68, RT TO STA. 11+12.00, RT
 STA. 10+60.13, LT TO STA. 11+12.00, LT
 STA. 14+32.00, RT TO STA. 14+63.85, RT
 STA. 14+32.00, LT TO STA. 14+56.45, LT

REMOVAL AND DISPOSAL OF GUARDRAIL
 STA. 10+10, RT TO STA. 11+10, RT
 STA. 10+55, LT TO STA. 11+10, LT
 STA. 14+30, LT TO STA. 14+50, LT
 STA. 14+30, RT TO STA. 14+70, RT

EXISTING BRIDGE DATA
 YEAR BUILT 1978
 TIMBER DECK ON PLASTIC FOAM FILLED FLOATS
 OVERALL LENGTH = 320 FT
 DECK WIDTH = 18 FT

TYL INTERNATIONAL

PROJECT NAME: BROOKFIELD
 PROJECT NUMBER: BRF FLBR(2)
 FILE NAME: z12e134bdr_nul.dgn
 PROJECT LEADER: J. OLUND
 DESIGNED BY: D. BURHANS
 LAYOUT SHEET
 PLOT DATE: 12/3/2013
 DRAWN BY: D. BURHANS
 CHECKED BY: D. BRYANT
 SHEET 14 OF 70