


**ABUTMENT 2 - REINFORCEMENT**  
SCALE: 3/8" = 1'-0"

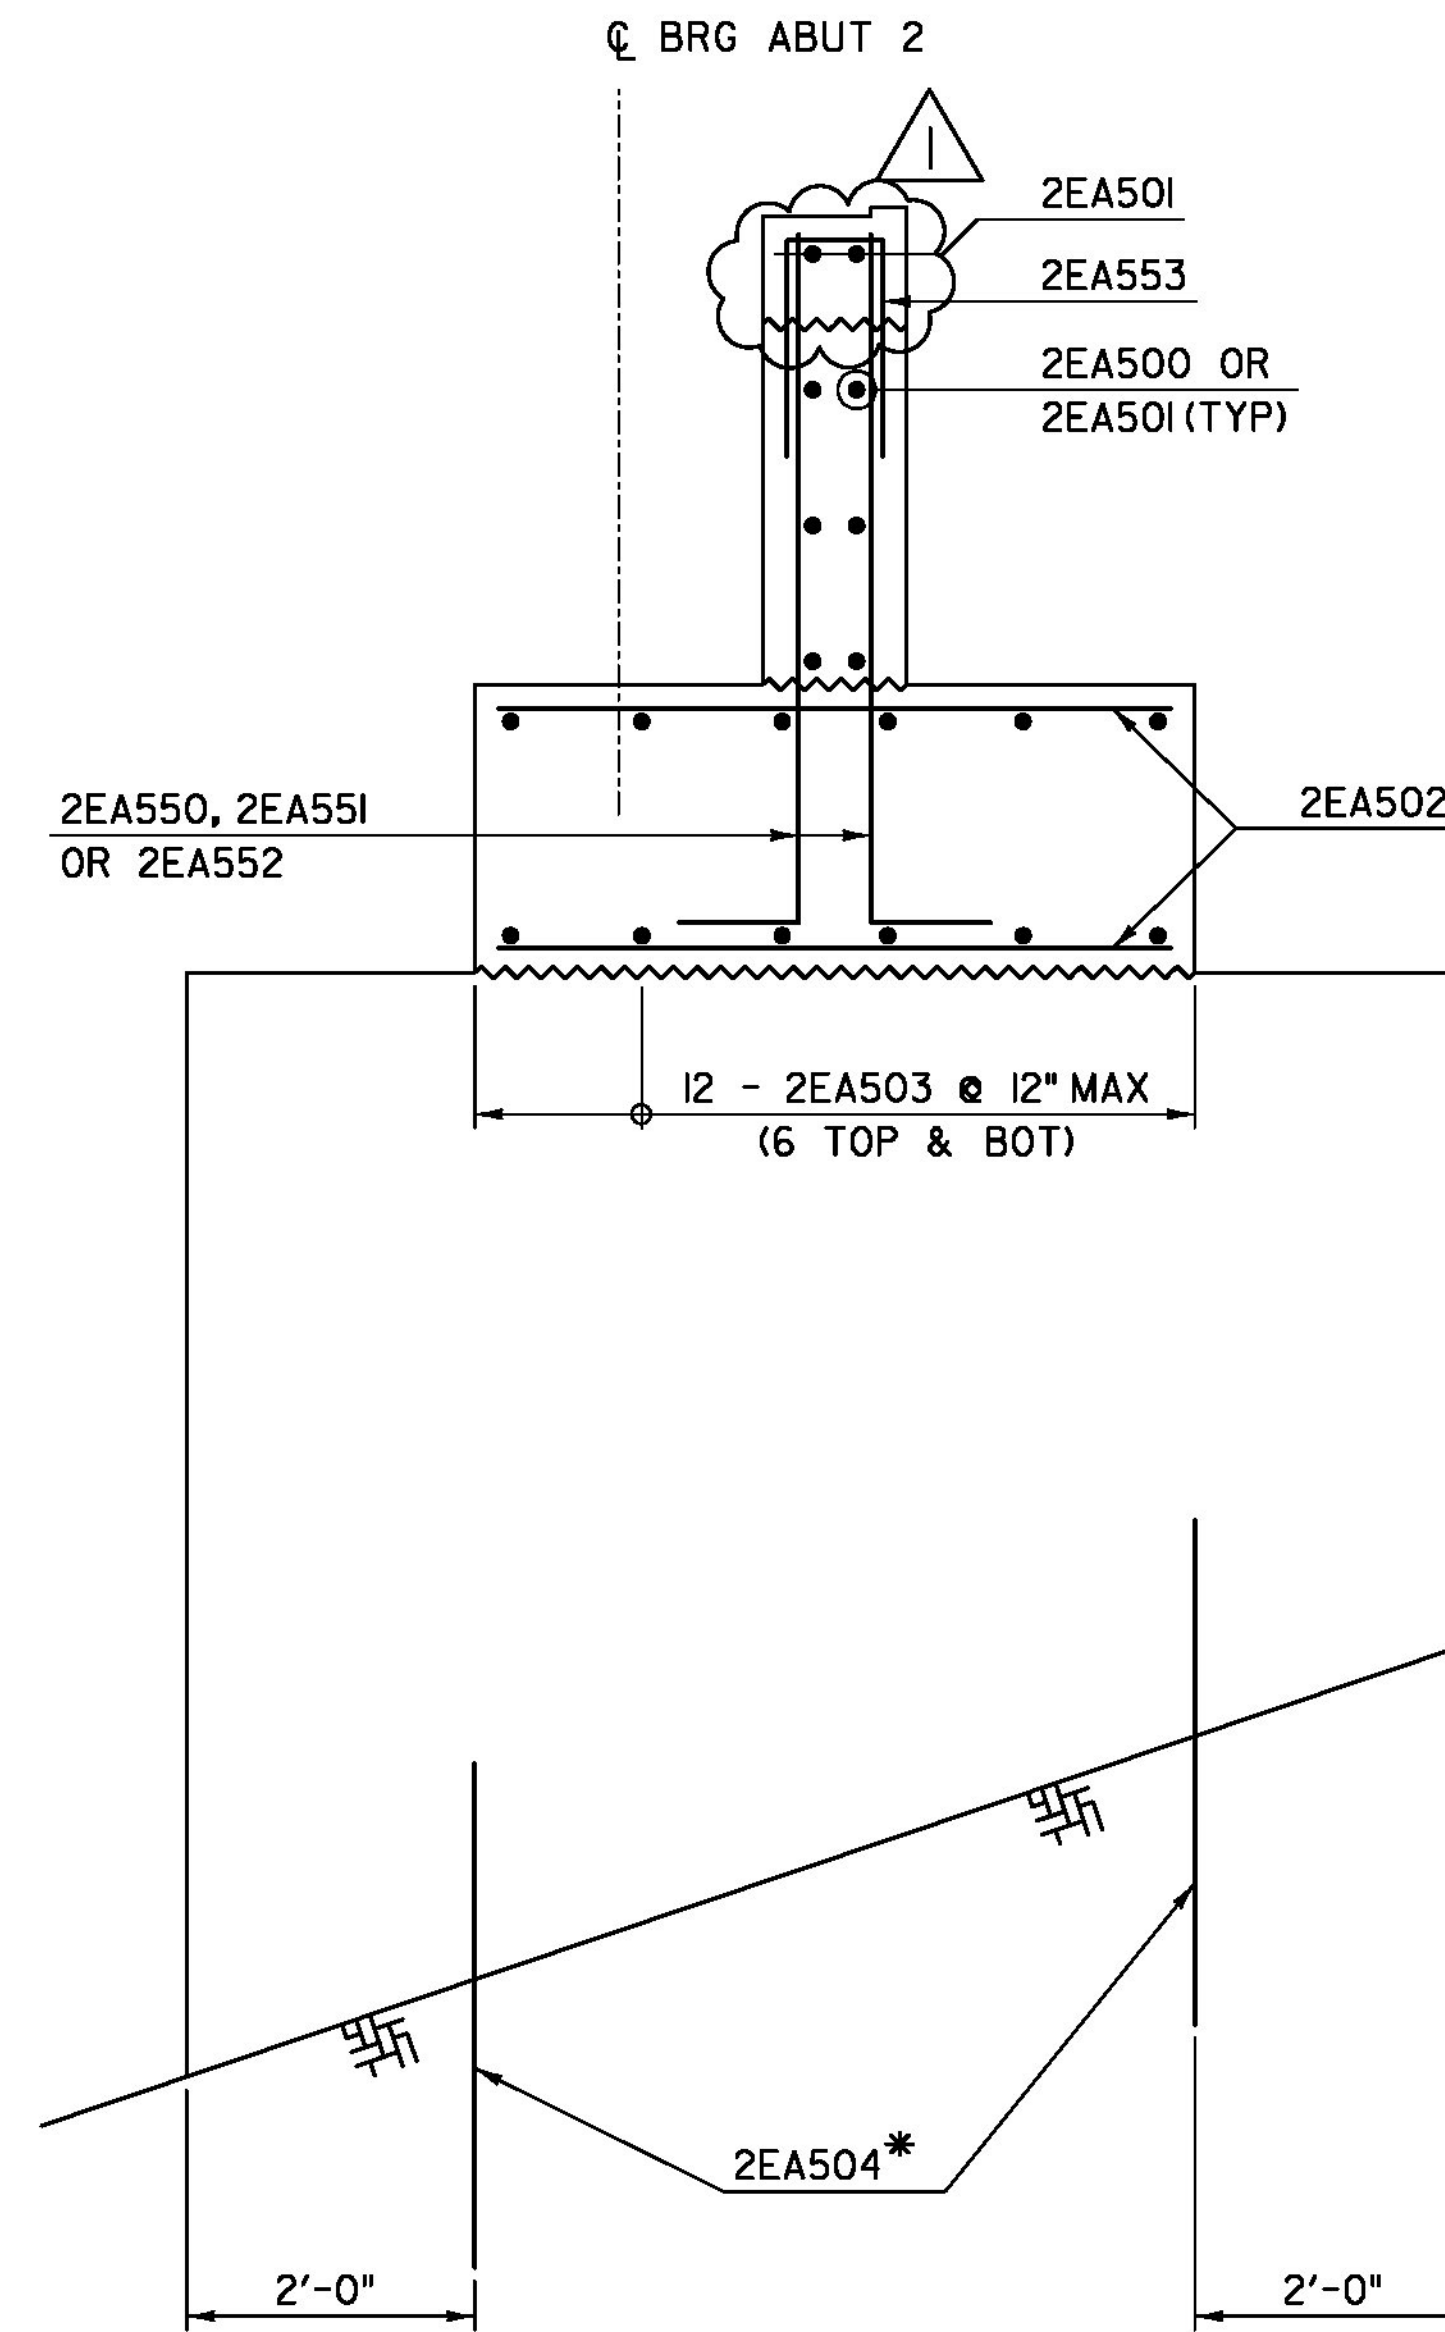

**SECTION A-A**  
SCALE: 3/4" = 1'-0"

\*2EA504 BARS SHALL BE DRILLED AND GROUTED INTO BEDROCK AS SHOWN HERE AND NOTED IN THE PROJECT NOTES.

REVISION	DESCRIPTION	DATE
REVISION #1	ADDED CONSTRUCTION JOINT	2/4/2014

PROJECT NAME: BROOKFIELD  
PROJECT NUMBER: BRF FLBR(2)

**TYL** INTERNATIONAL

FILE NAME: z12e134bdrabut2r.dgn  
PROJECT LEADER: J. OLUND  
DESIGNED BY: T. POULIN  
ABUTMENT 2 REINFORCEMENT

PLOT DATE: 2/5/2014  
DRAWN BY: S. MORGAN  
CHECKED BY: S. KELLER  
SHEET 57 OF 70