



10+50

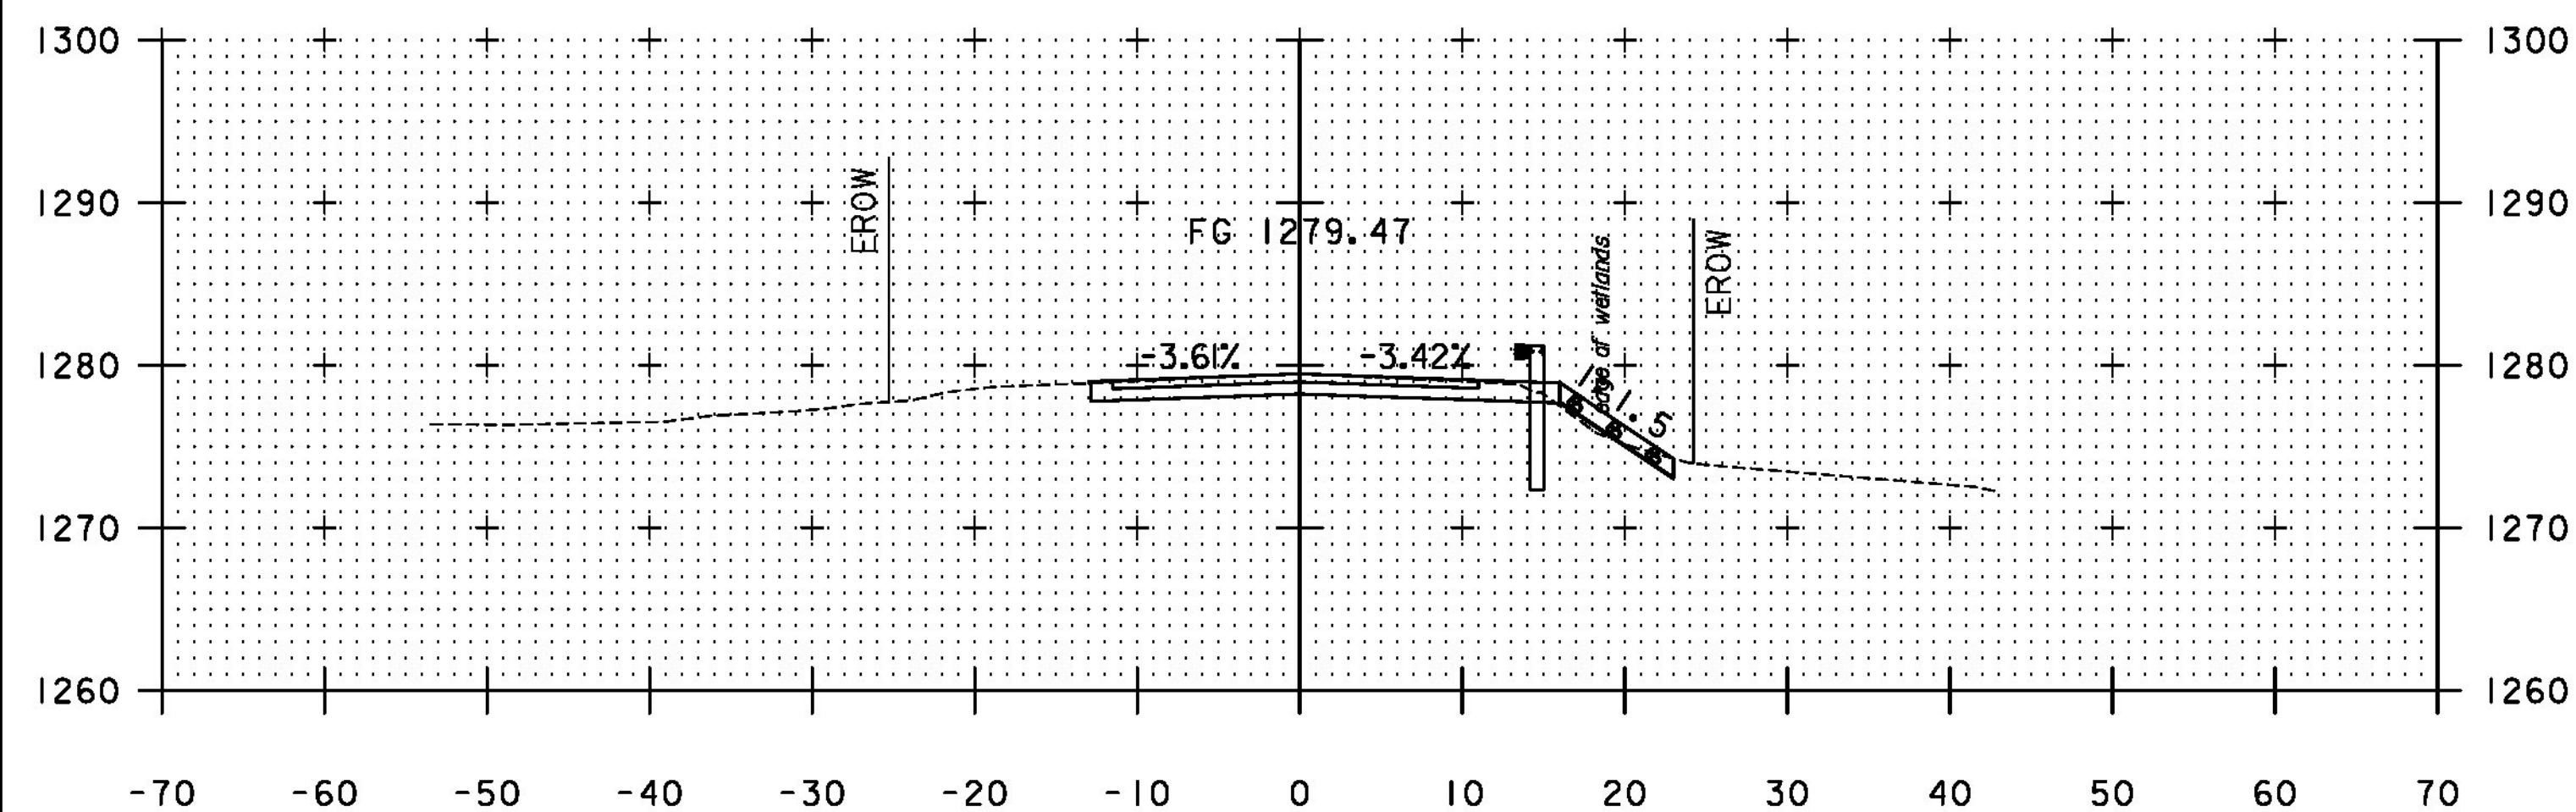


10+25

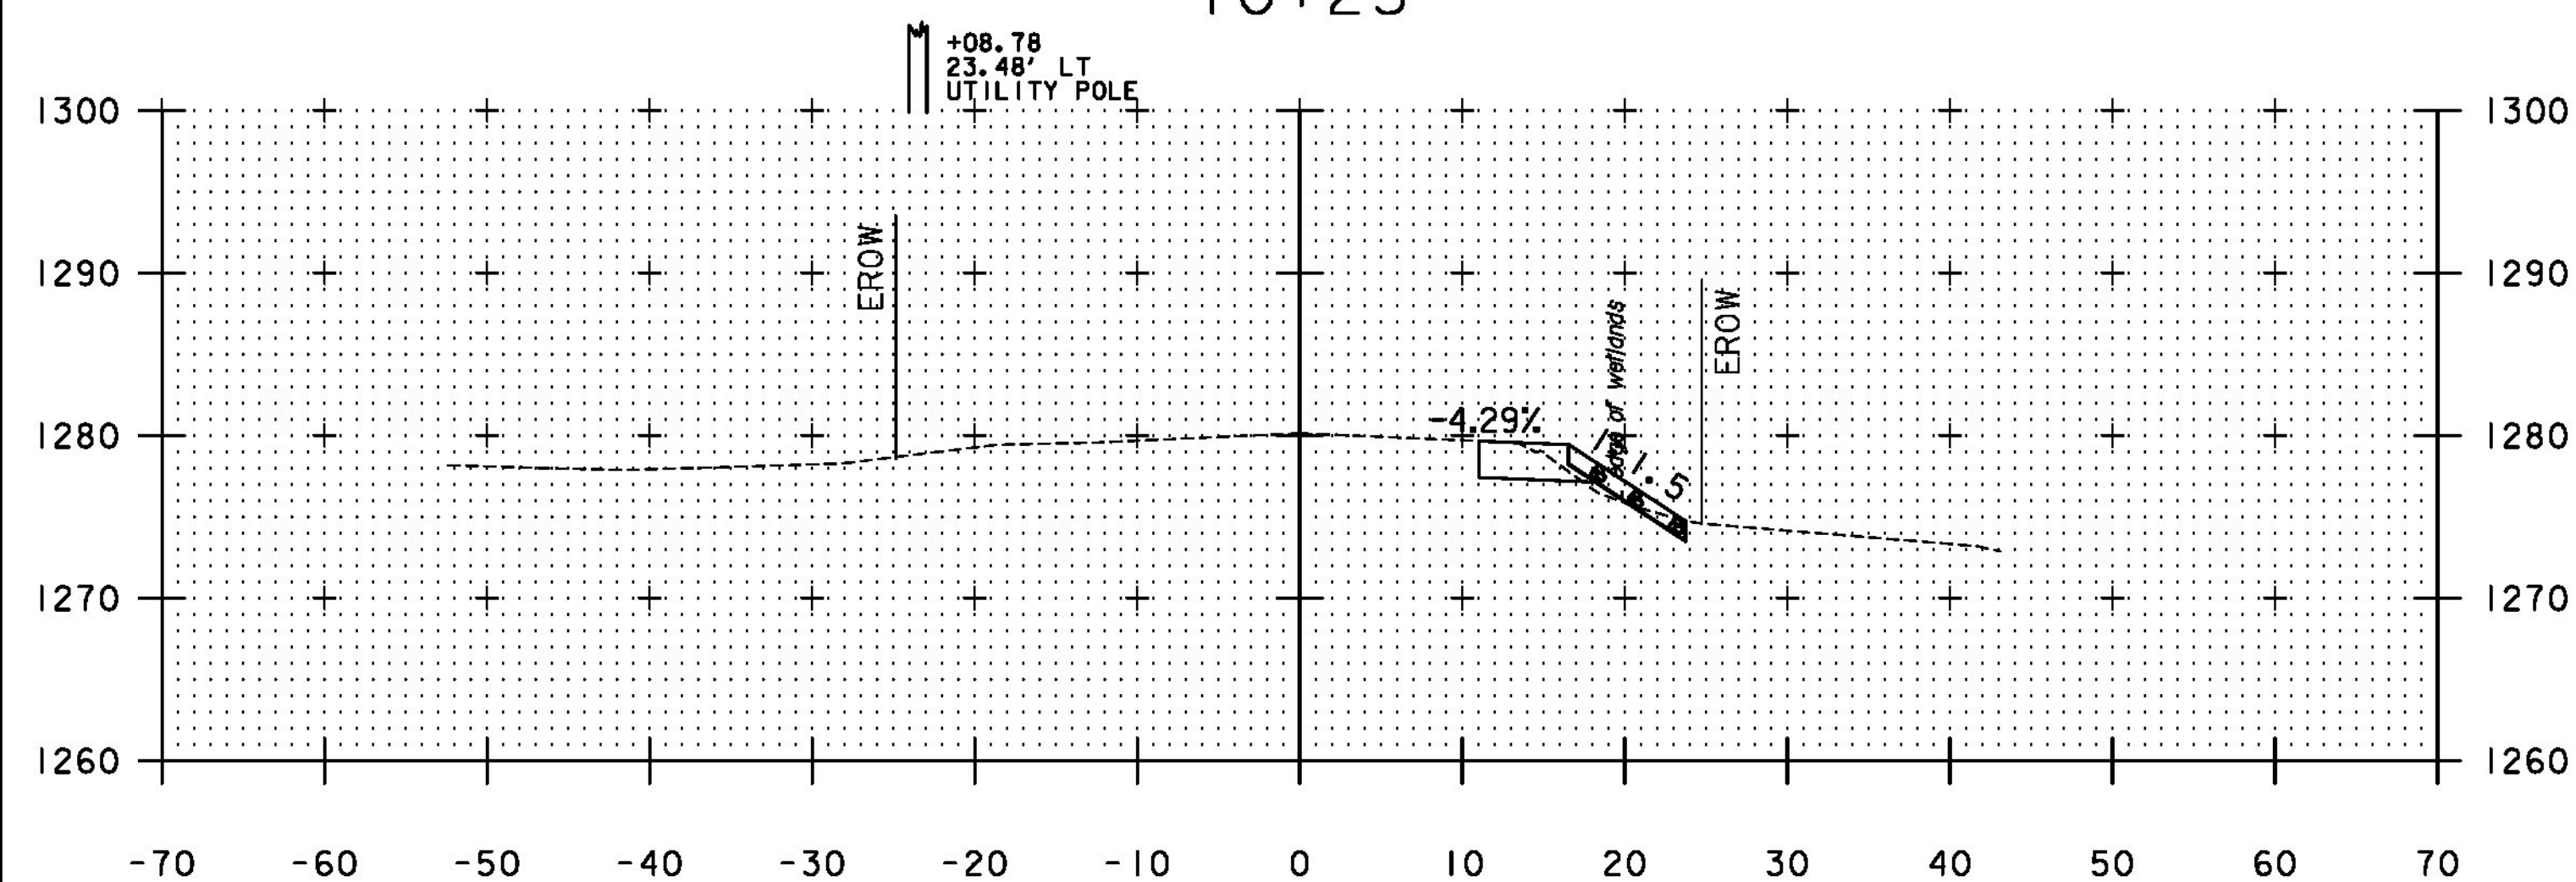


10+03.06

STA 10+03.06  
MATCH EXISTING PAVEMENT  
BEGIN APPROACH

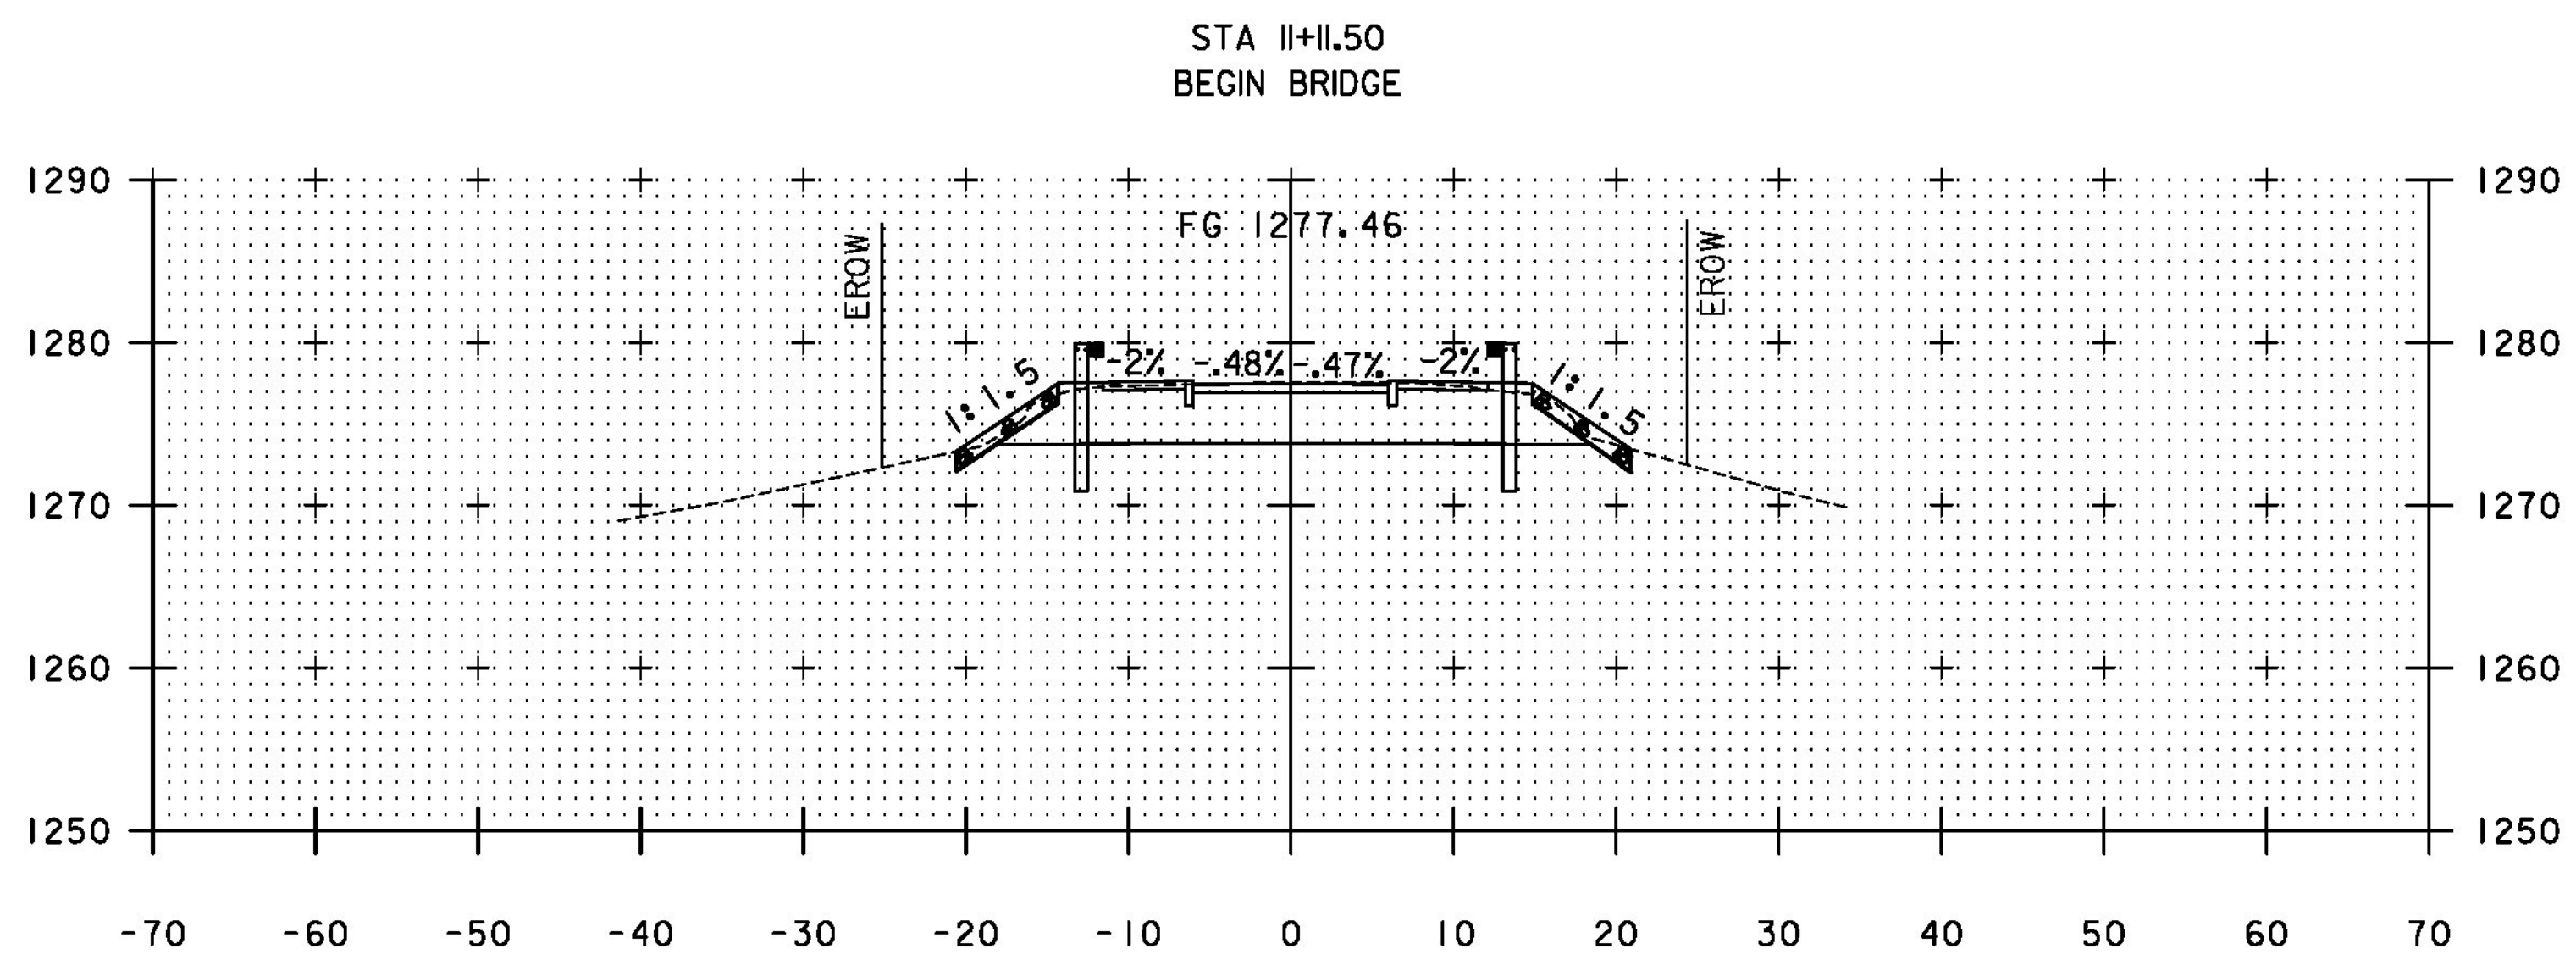

11+00

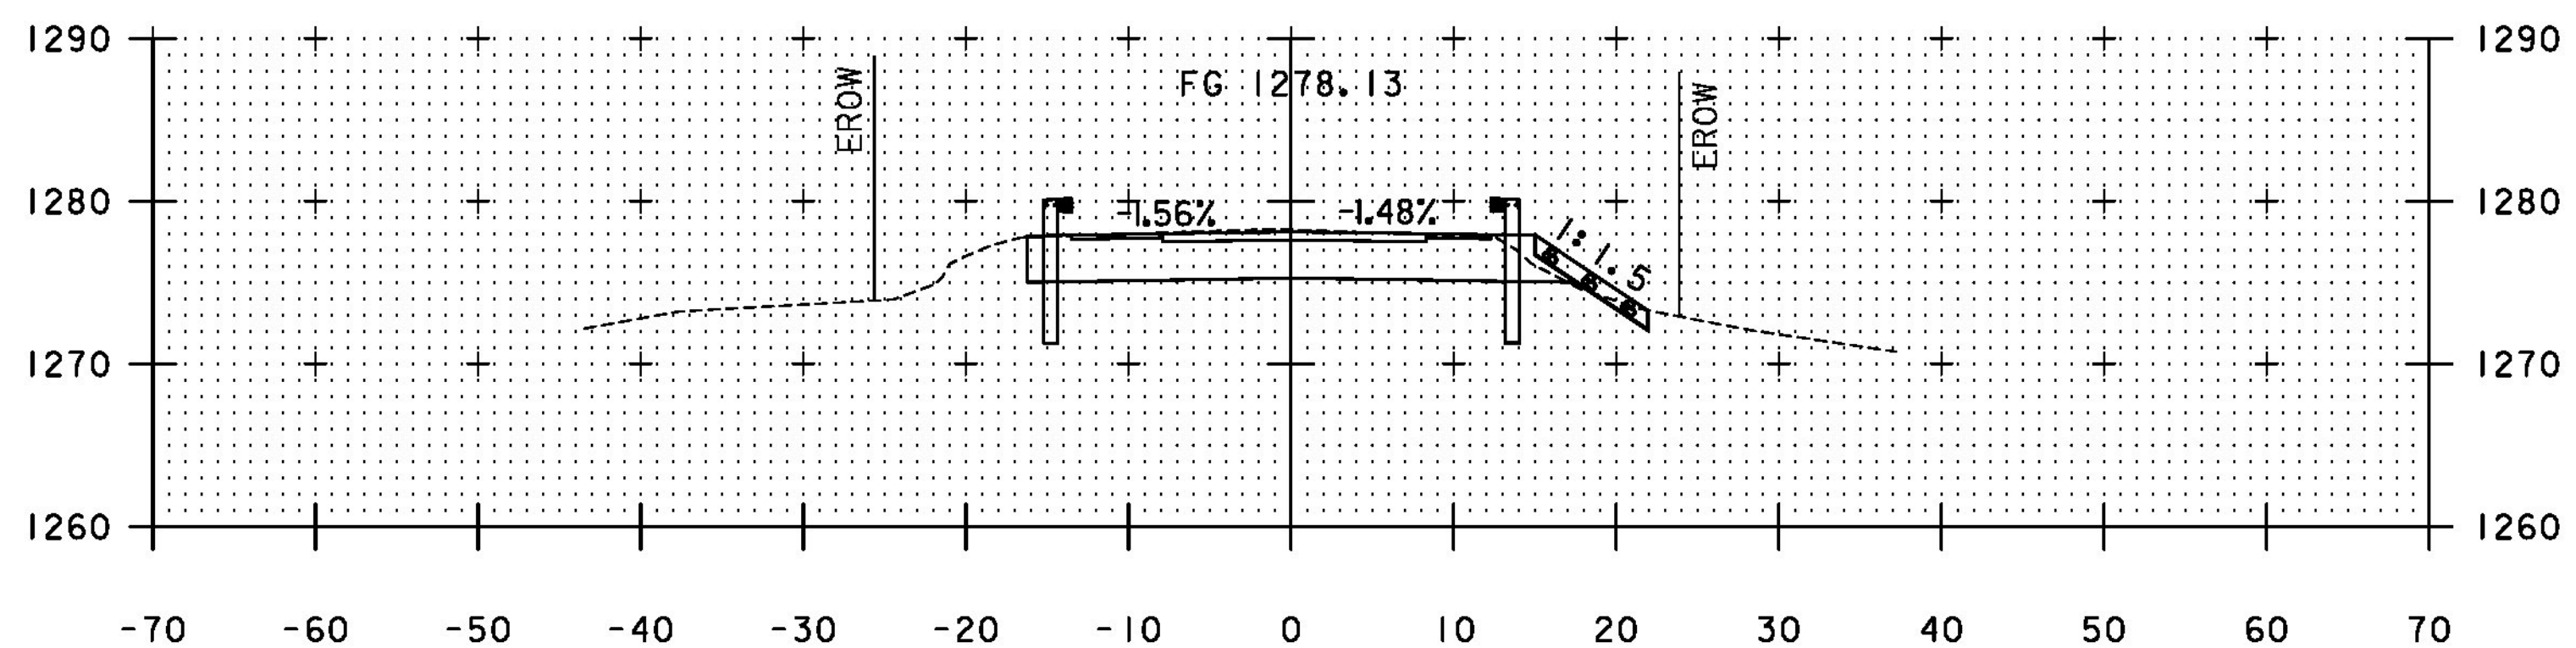

10+75

STA 10+55.94  
END APPROACH  
BEGIN PROJECT

STA 10+03.06 TO STA 11+00

TYLINTERNATIONAL

PROJECT NAME: BROOKFIELD  
PROJECT NUMBER: BRF FLBR(2)

FILE NAME: z12e134bdr\_xs.dgn  
PROJECT LEADER: J. OLUND  
DESIGNED BY: D. BURHANS  
ROADWAY CROSS SECTIONS I

PLOT DATE: 12/3/2013  
DRAWN BY: D. BURHANS  
CHECKED BY: D. BRYANT  
SHEET 59 OF 70